


BENCHMARK - N RIM SAS M.H. - 624.94
INV. - 611.82

SITE PLAN
FOR
R.C. REED CONSTRUCTION

BEING SUBLOT 3 IN THE MISTY MEADOWS
SUBDIVISION IN THE TOWNSHIP OF
PAINESVILLE, COUNTY OF LAKE, STATE OF
OHIO.



EXIST
PROF

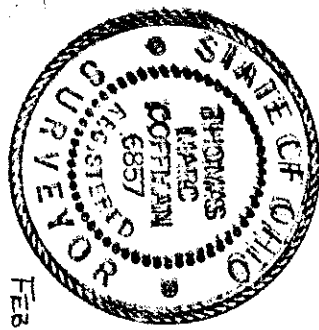


This Permit Expires
2/19/93
PAINESVILLE TOWNSHIP
ZONING APPROVED
0330
Zoning Inspector

I, the undersigned hereby certify that
this topography, indicated by 1' contours,
and elevations shown hereon represent an
actual field survey made by me on FEB. 10, 1992
and that the elevations were taken at
appropriate intervals and that as of that
date they existed as indicated hereon.

J.M. Coffman
No. 6857

VILLAGE SURVEYING CO.
202 THIRD STREET FAIRPORT HARBOR OHIO 44027
(216) 357-1359

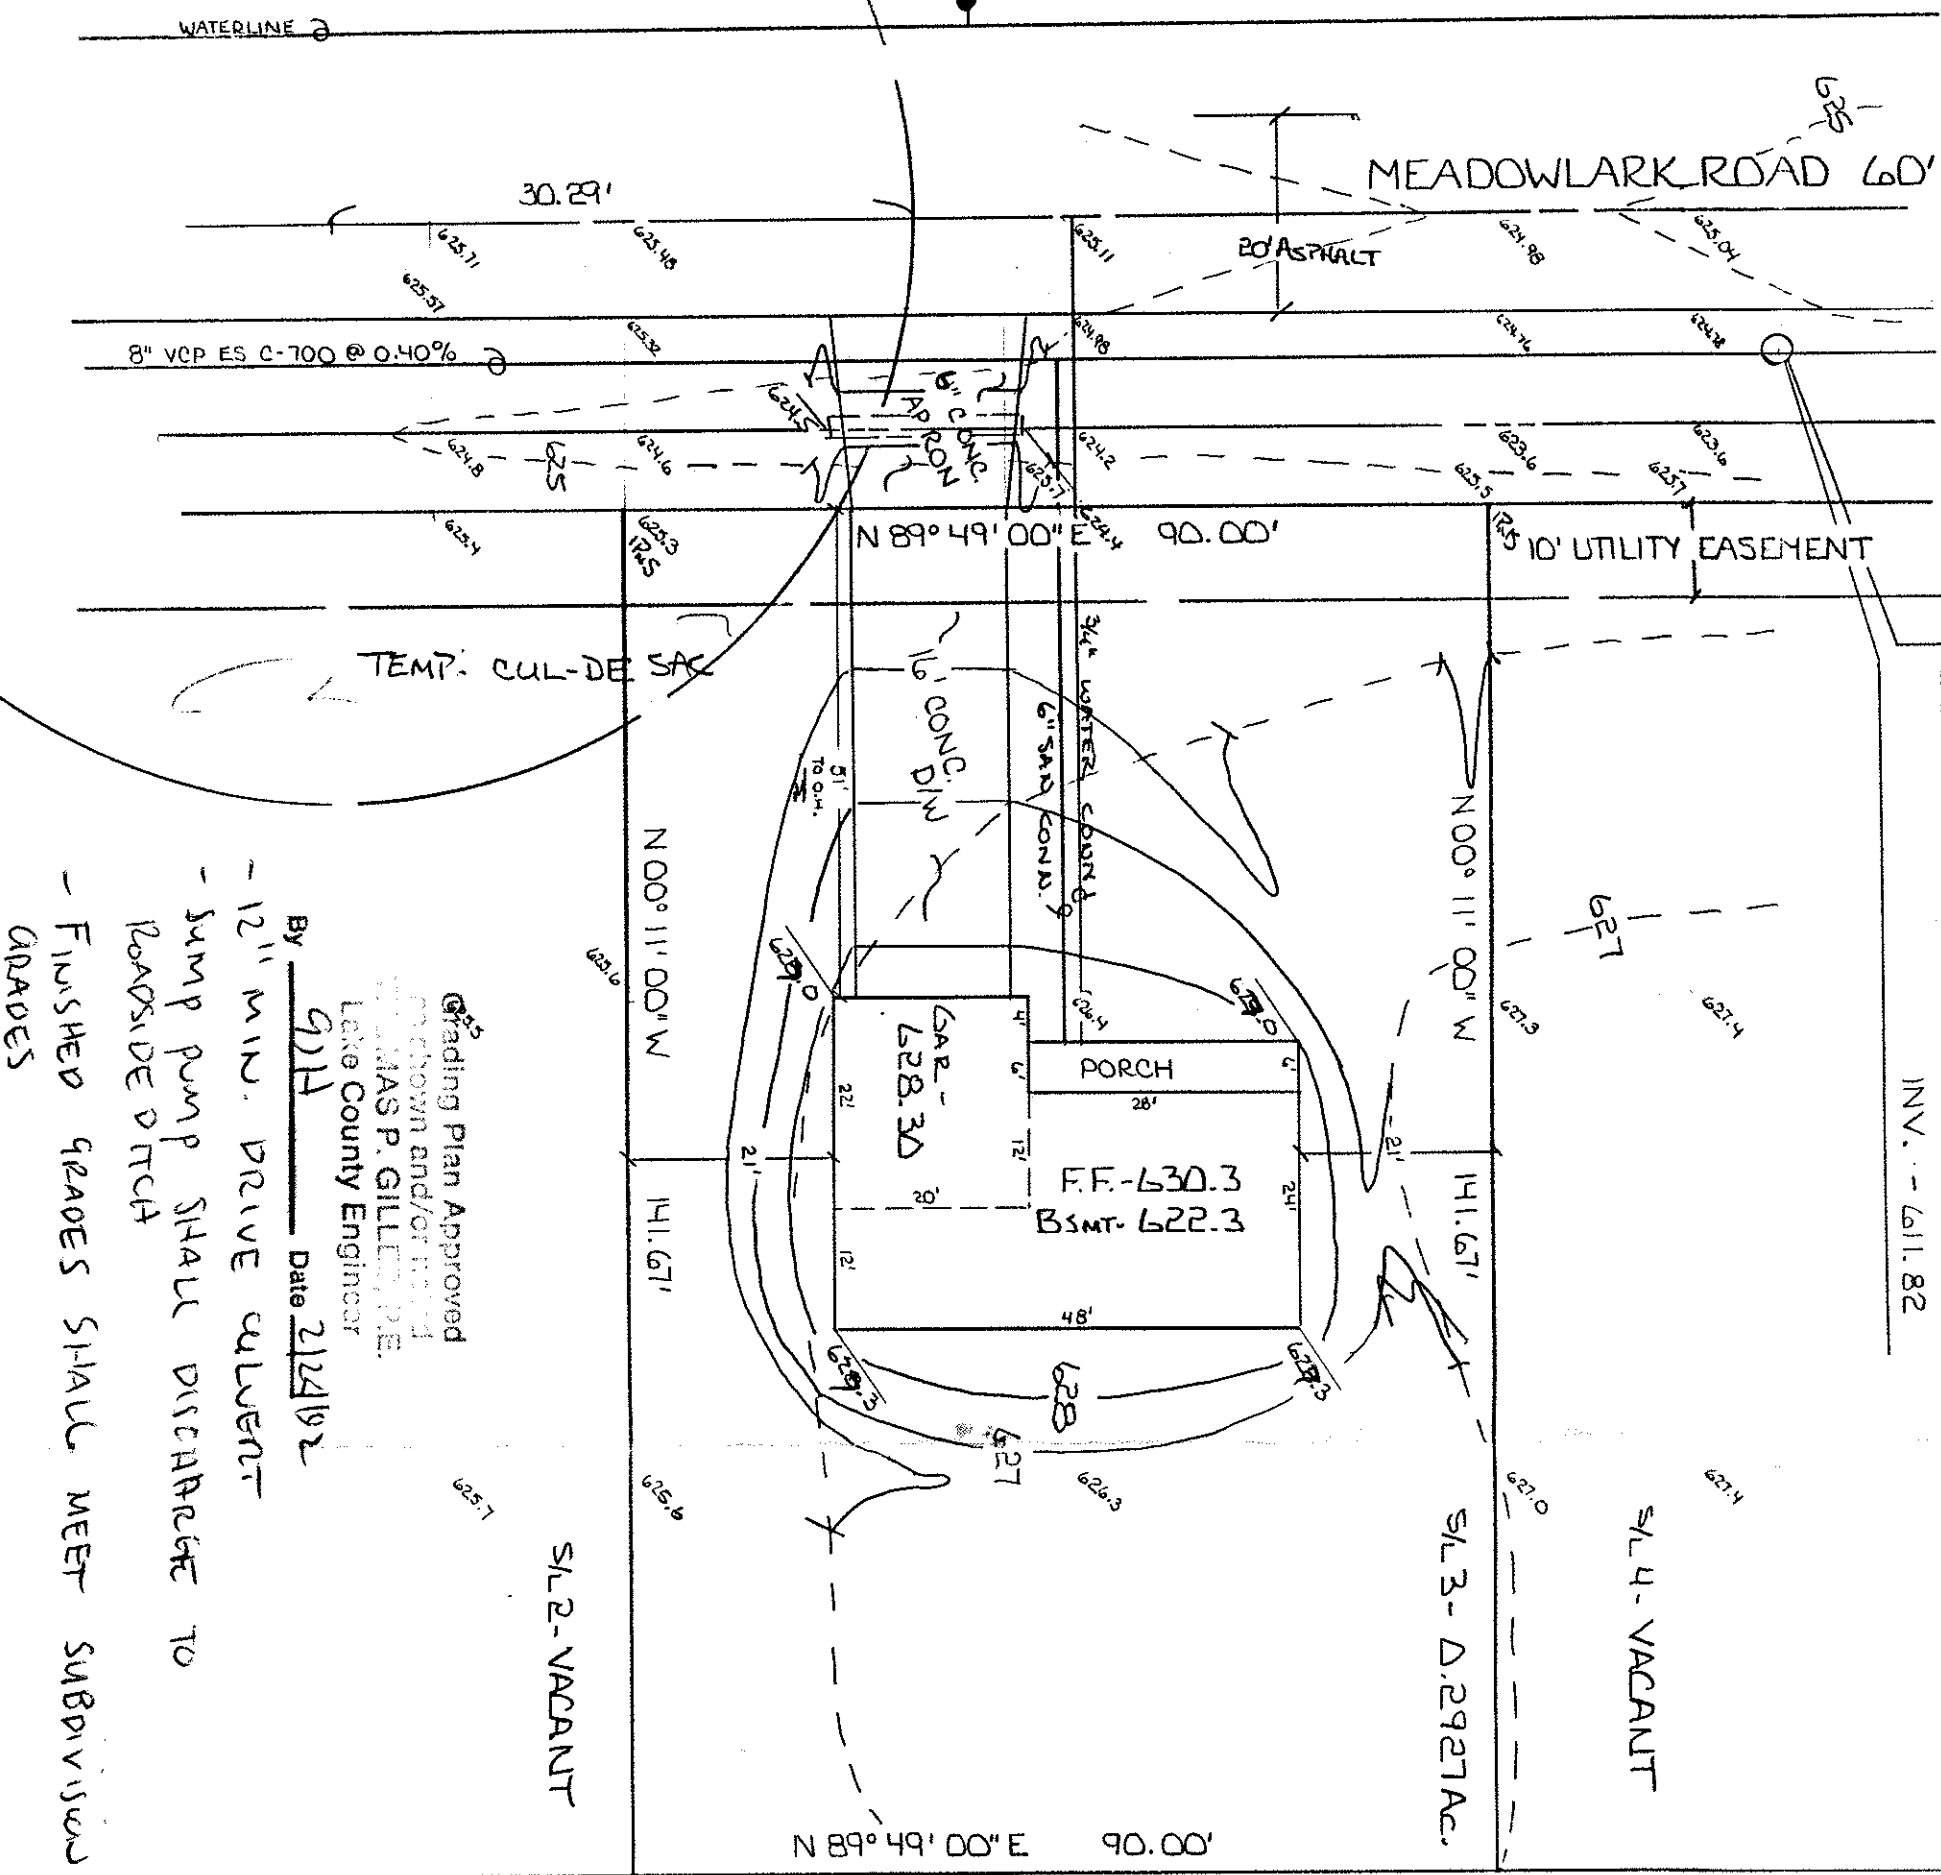

Grading Plan Approved
by Thomas P. Gillette, P.E.
Lake County Engineer
By 924 Date 2/24/92
- 12\"/>