

SITE PLAN

for : Joe Kayza CLIENT
10379 Prouty Road ADDRESS STREET Concord CITY
5.67.8 Blk109 G.F. Meigs Resurvey SUBLOT No. SUBDIVISION NAME VOL. A PAGE 37
19 to 23.4 Painesville LOT TRACT TOWNSHIP OHIO

LAND DESIGN consultants
Civil Engineers and Surveyors
8585 EAST AVENUE • MENTOR, OHIO 44060
TELEPHONE 255-6463 354-6938 951-LAND


DESIGN CERTIFICATION

THIS PLAT WAS PREPARED BY ME, AND IS CORRECT TO THE BEST OF MY KNOWLEDGE AND BELIEF.

Joe Kayza NAME
4-2-04

CHECK LIST

LOT DIMENSIONS & BEARINGS
TO NEAREST STREET
SUBLOT No. (PARCEL No.)
SURROUNDING OWNERS
BUILDING DIMENSIONS
DRAINAGE
SEWER
WATER
GAS
ELECTRIC
STORM
PAVING
CURBS
GAS LINE LOC. SIZE
SEPTIC SYSTEM & DUPLICATION
WELL LOCATION & ISOLATION RADIUS

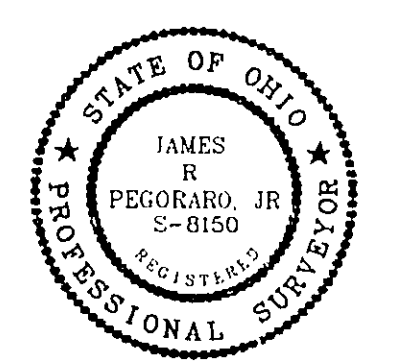

"AS BUILT" CERTIFICATION
I HEREBY CERTIFY THAT THE CIRCLED INFORMATION IS EXISTING AS OBTAINED ON THE SITE March 1994 AND IS CORRECT TO THE BEST OF MY KNOWLEDGE AND BELIEF.


LEGEND		DRAWN BY		SCALE	
STORM MANHOLE SANITARY MANHOLE EXISTING CONTOURS PROPOSED CONTOURS		SAS		1"=20'	
EAST. ELEV. 100.0 100.0 PROP. ELEV.		CHK'D BY		DATE	
1		JRP		3/31/2004	
2		Site/Grde 4/02/04			
DIRECTION OF SURFACE DRAINAGE					
ACCEPTED:		CLIENT		DATE	

BENCHMARK INVERT OF SAN. MH. AT MORRELL AVE AND MEIGS AVE ELEV. 598.75

Stormwater Management Plan
Approved as shown and/or noted
JAMES R. GILLS, P.E.
County Drainage Engineer
By 6/12 Date 04/06/04

Subject to approval by:
Zoning Department
Local Health District
Local Soil & Water Conservation District
Local Building Department (final approval)

DWG. NAME
Kayzi 0401

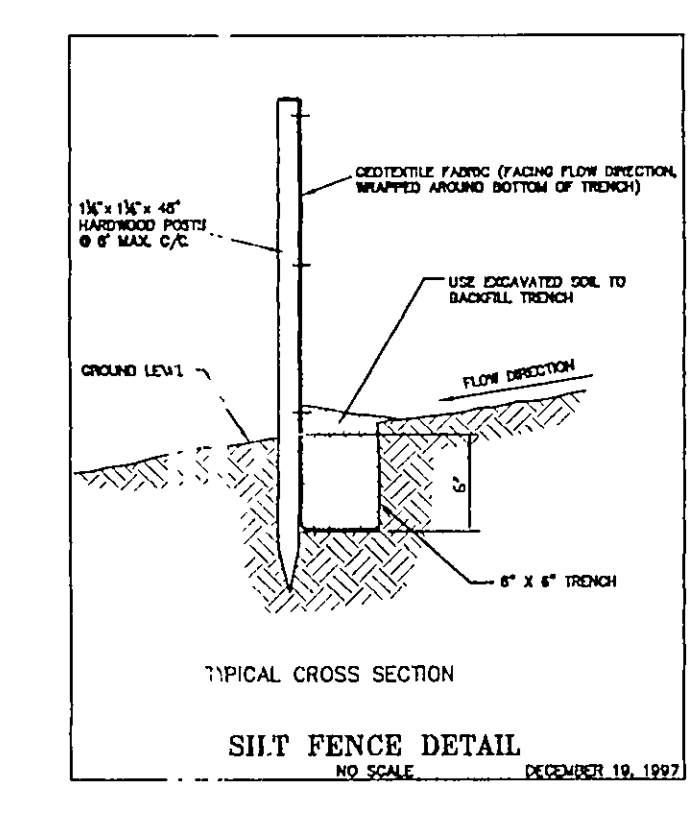


SILT FENCE. This sediment barrier utilizes standard strength or extra strength synthetic material designed for situations in which only sheet or overland flows are expected. See also 1. The height of a silt fence shall not exceed 18 inches. Higher fences may impound water sufficient to cause failure of the structure. 2. The filter fabric shall be purchased in a roll and cut out to the length of the barrier and the use of splices shall be avoided. When joints are necessary, filter cloth shall be spliced together with a support post, with a maximum of 10 feet apart at the barrier location and driven securely into the ground (minimum of 12 inches) when extra strength fabric is used without the wire support fence. Post supports shall not exceed 6 feet. 3. A trench shall be excavated approximately 1 inch wide and 4 inches deep along the posts and upstream from the barrier. 4. When standard strength filter fabric is used, a wire mesh support fence shall be fastened to the upstream side of the posts using heavy duty wire staples and 1/2 inch long 1/4 inch rings. The wire shall extend into the trench a minimum of 2 inches and shall not extend into the original ground surface. Filter fabric shall not be exposed to the existing ground. 5. The standard strength filter fabric shall be stapled or wired to the fence, and 8 inch fabric shall be extended into the trench. The fabric shall not exceed more than 30 inch from the original ground surface. Filter fabric shall not be exposed to the existing ground. 6. When extra strength filter fabric and closer post spacing are used the wire mesh support may be eliminated in such case the filter fabric is stapled or wired directly to the posts. Other provisions of item No. 6 apply. 7. The trench shall be backfilled and soil compacted over the filter fabric. 8. Silt fences shall be removed when they have served their useful purpose, but not before the upstream area has been permanently stabilized. MAINTENANCE 1. Silt fences and filter barriers shall be inspected immediately after each rainfall and if during prolonged rainfall. Any required repair shall be made immediately. 2. Should the fabric on a silt fence filter barrier decompose or become ineffective prior to the end of the expected useful life and the barrier is still necessary, the fabric shall be repaired or replaced. 3. Sediment deposits should be removed after each storm event. They must be removed to a depth of approximately one-half the height of the barrier. 4. Any sediment deposits remaining in place after the silt fence or filter barrier is no longer required shall be dressed to conform with the existing grade, prepared and seeded. SILT FENCE NO. SCALE: 1/8"=1'-0" DATE: 10-20-93

THE CONTRACTOR/BUILDER SHALL NOTIFY THE APPROVING ENGINEER IF GROUNDWATER IS OBSERVED DURING THE EXCAVATION OF THE BASEMENT.
Contractor To Verify Depth And Location Of Utility Connections;
See Architect Plans For Complete House Dimensions.

EROSION CONTROL PLAN & SCHEDULE
SILT FENCE TO BE INSTALLED PRIOR TO ANY EARTHWORK ACTIVITY. LOCATION SHOWN ON PLANS OR DETAIL.
STONE SHALL BE INSTALLED FUTURE DRIVEWAY AREA 20 FEET WIDE AND 50 FEET LONG TO PREVENT EROSION FROM TRACKING SEDIMENT OFF THIS SITE. INGRESS AND EGRESS SHALL BE LIMITED TO THIS AREA ONLY.
SEEDING AND MULCHING SHALL BE FUNCTIONAL THROUGHOUT ALL PHASES OF EARTH DISTURBANCE. PRACTICES INTENDED TO TRAP SEDIMENT SHALL BE IMPLEMENTED AS THE FIRST STEP OF GRADING AND WITHIN SEVEN (7) DAYS FROM THE START OF GRUBBING. THEY SHALL CONTINUE TO FUNCTION UNTIL THE DISTURBED AREAS ARE PERMANENTLY RE-STABILIZED.
DISTURBED AREAS SHALL BE SOIL STABILIZATION WITHIN NO MORE THAN SEVEN (7) DAYS IF THEY ARE TO REMAIN DORMANT UNDISTURBED FOR MORE THAN THIRTY-FIVE (35) DAYS. PERMANENT OR TEMPORARY SOIL STABILIZATION SHALL BE USED TO DISTURBED AREAS WITHIN NO MORE THAN SEVEN (7) DAYS AFTER FINAL GRADE IS REACHED ON ANY PORTION OF THE SITE, AND SHALL ALSO BE APPLIED WITHIN NO MORE THAN SEVEN (7) DAYS TO DISTURBED AREAS WHICH MAY NOT BE AT FINAL GRADE BUT WILL REMAIN DORMANT FOR LONGER THAN THIRTY-FIVE (35) DAYS.
STABILIZATION OF CRITICAL AREAS WITHIN TWO (2) DAYS OF DISTURBANCE IF AREA WILL REMAIN INACTIVE FOR FOURTEEN (14) DAYS OR LONGER. UNSTABILIZED AREAS SHALL BE PROTECTED BY CONSTRUCTION VEHICLES REPEATEDLY DURING CONSTRUCTION, AND IMPROVED TEMPORARY STREAM CROSSING SHALL BE CONSTRUCTED.
SOIL STOCKPILES SHALL BE COVERED OR PROTECTED TO PREVENT EROSION. STABILIZATION SHALL BE USED IF STOCKPILES ARE LOCATED WITHIN CRITICAL AREAS NEAR STREAM OR WETLANDS, OR IF DETERMINED BY THE ADMINISTRATOR THAT SEDIMENT FROM STOCKPILES WILL LEAVE THE SITE.
SEEDING AND EROSION CONTROL SHALL BE INSPECTED BY THE COUNTY ENGINEER OR HIS/HER AGENT EVERY SEVEN (7) DAYS AND WITHIN 24 HOURS OF A RAINFALL EVENT. A WRITTEN REPORT OF THESE INSPECTIONS AND RECOMMENDATIONS TO CORRECT ANY PROBLEMS SHALL BE KEPT ON SITE. THESE INSPECTIONS SHALL INCLUDE THE DATE OF INSPECTION, NAME OF INSPECTOR, WEATHER CONDITIONS, ACTIONS TAKEN TO CORRECT ANY PROBLEMS, AND THE DATE ACTIONS WERE TAKEN.
MEASURES SHALL BE TAKEN TO PREVENT SOIL TRANSPORT UNTIL SURFACES WHERE RUNOFF IS NOT CHECKED BY SEDIMENT CONTROLS OR OTHER PUBLIC ROADS WHERE SOIL IS TRANSPORTED ONTO A PUBLIC ROAD SURFACE, THE ROADS SHALL BE CLEANED THOROUGHLY AT THE END OF EACH DAY OR MORE FREQUENTLY AS NECESSARY. SOIL SHALL BE REMOVED FROM PAVED SURFACES BY SHOVELING OR KEEPING STREET WASHING CHANNELS OPEN.
THE ABOVE SPECIFIED EROSION CONTROL STANDARDS ARE GENERAL GUIDELINES AND SHALL NOT BE AT THE RIGHT OF THE COUNTY TO IMPOSE, AT ANY TIME, ADDITIONAL, MORE STRINGENT REQUIREMENTS. NOR SHALL THE STANDARDS LIMIT THE RIGHT OF THE COUNTY TO WAIVE, IN WRITING, INDIVIDUAL REQUIREMENTS.
PERMANENT SEEDING TO BE INSTALLED AFTER ALL CONSTRUCTION ACTIVITY IS COMPLETE.
SEEDING AND MULCHING NOTES
SEEDING AND MULCHING SHALL BE ACCOMPANISHED BY SEEDING AND MULCHING IMMEDIATELY UPON COMPLETION OF EXCAVATION OF FILL AND FINISHED GRADING IN ACCORDANCE WITH ITEM NO. 659 OF THE SPECIFICATIONS AND MATERIAL SPECIFICATIONS OF THE COUNTY OF LAKE COUNTY.
THE FOLLOWING MIXTURE SHALL BE USED FOR SEEDING IN ACCORDANCE WITH ITEM 659:
KENTUCKY BLUE GRASS - 40%
CREEPING RED FESCUE - 40%
PERENNIAL RYEGRASS - 20%
FERTILIZER - 20#/1000 SF (12-12-12)
MULCH-STRAW/ 3 TONS/ACRE

LEGEND			
○ Clean Out	⊗ Water Valve	— Guide Wire	⊗ Tree
□ Catch Basin	⊗ Water Meter	— Power Pole	⊗ Pine Tree
□ Curb Inlet	⊗ Fire Hydrant	— Light Power Pole	⊗ Bush
○ Yard Drain	⊗ Well	— Light Pole	
○ Manhole	⊗ Gas Valve	— Traffic Signal Pole	
○ Sanitary Manhole	⊗ Gas Meter	— Traffic Signal Box	
○ Storm Manhole	⊗ Mailbox	— Electrical Box	
○ Storm Inlet MH	⊗ Guard Post	— Telephone (SAC) Box	
○ House/Down Spout	⊗ Sign		

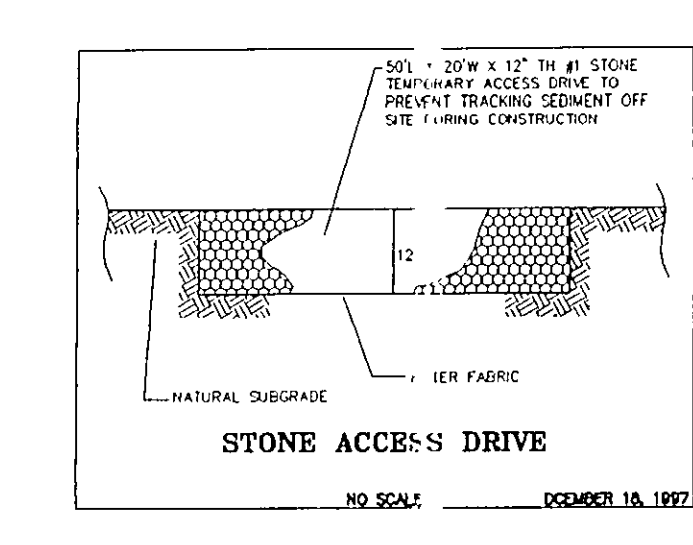

2 WORKING DAYS
BEFORE YOU DIG
CALL TOLL FREE 800-362-2764
OHIO UTILITIES PROTECTION SERVICE

EXISTING UNDERGROUND UTILITIES NOTE:
THE SIZE AND LOCATION BOTH HORIZONTAL AND VERTICAL OF THE UNDERGROUND UTILITIES SHOWN HEREON, HAVE BEEN OBTAINED BY A DILIGENT AND COMPREHENSIVE SEARCH OF AVAILABLE RECORDS. VERIFICATION BY FIELD OBSERVATION HAS BEEN CONDUCTED WHERE PRACTICAL. HOWEVER, UIC, INC. DOES NOT GUARANTEE THE COMPLETENESS NOR ACCURACY THEREOF.
GAS, WATER, AND SAN SEW LINES PLOTTED FROM LAKE COUNTY SEWERAGE IMPROVEMENT PLANS DATED OCT 1368