


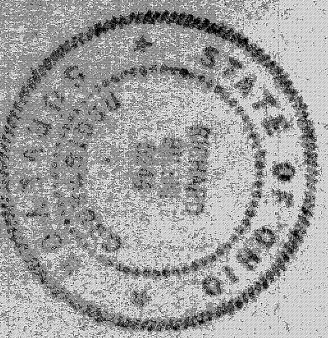

DESIGN CERTIFICATION
THIS PLAN WAS PREPARED BY ME
AND IS CORRECT TO THE BEST OF
MY KNOWLEDGE AND BELIEF.

AS BUILT CERTIFICATION
I HEREBY CERTIFY THAT THE CIRCLED GRADES
ARE EXISTING FINISH GRADES CHECKED IN THE
FIELD ON 1/22/85 AND THAT
THE SURVEY IS CORRECT TO THE BEST OF MY
KNOWLEDGE AND BELIEF.


* REVISED BLDG. LOCATION
AND PARKING SPACES.

RLS 1-24-85

DATE 4/5/84
SCALE 1"=20'
DRAWN BY [Signature]
CHECKED BY [Signature]

COLPETZER WOODS
CONSULTANTS, INC.
MENTOR, OHIO 44060

SHEET 1 OF 1

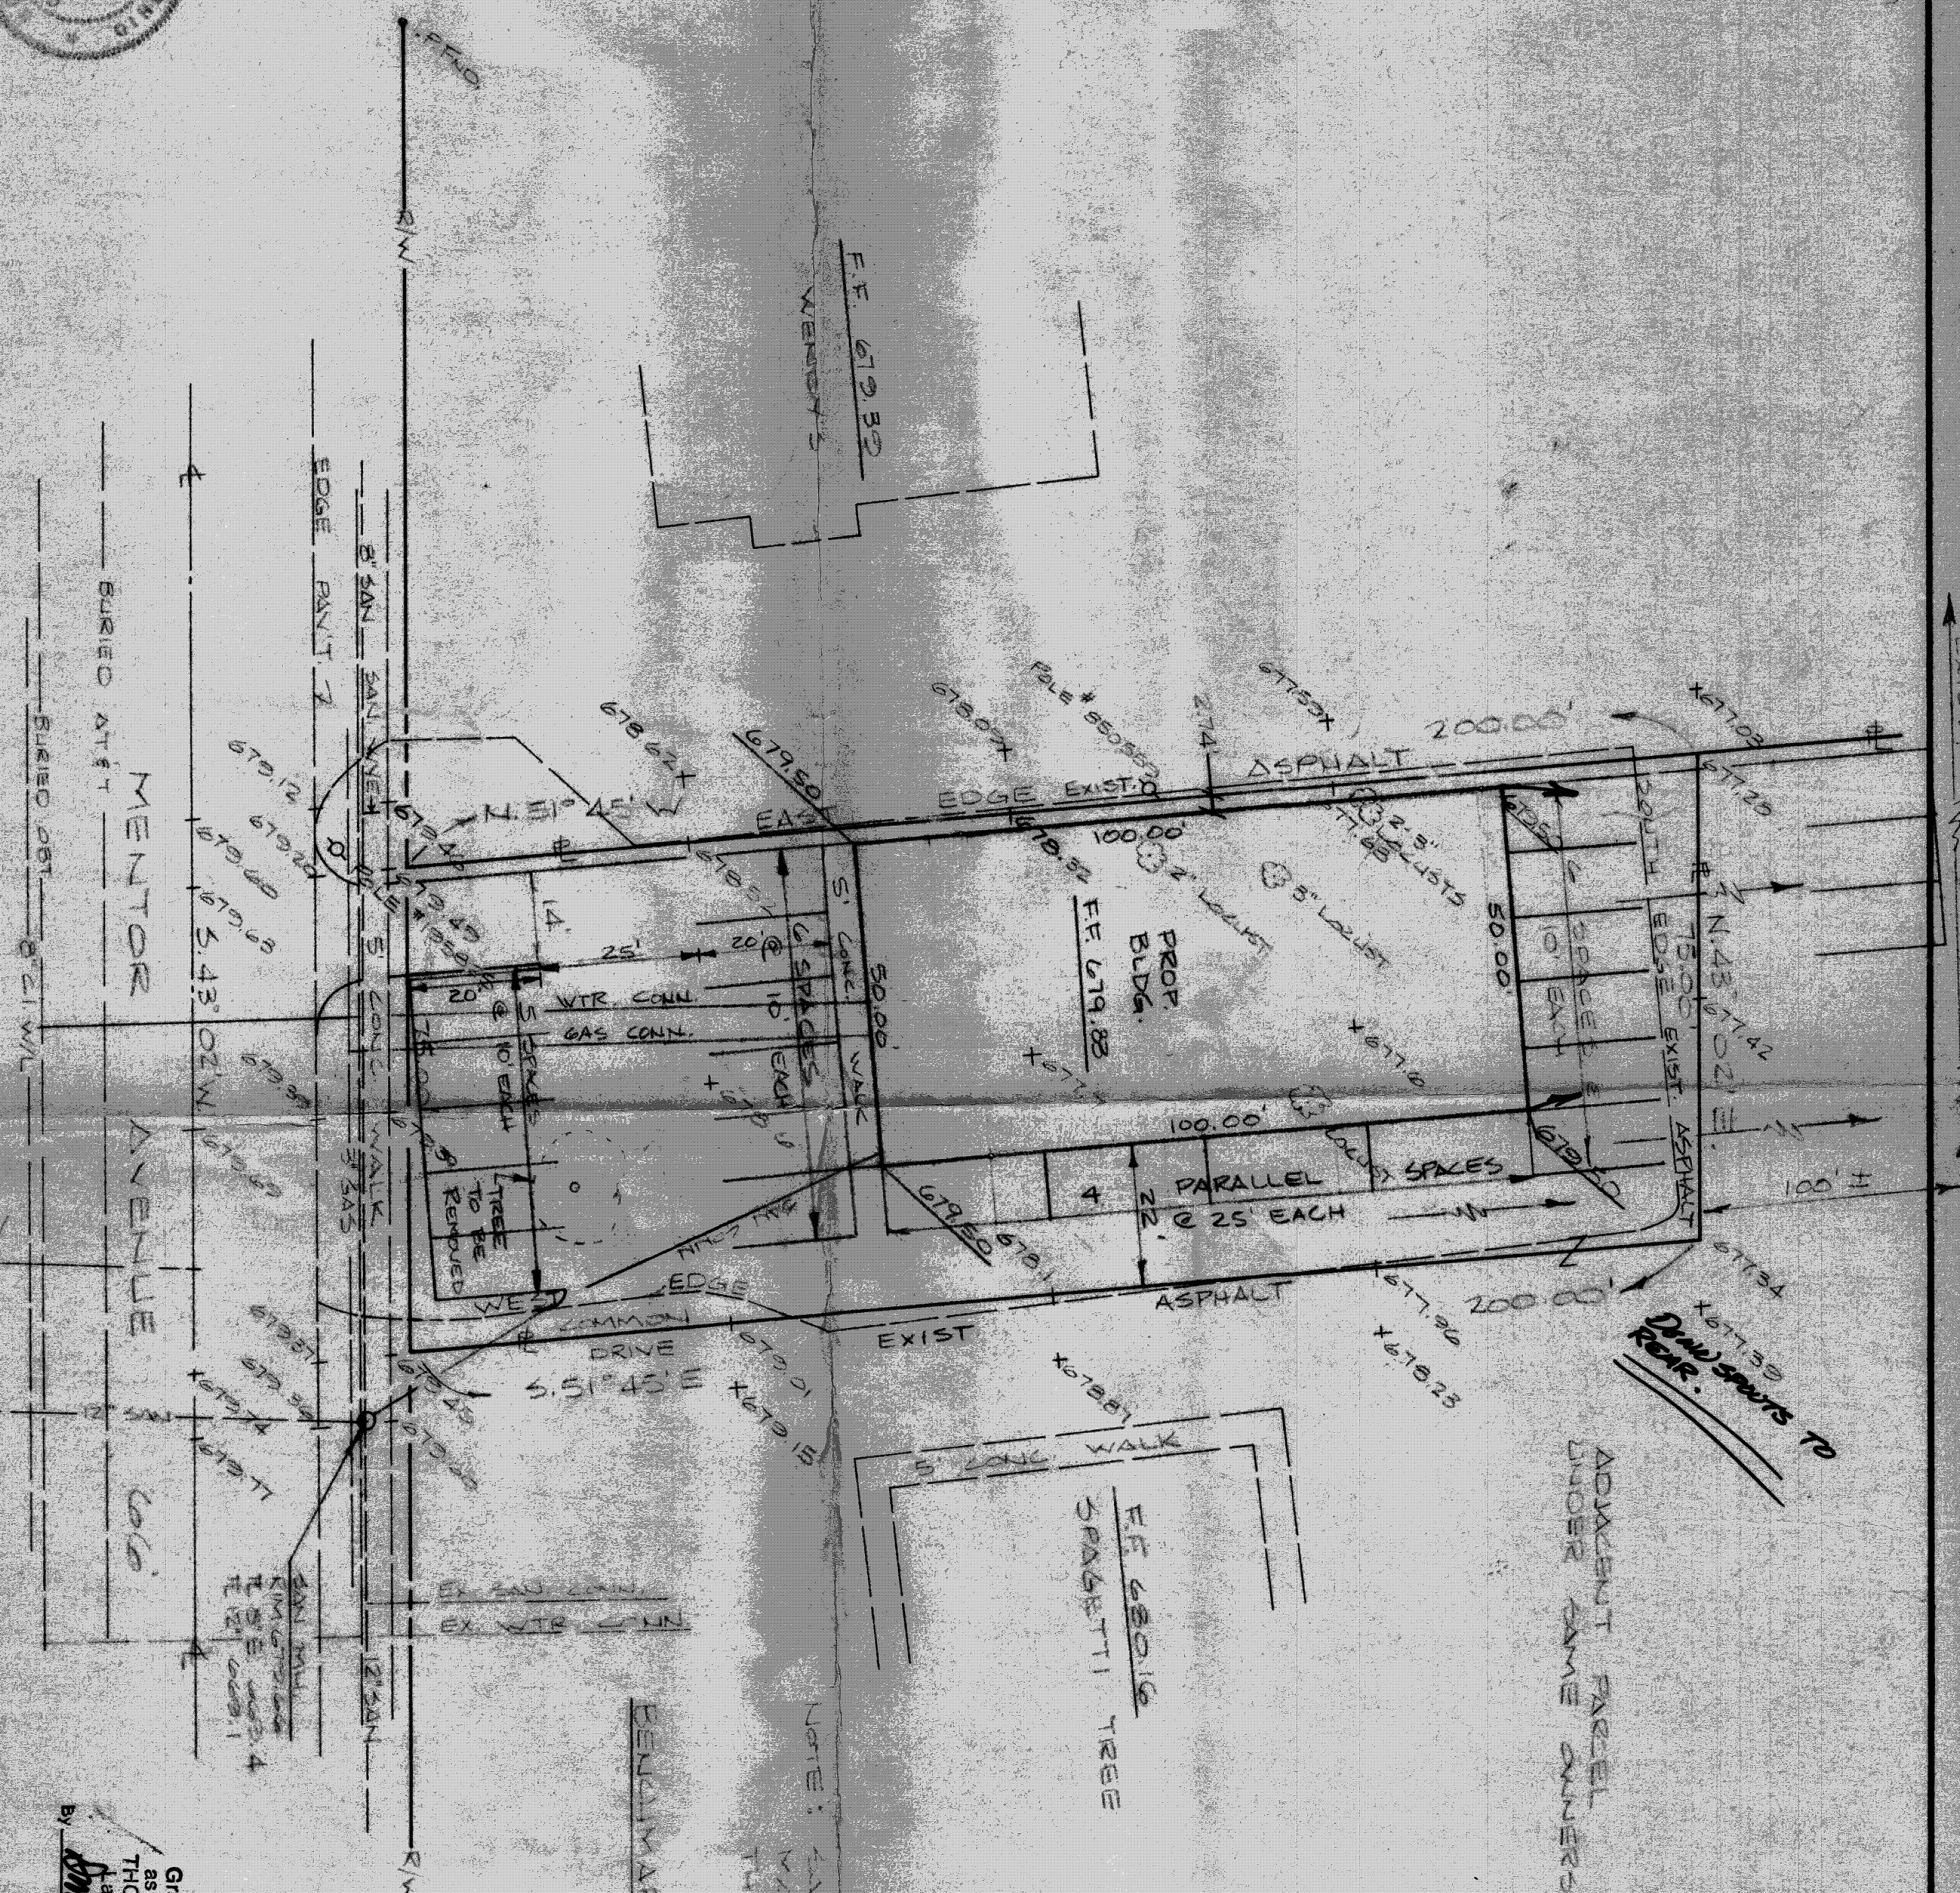

Grading Plan Approved
as shown and/or noted
THOMAS P. GILLES, P.E.
Lake County Engineer

By [Signature] Date 2/12/85

DELETED
This Permit Expires
FEB 12, 1986
PAINESVILLE TOWNSHIP
ZONING APPROVED
6120
R. M. Hawk
Zoning Inspected 2/12/85

NOTE: ANY CONNECTION TO BE
MADE AT WHOLESALE AS
THERE ARE NO EX. WALKS.

BENCHMARK: TOP HIGHEST POINT
SECURITY FEDERAL
ELEV. 551.02

Total Area 15,000 Sq. Ft.
Building Area 5,000 Sq. Ft.
Set Back 75 Ft.

ADJACENT PARCEL
UNDER SAME OWNERSHIP

Down Spouts to
Rear.