


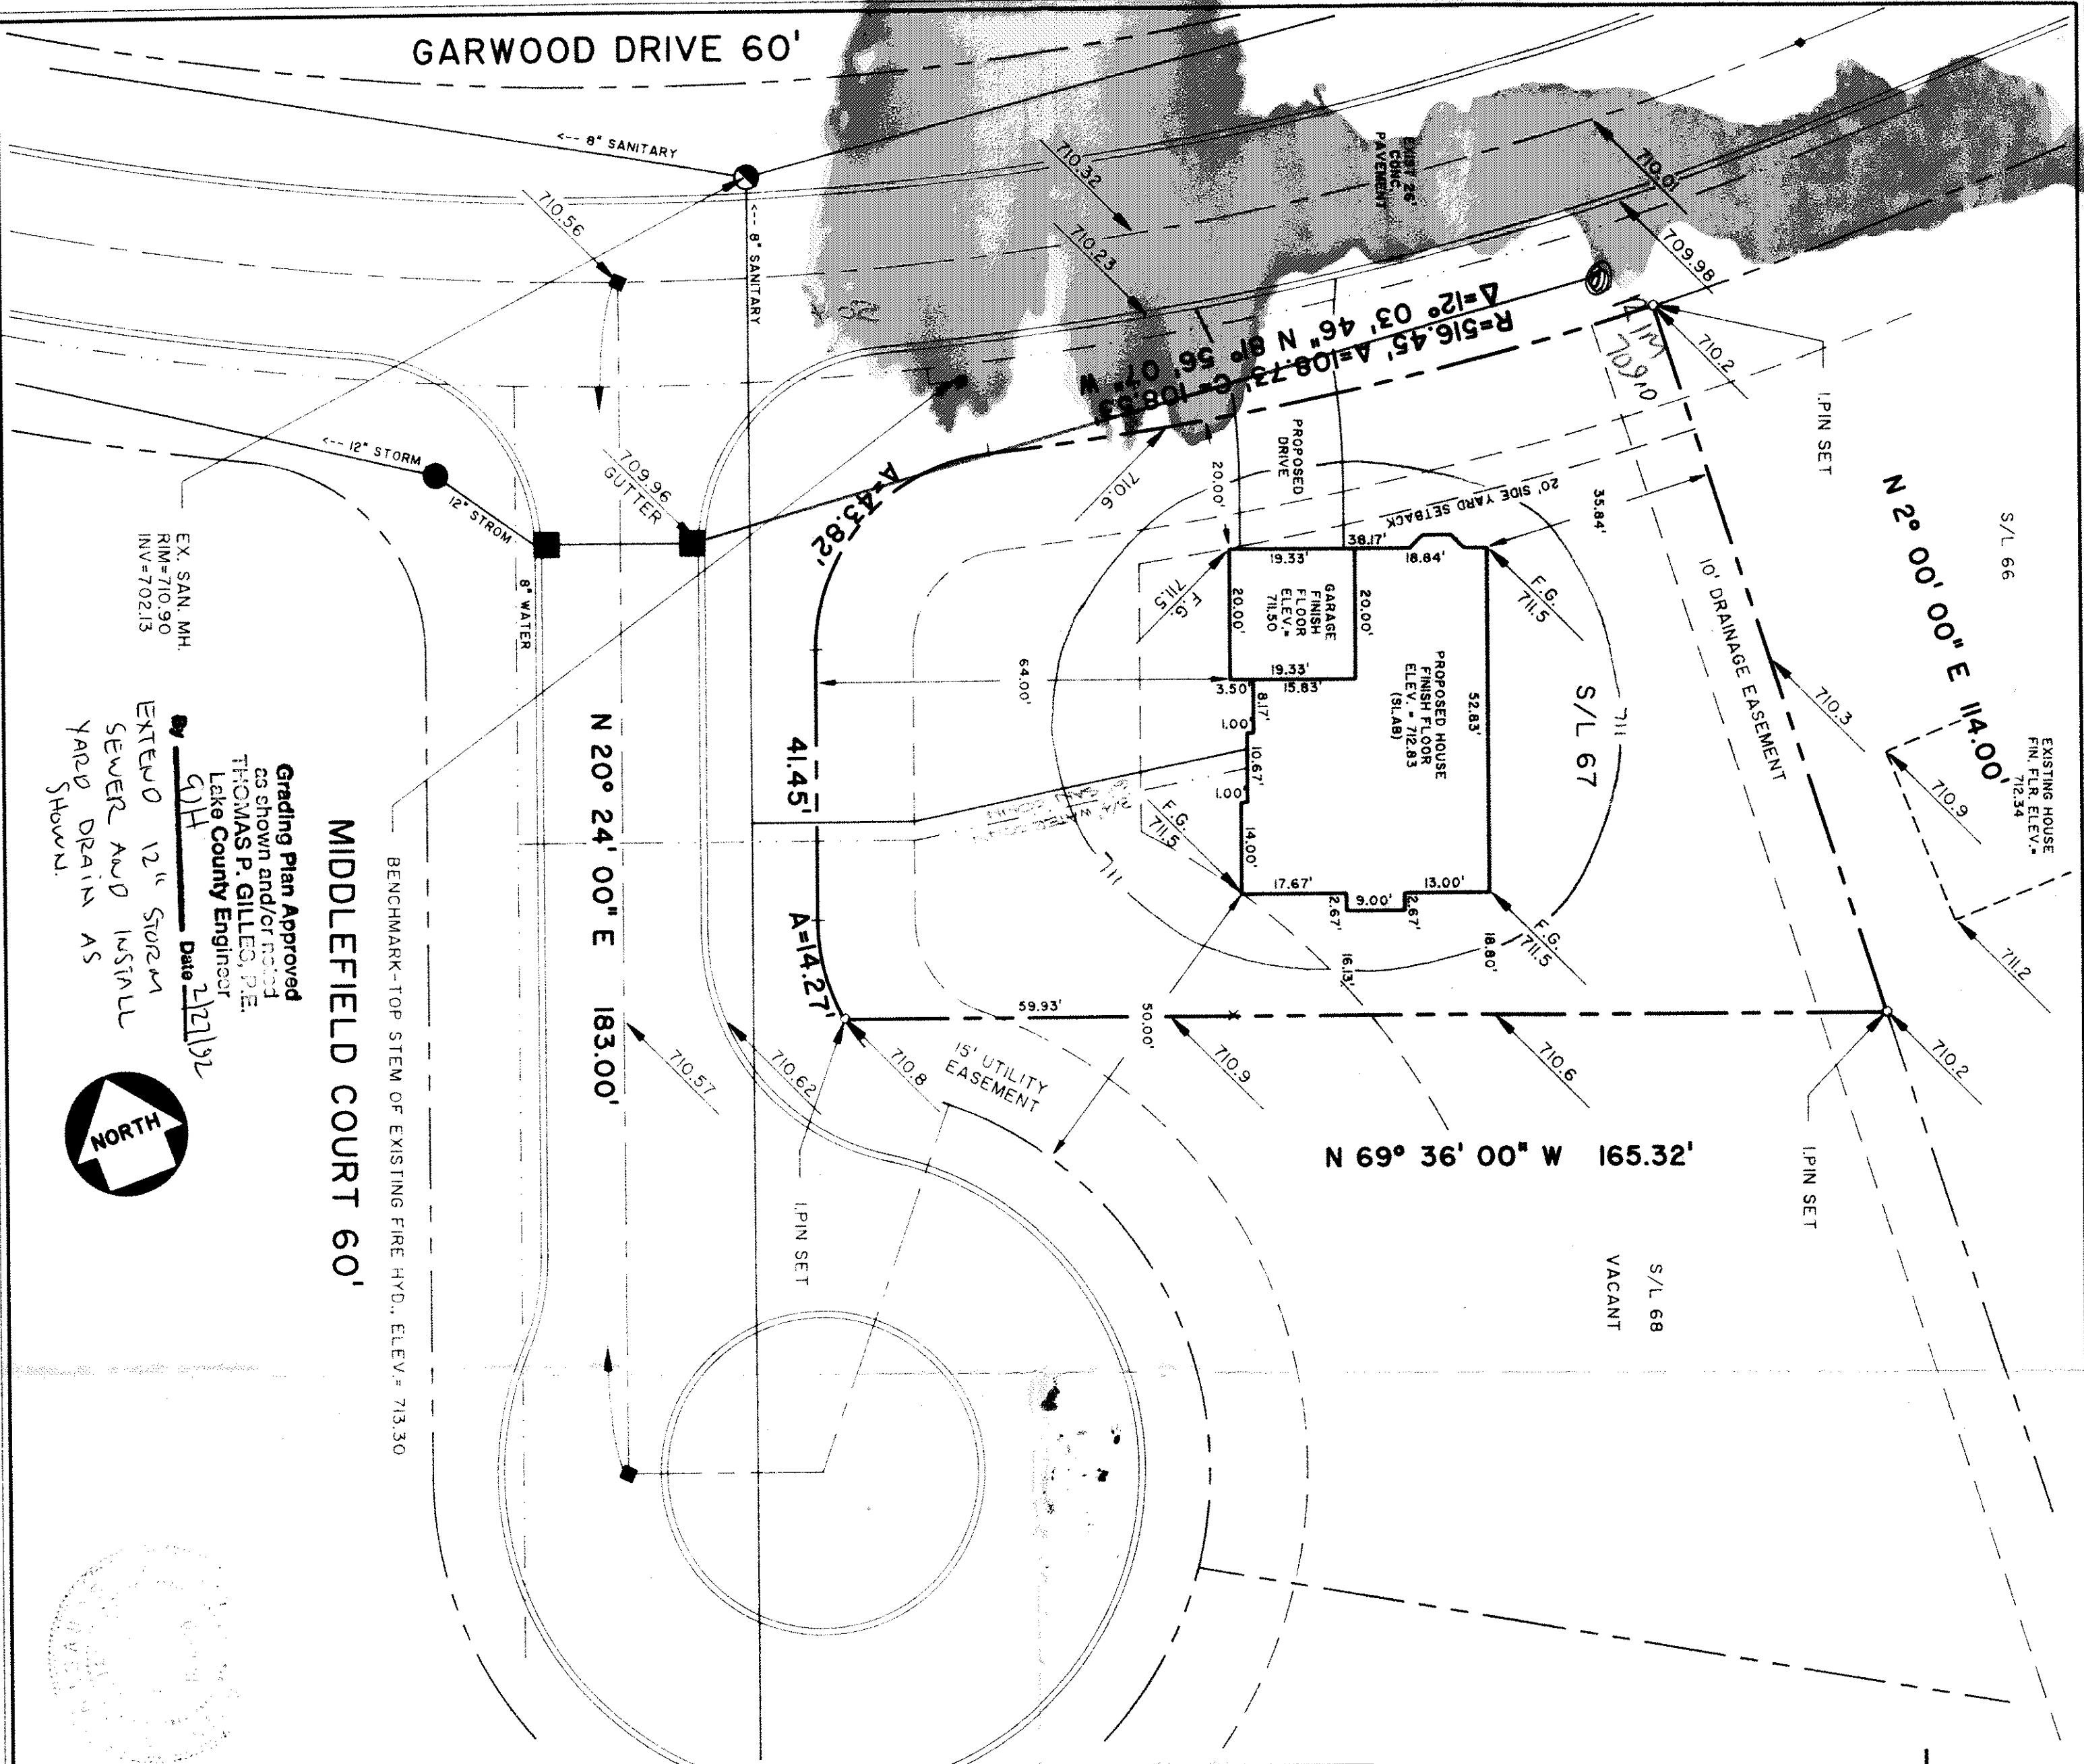

Grading Plan Approved
as shown and/or noted
THOMAS P. GILLES, P.E.
Lake County Engineer
Date 2/21/92
EXTEND 12" STORM
SEWER AND INSTALL
YARD DRAIN AS
SHOWN.

CURVE DATA

R=30.00'
A=43.82'
C=40.08'
Δ=83° 41' 46"
N 62° 14' 53" E
R=30.00'
A=14.27'
C=14.14'
Δ=27° 15' 11"
N 06° 46' 25" E

GENERAL NOTES:

1. DRIVEWAY APRON TO BE 6" THICK
2. BENCHMARK - TOP STEM OF FIRE HYDRANT LOCATED IN FRONT OF SUBLOT No. 67, ELEV. = 713.30

LEGEND

100.00
100.00
EXISTING CONTOUR
PROPOSED CONTOUR
EXISTING ELEVATION
PROPOSED ELEVATION

CERTIFICATION

"I, THE UNDERSIGNED HEREBY CERTIFY THAT THIS TOPOGRAPHY INDICATED BY 'I' CONTOURS AND ELEVATIONS SHOWN HEREON REPRESENTS AN ACTUAL SURVEY MADE BY ME ON THE 31st DAY OF DEC., 1991 AND THE ELEVATIONS WERE TAKEN AT APPROPRIATE INTERVALS AND AS OF THAT DAY THEY EXISTED AS INDICATED HEREON.

"I HEREBY CERTIFY THAT THIS PLAN WAS PREPARED BY ME AND IS CORRECT TO THE BEST OF MY KNOWLEDGE"

QUENTIN S. HIMEBAUGH, P.S. No. 6820

PREPARED BY:

Himebaugh and Associates
Surveyors and Site Consultants
38083 West Spaulding St.
Willoughby, Ohio 44094
(216) 946-1761

SITE PLAN:

SUBLOT No. 67 MIDDLEFIELD COURT 60' PAINESVILLE TWP.
HEATHERSTONE SUBDIVISION, VOL. Z, PG. 35

PREPARED FOR: JOHN SCHOENIGER
SCALE: 1" = 20'
DATE: DECEMBER 23, 1991
DRAWN BY: DAVID W. NOVAK

REV. A-REVISED HOUSE LOCATION JAN. 06, 1992
REV. B-ADDED SETBACK FROM MIDDLEFIELD CT. JAN. 07, 1992
REV. C-REVISED HOUSE LOCATION FEB. 19, 1992

91-010-067-C

This Permit Expires 2/24/93
PAINESVILLE TOWNSHIP
ZONING APPROVED
#8031
Zoning Inspector

LAKE SCH.
0.00'
13.00'
18.84'
22.00'
36.17'
37.17'
38.17'
39.67'
39.67' BY 72.83' 82.93'