

STAKE SCH.

0.00'
2.00'
4.00'
19.33'
29.00'
DIAG • 10 OS = 73.0'

CURVE DATA

R=30.00'
A=22.66'
C=22.12'
Δ = 43° 16' 33"
N 28° 29' 27" W

R=60.00'
A=83.60'
C=77.00'
Δ = 79° 49' 44"
N 10° 12' 52" W

GENERAL NOTES:

1. DRIVEWAY APRON TO BE 6" THICK
2. BENCHMARK - TOP STEM OF FIRE HYDRANT LOCATED IN FRONT OF SUBLOT NO. 72, ELEV. = 714.35

LEGEND

EXISTING CONTOUR
PROPOSED CONTOUR
EXISTING ELEVATION
PROPOSED ELEVATION

CERTIFICATION

"I, THE UNDERSIGNED HEREBY CERTIFY THAT THIS TOPOGRAPHY INDICATED BY IT CONTOURS AND ELEVATIONS SHOWN HEREON REPRESENTS AN ACTUAL SURVEY MADE BY ME ON THE 7th DAY OF FEB. 1992 AND THE ELEVATIONS WERE TAKEN AT APPROPRIATE INTERVALS AND AS OF THAT DAY THEY EXISTED AS INDICATED HEREON.

"I HEREBY CERTIFY THAT THIS PLAN WAS PREPARED BY ME AND IS CORRECT TO THE BEST OF MY KNOWLEDGE"


QUENTIN S. HIMEBAUGH, P.S. No. 6820

PREPARED BY:

Himebaugh and Associates
Surveyors and Site Consultants
38083 West Spaulding St.
Willoughby, Ohio 44094
(216) 946-1761

SITE PLAN:

SUBLOT No. 68 MIDDLEFIELD COURT 60' PAINESVILLE TWP.
HEATHERSTONE SUBDIVISION, VOL. 2, PG. 35
PREPARED FOR: SCHONIGER BROS. CONSTRUCTION, INC.
SCALE: 1" = 20'
DATE: FEBRUARY 10, 1992
DRAWN BY: DAVID W. NOVAK

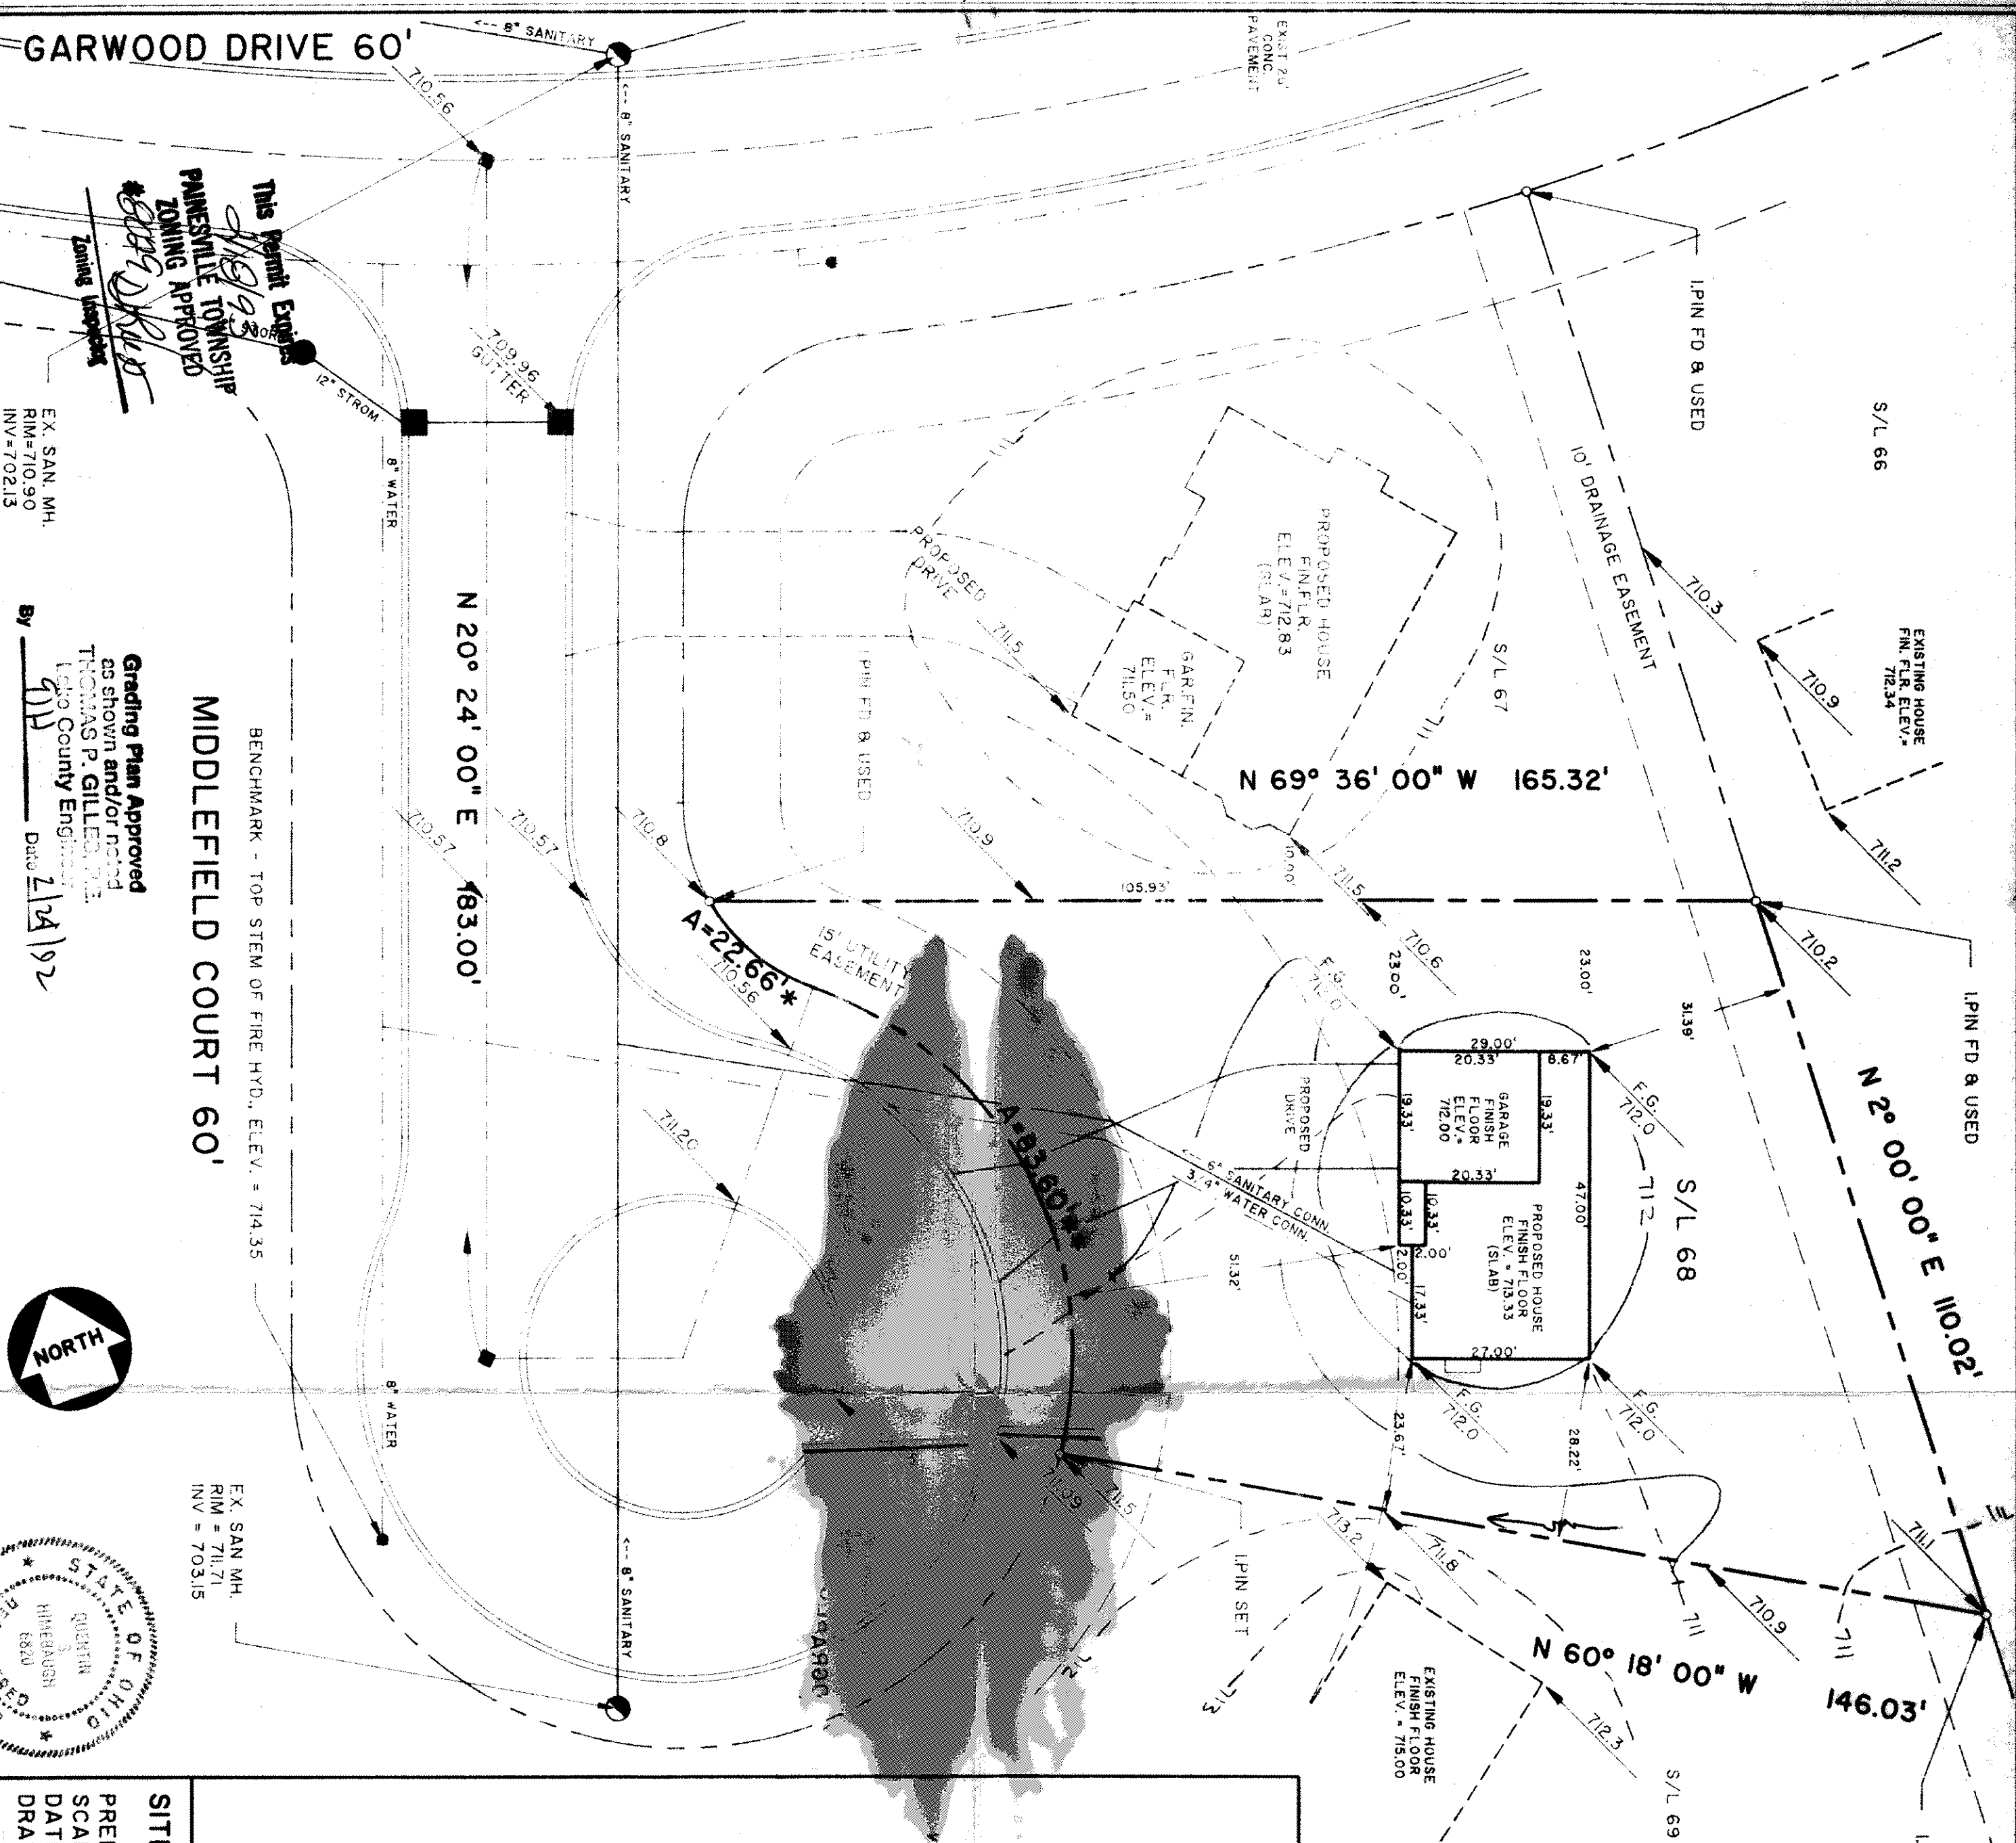

MIDDLEFIELD COURT 60'


BENCHMARK - TOP STEM OF FIRE HYD. ELEV. = 714.35

Grading Plan Approved

as shown and/or noted
THOMAS P. GILLED, P.E.
Licking County Engineer

By TPG Date 2/14/92

EX. SAN. MH.
RIM=710.90
INV=702.15

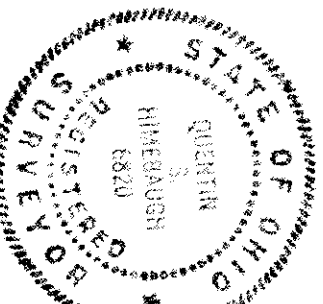

91-010-068