

SITE PLAN

PAINESVILLE LAKE COUNTY, OHIO

for: DAVE MURADO  
CLIENT: TOWNSHIP  
OWNER: TOWNSHIP  
ADDRESS: 7440 KING MEMORIAL, MENTOR, OHIO  
CITY: ZIP:

HEATHER STUDY E

SUBDIVISION 2-25 NAME  
VOL. 100-1000  
SHEET NO. 1000  
MIDDLEFIELD STREET

LOT 1000  
VOLUME 1000  
PAGE 1000  
FURN. PARCEL NO. 1000  
STREET 1000

LEGEND

SANITARY MANHOLE  
STORM MANHOLE  
INLET OR CATCH BASIN  
HYDRANT  
EXISTING CONTOURS  
PROPOSED CONTOURS  
EXIST. ELEV. 1000  
PROP. ELEV. 1000

WATER VALVE (GAS)  
WATER METER (GAS)  
AS BUILT ELEVATION  
INDICATES DIRECTION OF SURFACE DRAINAGE

REMARKS

ALL BOUNDARY DATA SHOWN WAS OBTAINED FROM (DEEDS, RECORDED SUBDIVISION PLAT OR OTHER PUBLIC RECORDS)  
LOCATIONS AS SHOWN OF ADJACENT WELLS AND SEPTIC TANKS OBTAINED FROM LAKE COUNTY HEALTH DEPARTMENT

DESIGN CERTIFICATION

THIS PLAT WAS PREPARED BY ME, AND IS CORRECT TO THE BEST OF MY KNOWLEDGE AND BELIEF  
Surveyor: [Signature]  
NAME: [Name]  
SURVEYOR REGISTRATION NO. 6634

CHECK LIST

NO. OF BEDROOMS  
DIMENSIONS  
BEARINGS  
TIE TO NEAREST STREET  
SUBLOT NO. PARCEL NO.  
SURROUNDING OWNERS  
BLDG. DIMENSIONS  
BLDG. TYPE GRADES  
APPROX. TYPE WIDTH THICKNESS  
SIDEWALK TYPE WIDTH THICKNESS  
CULVERT TYPE DIA. LENGTH  
ROCK OUTCROPPINGS

WATER MAIN SIZE, LOCATION  
SAN. SEWER SIZE, GR. LOC.  
SAN. MAN. CAST. ELEV. INV. ELEV.  
SAN. CONN. SIZE, LOC. DEPTH  
STORM SEWER SIZE, GR. LOC.  
STORM MAN. CAST ELEV. INV. ELEV.  
PAV'T TYPE GRADE CURBS  
GAS LINE LOC. SIZE PRESSURE  
SEPTIC TANK LOCATION & DUPLICATION AREA  
WELL LOCATION  
ISOLATION RADIUS FROM WELL

PLAN PREPARED BY:

NO.	DATE	BY
1	1-5-86	AS
2	1-5-86	AS
3	1-5-86	AS
4	1-5-86	AS
5	1-5-86	AS

DATE: 10/27/86  
DRAWING NO. 352-9290  
APPROVED: [Signature]  
CHIEF: [Signature]

"AS BUILT" CERTIFICATION

I, HEREBY CERTIFY THAT THE CIRCLED GRADES ARE EXISTING FINISH GRADES CHECKED IN THE FIELD ON 19\_\_\_\_ AND ARE CORRECT TO THE BEST OF MY KNOWLEDGE AND BELIEF.

REGISTERED SURVEYOR

REG. NO.

72008 Pmt  
#6574


43.67	20.33
44.00	10.33
44.00	5.45
44.00	0.00

HOUSE DETAIL  
SCALE 1"=30'

HOUSE DETAIL  
SCALE 1"=30'

CURVE DATA  
A=40.00'  
C=39.27'  
Δ=38°12'  
B=N48°48'E

NOTE  
B.M. PROPOSED INVERT  
ELEV. 703.15 SAN. M.H.  
#61 CIN. FRONT OF S/L 710  
USED, TAKEN FROM  
ENVIRONMENTAL ASSOC., INC.  
SCDD, OHIO

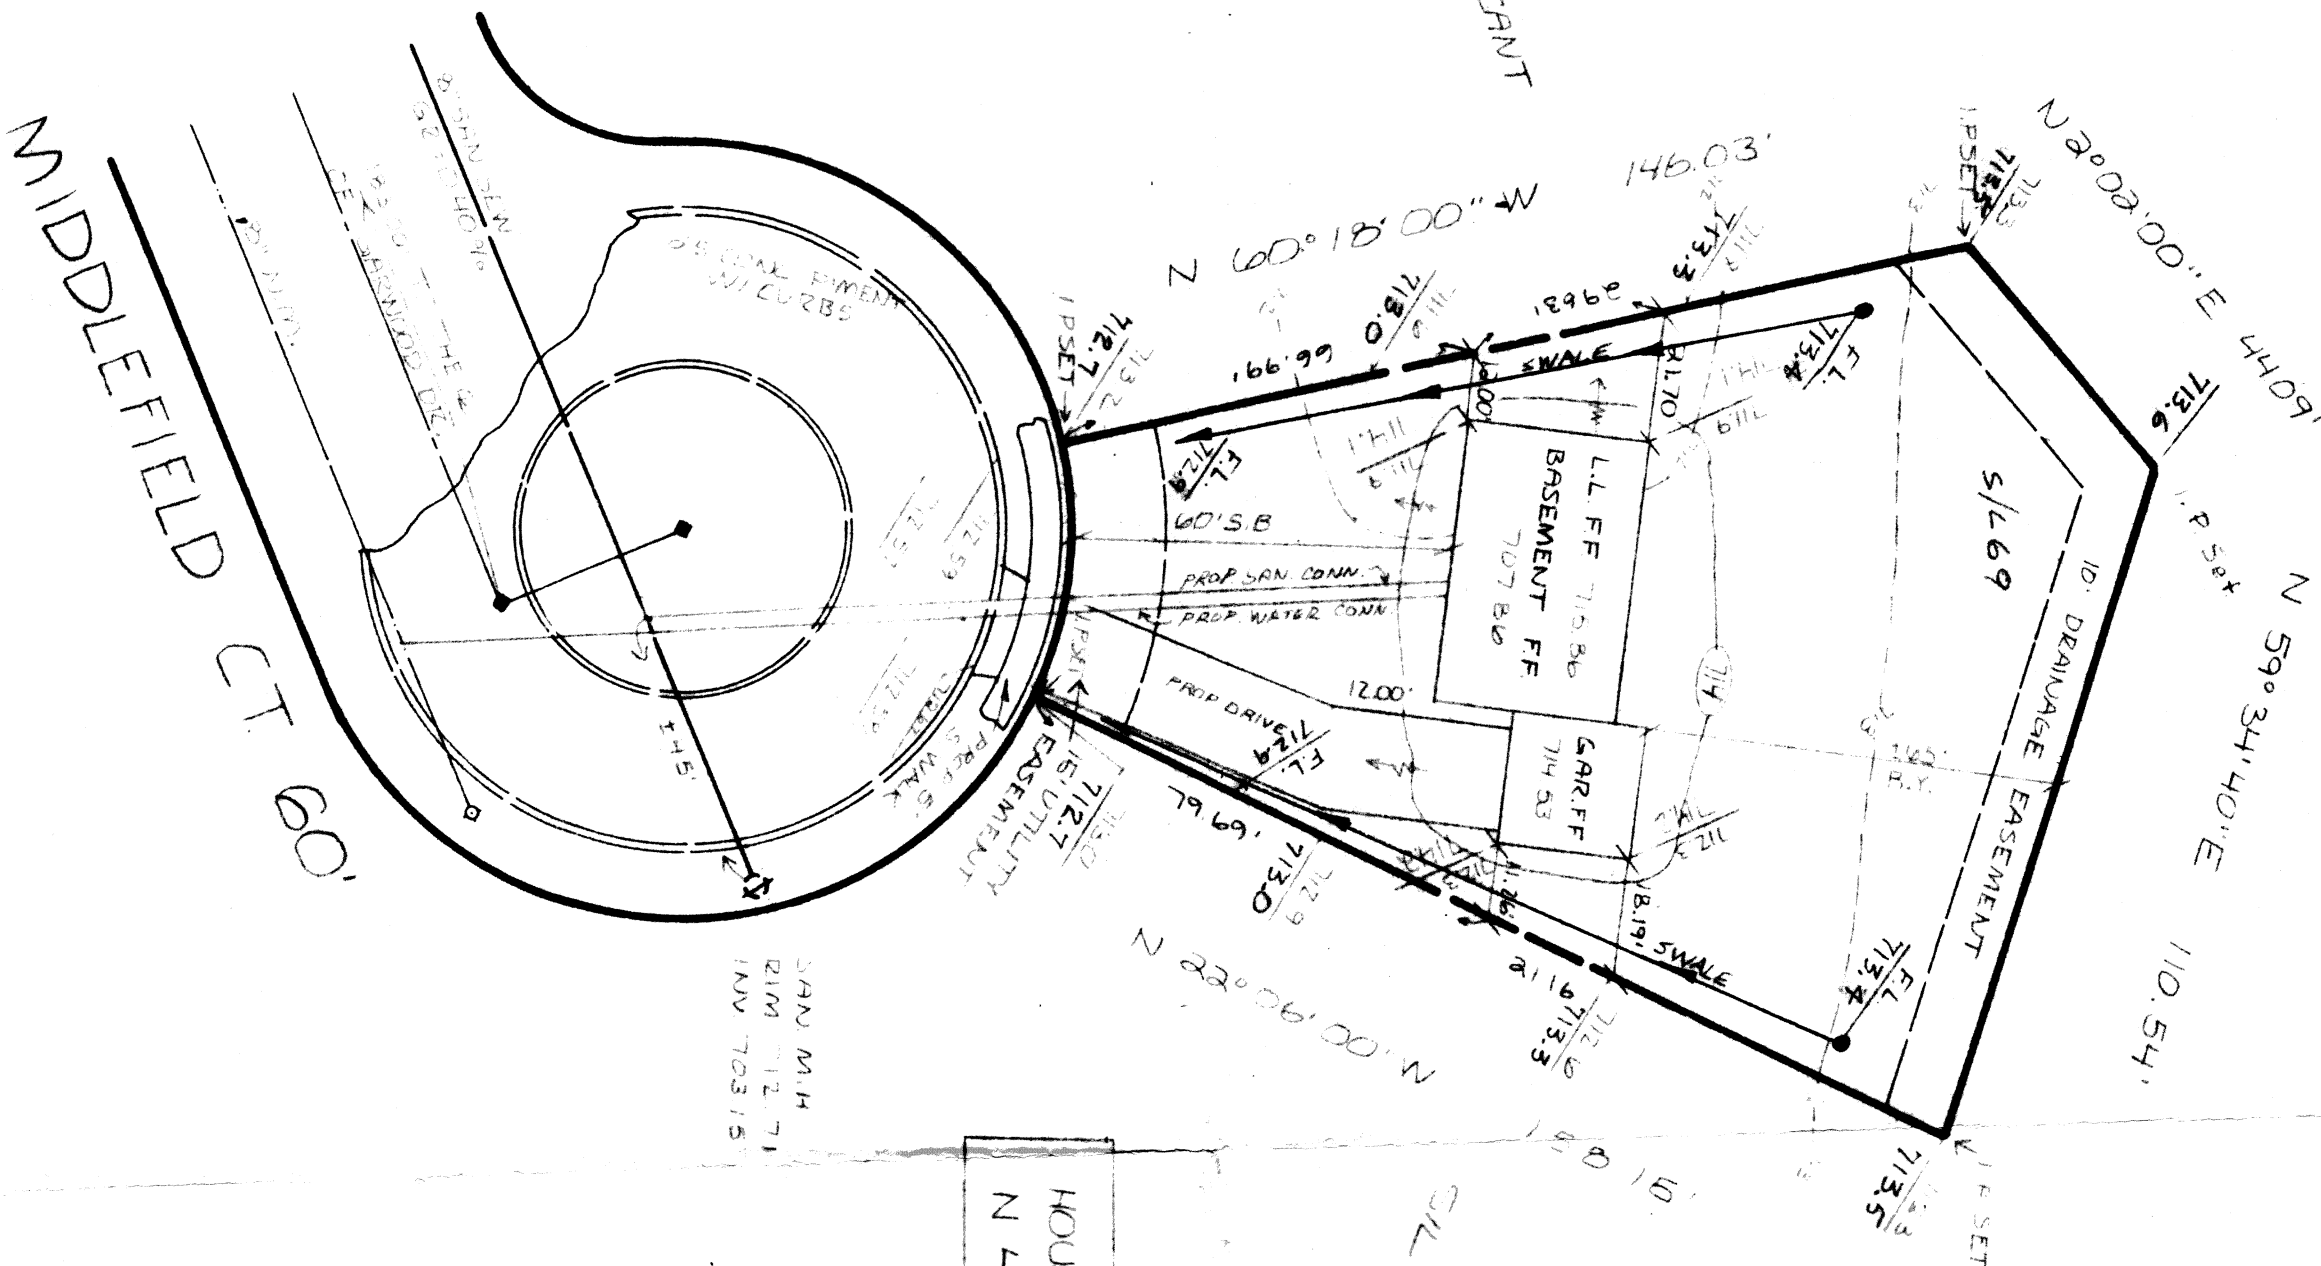

Grading Plan Approved  
as shown and/or noted  
THOMAS P. GILLES, P.E.  
Lake County Engineer  
Date 1-17-87