



topography, indicated by 1' contours, and elevations shown hereon represent an actual field survey by me on 7-15-01 and that they were taken at appropriate intervals and that as of that date they existed as indicated hereon.

J.M. Coffman P.S.
6857

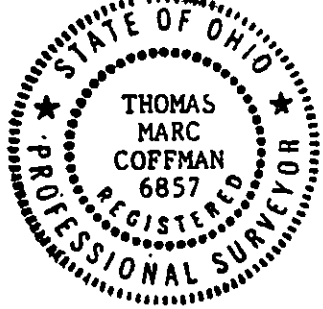

JULY 27, 2001

BENCHMARK-623.58
NRM SAN M.H.: 100-614.00

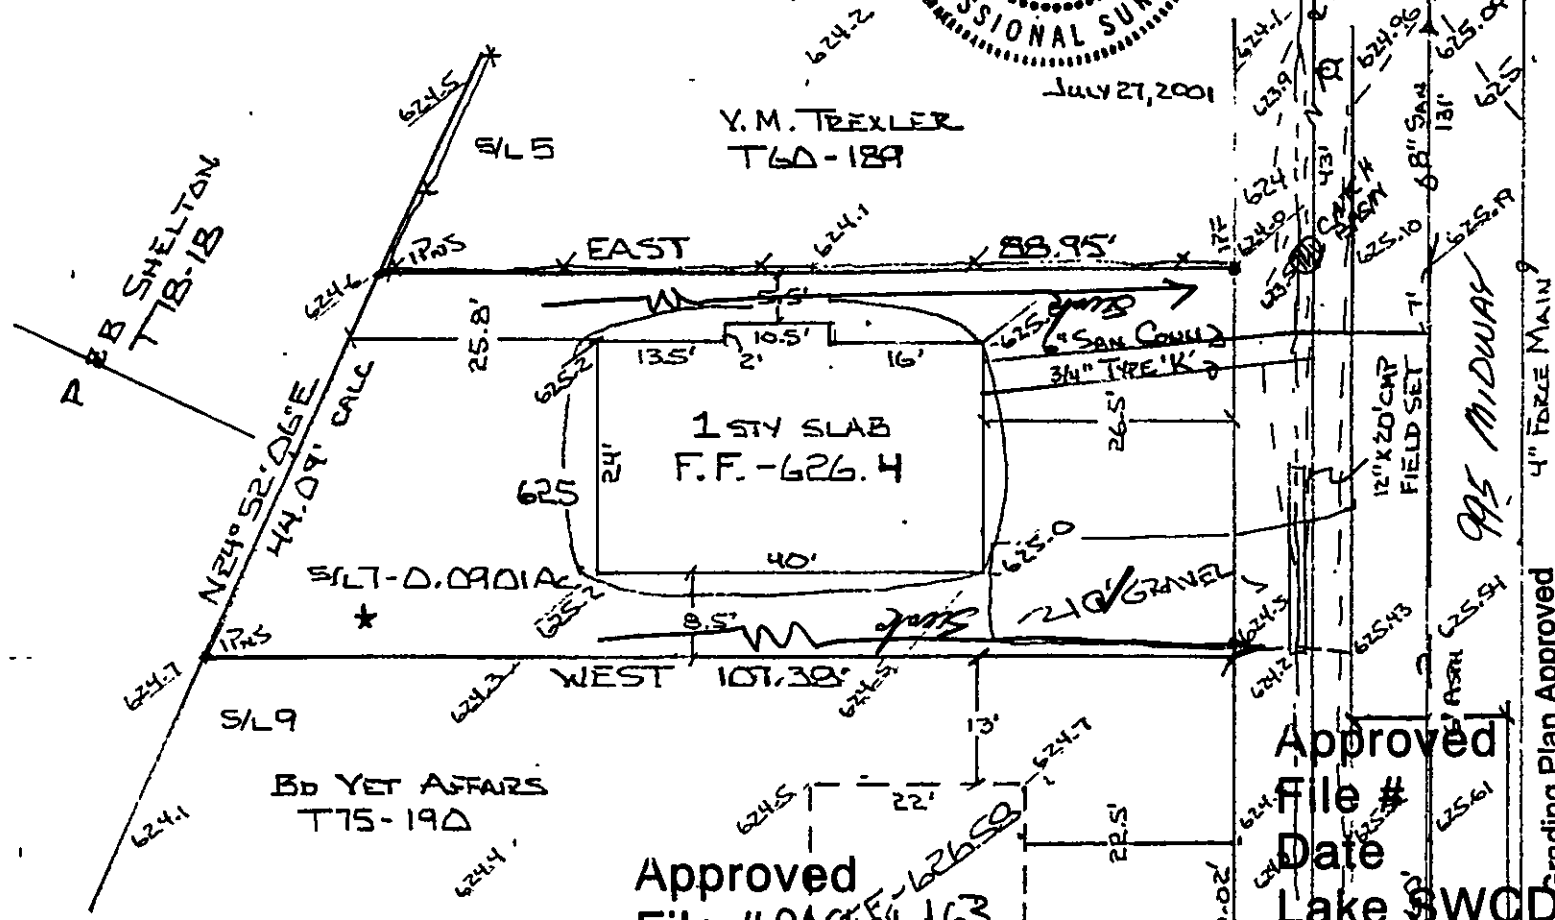

* JAMES D. MROWKA
INST. NO. 200105002

Approved
File # PAGE 6163
Date 08/22/01
Lake SWCD

SITE PLAN
FOR
TOM REED
BEING S/L 7. BLOCK B. IN THE
SUNSET P. ALLOT., PAINESVILLE TWP.
LAKE COUNTY, OHIO.

Approved
File #
Date
Lake SWCD

Grading Plan Approved
as shown and/or noted
JAMES R. GILLS, P.E.
Lake County Engineer

APPROVED
PAINESVILLE TOWNSHIP
ZONING DEPARTMENT

ROOF DRAINS
SHALL DISCHARGE
TO SPL. WELL WELLS SURVEYING CO.

P.O. BOX 1006, FAIRPORT HARBOR, OH 44077
(440) 357-1359

T seeding of Disturbed areas