


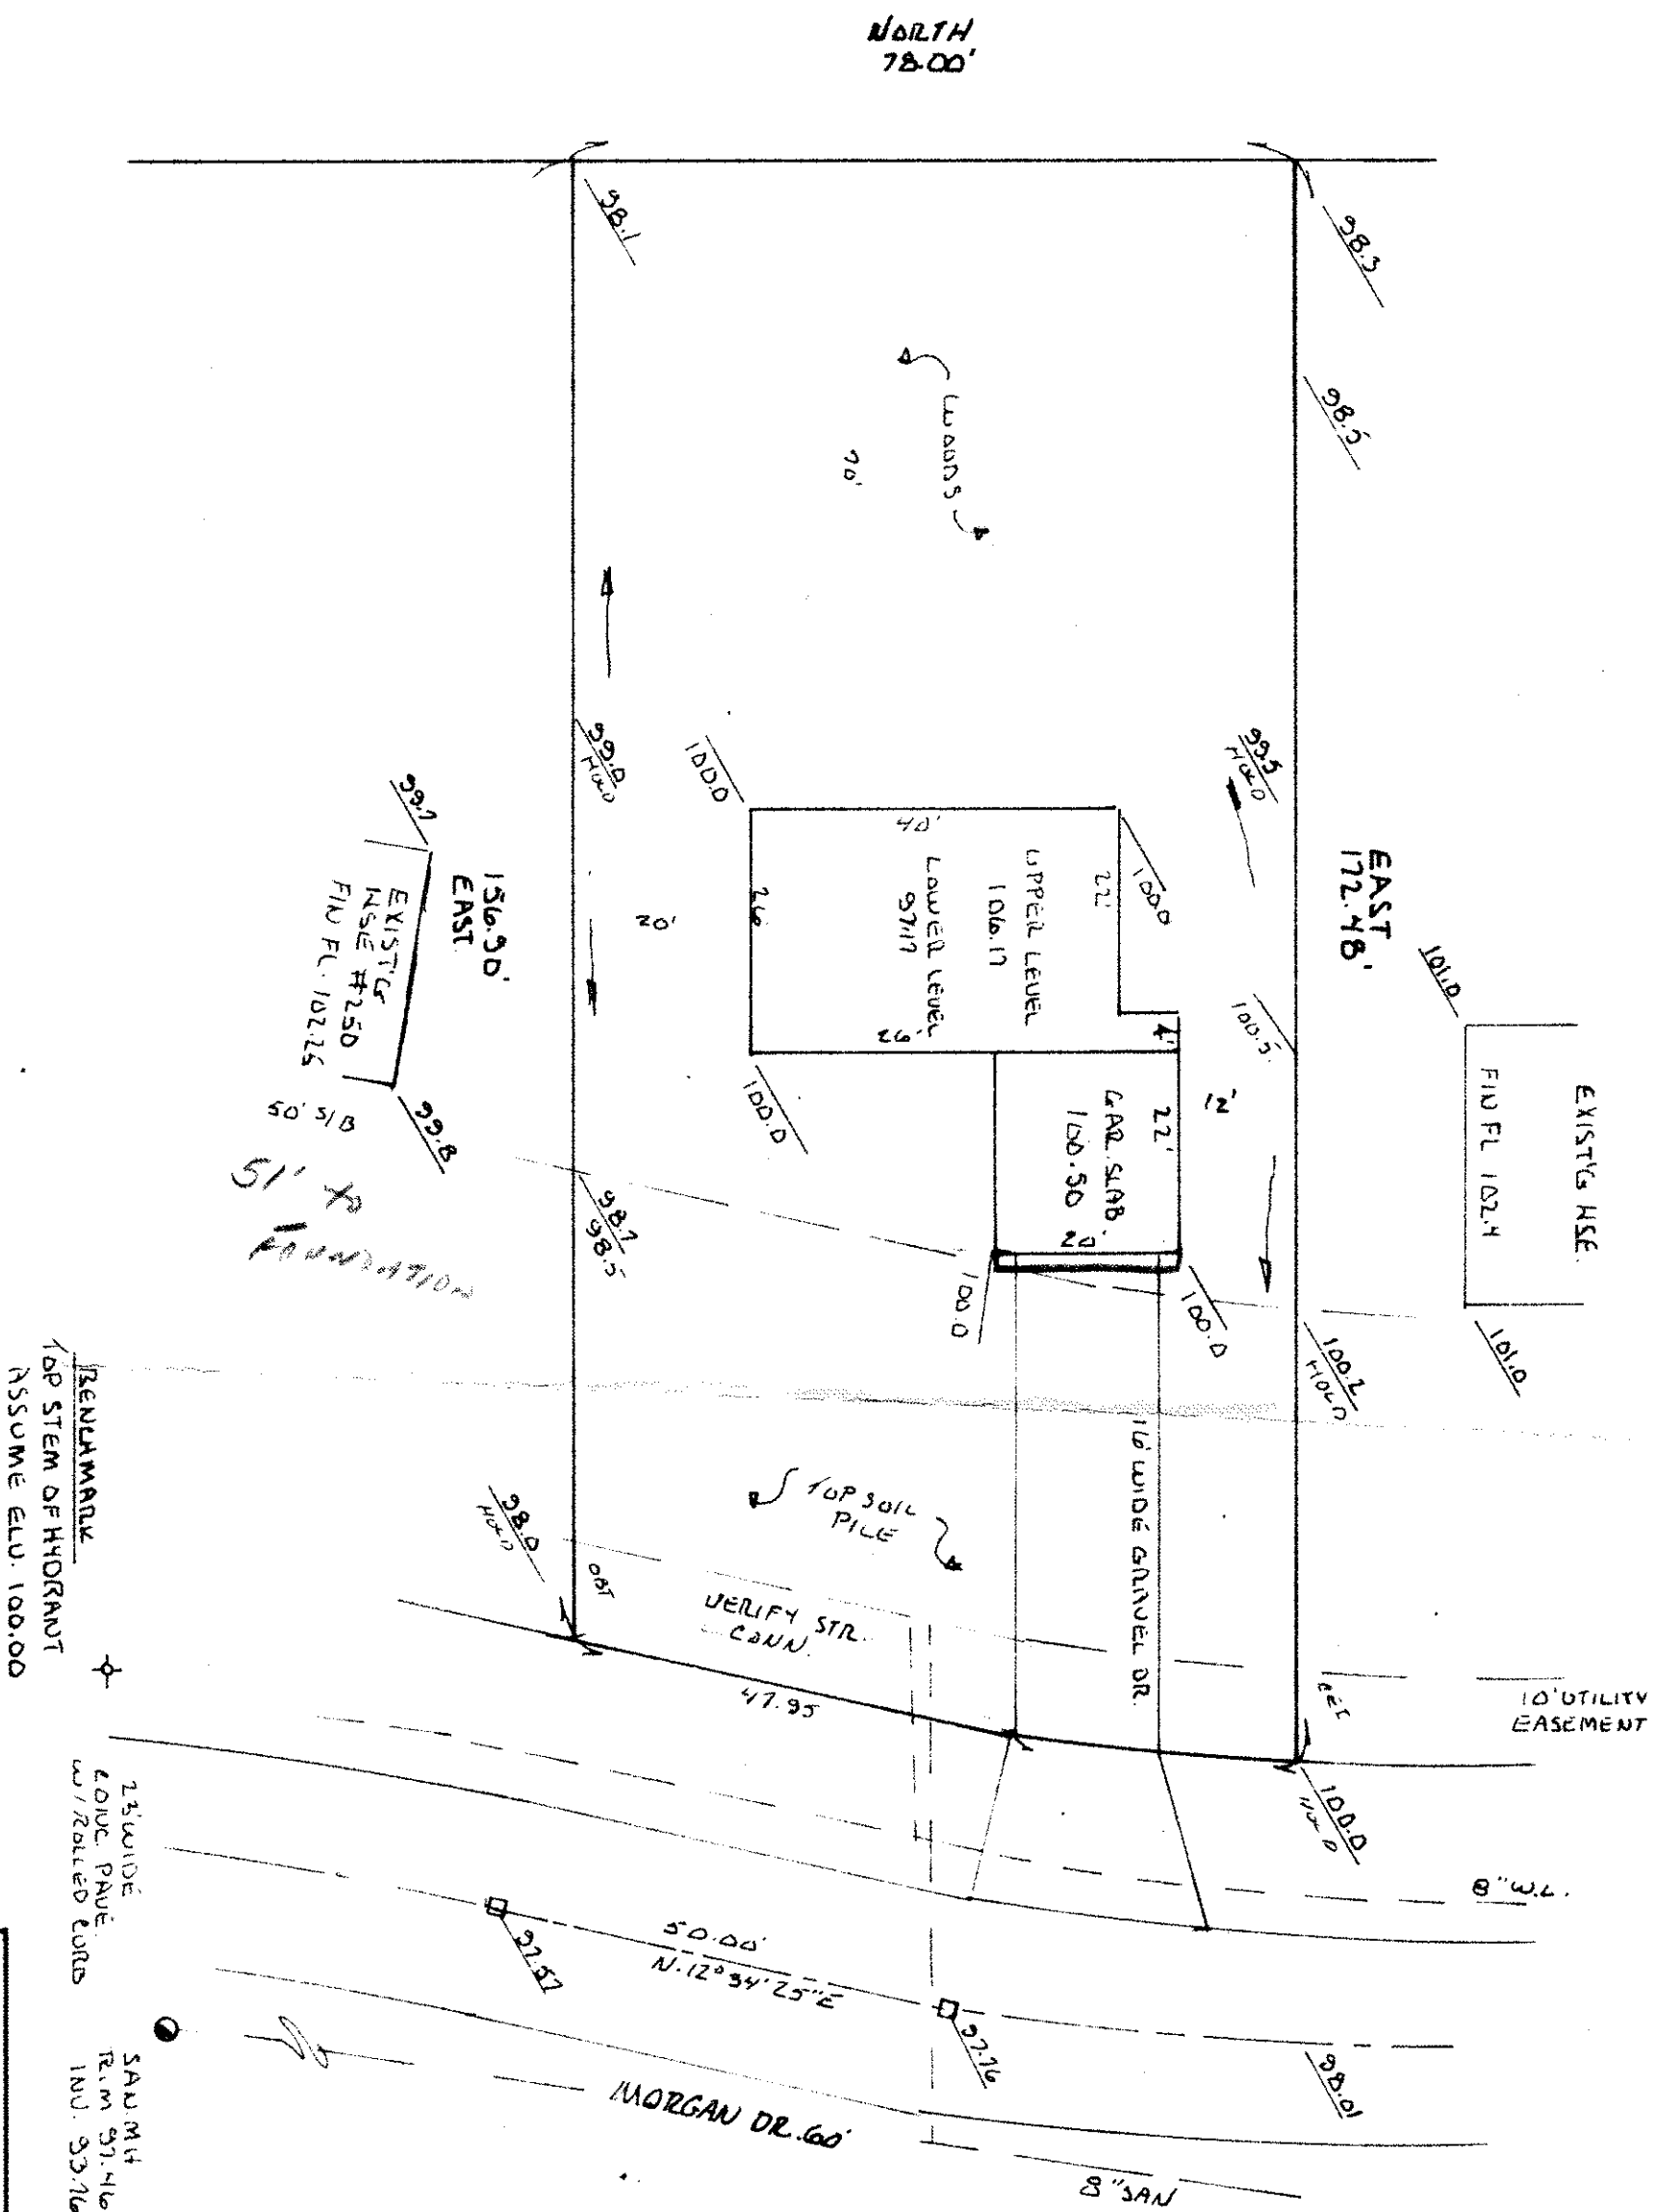

I CERTIFY THAT THIS PLAN WAS PREPARED BY ME AND IS CORRECT TO THE BEST OF MY KNOWLEDGE AND BELIEF.

John C. Sikonielzady
REG. SURVEYOR No. 6366
7739 VIEWMOUNT DR.
PAINESVILLE OHIO
44067
PN 352-7742

This Permit Expires
JUN 26 1985
PAINESVILLE TOWNSHIP
ZONING APPROVED
6000
R.M. Hall
Zoning Inspector *1*

Approved
for noted
FILES, P.E.
Engineer
Date 2 Jy/84

**SITE PLAN
FOR
IDEAL AMERICAN HOMES**

EXIST'G CZAPDES

BENCHMARK
TOP STEM OF HYDRANT
ASSUME ELV. 100.00

51-70
FBI-4710

156.90
EAST
EXIST'G
NISE #250
FIN FL 10225

EAST
172.48'

EXIST'G HSE
FID FL 102.4

10' UTILITY
EASEMENT

NORTH
78.00'

70

UPPER LEVEL
106.17
LOWER LEVEL
97.17

120.50 2

VERIFY STR
CONN.

TOP SOIL
PILE

MORGAN DR. 600

8" SAN

SCALE: 1" = 20'	APPROVED BY	DRAWN BY J. C. S.
DATE: JUN. 84		
DEBELC SL14 MORGAN DRIVE		
PAINESVILLE TOWNSHIP LAKE COUNTY, OHIO		
JOB # 285	DRAWING NUMBER	

DRAWING NUMBER
84-4/65