
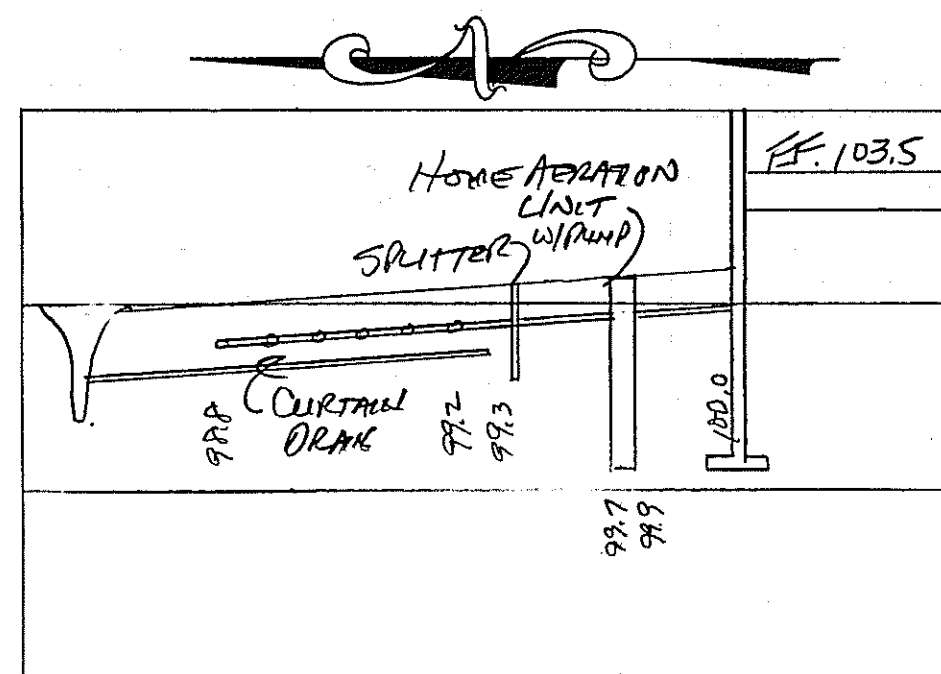
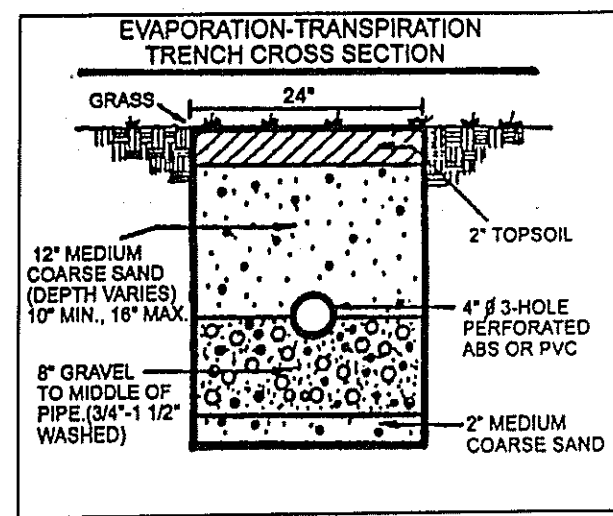


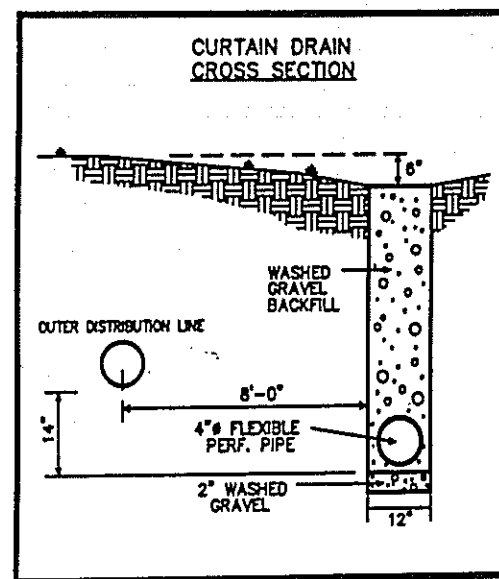

Stormwater Management Plan
Approved as shown and/or noted
JAMES R. GILLS, P.E.
County Drainage Engineer
By L.S. Date 4/27/06

REVIEWED AND ACCEPTED
LAKE COUNTY GENERAL
HEALTH DISTRICT

SEWAGE DISPOSAL PERMIT MUST BE
OBTAINED BY A LAKE COUNTY LICENSED
INSTALLER BEFORE INSTALLATION IS
STARTED.

SITE PLAN

PAINESVILLE TWP., LAKE COUNTY, OHIO

for: **JEFF OROSZ**

SUBDIVISION		NAME		TRACT		STREET	
15 & PT. 16		G-144		LOT		11B-33A-44	
SUBLOT NO.		MORGAN DRIVE		VOL.-PG.		PERM. PARCEL NO.	

LEGEND

SANITARY MANHOLE	---	1	EXIST. ELEV. 100.0	PROF. ELEV.
STORM MANHOLE	---	2	AS BUILT ELEVATION	
INLET OR CATCH BASIN	---	3	INDICATES	
HYDRANT	---	4	DIRECTION OF	
EXISTING CONTOURS	---	5	SURFACE DRAINAGE	
PROPOSED CONTOURS	---	6		

REMARKS

ALL BOUNDARY DATA SHOWN WAS OBTAINED FROM (DEEDS, RECORDED
SUBDIVISION PLAT OR OTHER PUBLIC RECORDS)
LOCATIONS AS SHOWN OF ADJACENT WELLS AND SEPTIC TANKS OBTAINED FROM
LAKE COUNTY HEALTH DEPARTMENT

DESIGN CERTIFICATION

THIS PLAT WAS PREPARED BY ME, AND IS CORRECT
TO THE BEST OF MY KNOWLEDGE AND BELIEF.

NAME Jeff Orosz SURVEYOR REGISTRATION NO. 6343

CHECK LIST

NO. OF BEDROOMS	WATER MAIN SIZE, LOCATION
DIMENSIONS	SAN. SEWER SIZE & GR. LOC.
BEARINGS	SAN. MH. CAST. ELEV. INV. ELEV.
TIE TO NEAREST STREET	SAN. CONN. SIZE, LOC. DEPTH
SUBLOT NO. PARCEL NO.	STORM SEWER SIZE & GR. LOC.
SURROUNDING OWNERS	STORM MH. CAST. ELEV. INV. ELEV.
BLDG. DIMENSIONS FIN GR.	PAVT TYPE GRADE CURVES
BLDG. TIES FL'R. GRADES	GAS LINE LOC. SIZE PRESSURE
APRON TYPE WIDTH THICKNESS	SEPTIC TANK LOCATION & DUPLICATION AREA
SIDEWALK TYPE WIDTH THICKNESS	WELL LOCATION
CULVERT TYPE DIA., LENGTH	ISOLATION RADIUS FROM WELL
ROCK OUTCROPPINGS	

REVISIONS			PLAN PREPARED BY:		
NO.	DATE	BY	Bj BABCOCK JONES & ASSOCIATES, INC.		
1	3/30/06	HA	PAINESVILLE, OHIO		
2					
3			DRAWN BY B.P.	SCALE 1"=20'	PHONE NO. 440-357-1811
4			CHK'D. H.J.	DATE 2/7/06	DRAWING NO. 06-012
5			CREW CHIEF W.B.	APP'D H.J.	

"AS BUILT" CERTIFICATION
I, HEREBY CERTIFY THAT THE CIRCLED GRADES ARE EXISTING
FINISH GRADES CHECKED IN THE FIELD ON 4/19/06, 2006
AND ARE CORRECT TO THE BEST OF MY KNOWLEDGE AND BELIEF.

REGISTERED SURVEYOR REG. NO.


TBM - PK NAIL SET
ELEV - 100.00

GRAPHIC SCALE



(IN FEET)
1 inch = 20 ft.

EXISTING UTILITIES NOTE:
THE SIZE AND LOCATION, BOTH HORIZONTAL AND VERTICAL
OF THE UNDERGROUND UTILITIES SHOWN HEREON, HAVE BEEN
OBTAINED BY A SEARCH OF AVAILABLE RECORDS.
VERIFICATION BY FIELD OBSERVATION HAS BEEN CONDUCTED
WHERE PRACTICAL, HOWEVER, BABCOCK, JONES AND ASSOCIATES
INC. DOES NOT GUARANTEE THE COMPLETENESS NOR ACCURACY
THEREOF.

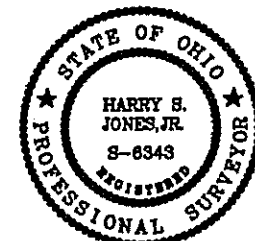

MORGAN DRIVE - 40'

APPROVED
Painesville Township
Zoning Department

2006/128 J. Rust
4/19/06