

SITE PLAN

PAINESVILLE TOWNSHIP LAKE COUNTY, OHIO

for: WAYNE HAWKINS

P.O. BOX 164 STREET CITY ZIP

JERBAK POLLOCK
SUBDIVISION H-121
VOL. PG. MORRELL
STREET

LOT 7 BLOCK 115 TRACT
VOLUME PAGE
PERM PARCEL NO. STREET

LEGEND
SANITARY MANHOLE
STORM MANHOLE
INLET OR CATCH BASIN
HYDRANT
EXISTING CONTOURS
PROPOSED CONTOURS
EXIST. ELEV. 1000
PROP. ELEV. 1000

REMARKS

ALL BOUNDARY DATA SHOWN WAS OBTAINED FROM IDEEDS, RECORDED SUBDIVISION PLAT OR OTHER PUBLIC RECORDS.
LOCATIONS AS SHOWN IF ADJACENT WELLS AND SEPTIC TANKS OBTAINED FROM LAKE COUNTY HEALTH DEPARTMENT

DESIGN CERTIFICATION

THIS PLAT WAS PREPARED BY ME, AND IS CORRECT TO THE BEST OF MY KNOWLEDGE AND BELIEF.

NAME SURVEYOR REGISTRATION NO.

CHECK LIST

NO. OF BEDROOMS
DIMENSIONS
BEARINGS
TIE TO NEAREST STREET
SUBLOT NO. PARCEL NO.
SURROUNDING OWNERS GR.
BLDG. DIMENSIONS FIN. GR.
BLDG. USE
ROAD, ALLEY, EASEMENT, GRASSY AREAS
SIDEWALK TYPE, WIDTH, THICKNESS
CULVERT TYPE DIA. LENGTH
ROCK OUTCROPPINGS
WATER MAIN SIZE, LOCATION
SAN. SEWER SIZE & GR. LOC.
SAN. MH. CAST ELEV. INV. ELEV.
SAN. CONN. SIZE LOC. DEPTH
STORM SEWER SIZE & GR. LOC.
STORM MH. CAST ELEV. INV. ELEV.
PAV'T TYPE GRADE CURBS
GASTING TANK SIZE PRESSURE
SEPTIC TANK LOCATION & OUPICATION AREA
WELL LOCATION
ISOLATION RADIUS FROM WELL

PLAN PREPARED BY:


A. C. TERRA
172 NORTH ST. CLAND STREET
PAINESVILLE, OHIO 44871
PHONE 870-0444

NO.	DATE	BY
1		
2		
3		
4		
5		

AS BUILT CERTIFICATION
I HEREBY CERTIFY THAT THE CIRCLED GRADES ARE EXISTING FINISH GRADES CHECKED IN THE FIELD ON 19 AND ARE CORRECT TO THE BEST OF MY KNOWLEDGE AND BELIEF.

REGISTERED SURVEYOR

REG. NO.

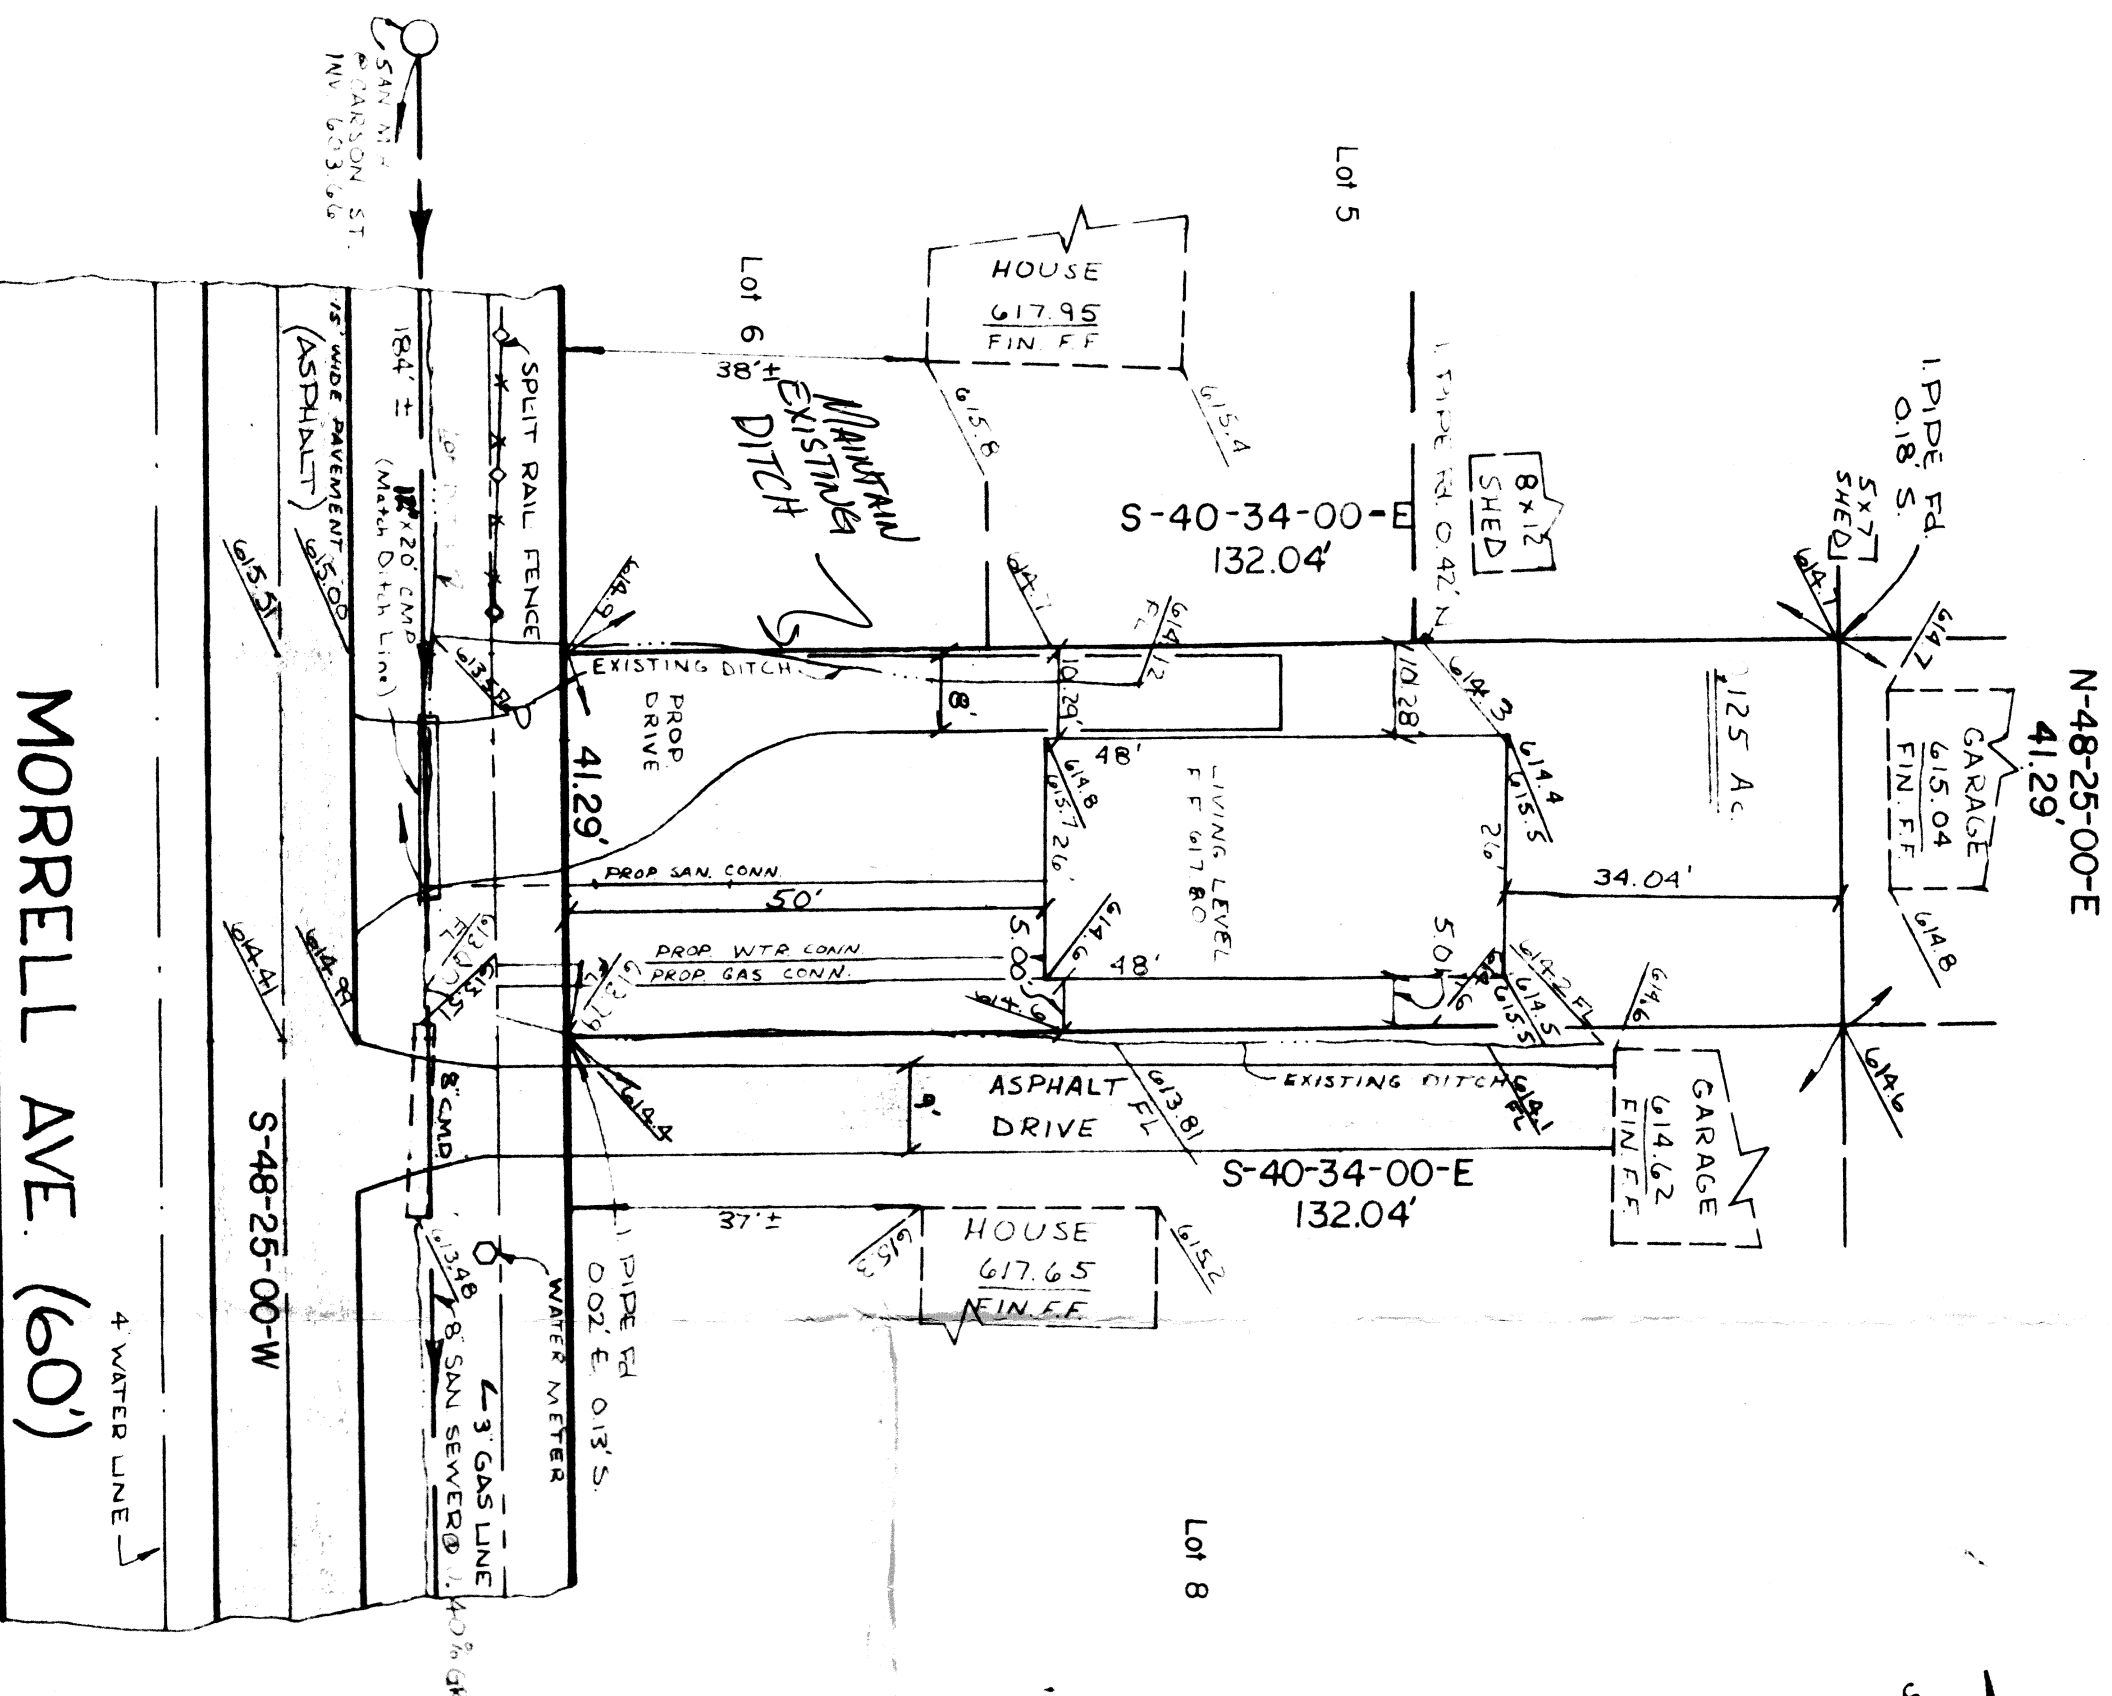

BENCHMARK
NAIL SET IN POLE IN FRONT
OF SUB LOT #7
ELEVATION 616.03

NOTE: LOT PRORATED BY BLOCK.
UNDERGROUND UTILITIES ARE
UNCONFIRMED AND SHOULD
BE VERIFIED BY CONTRACTOR
PRIOR TO DIGGING.

This Permit Expires
4-17-88

PAINESVILLE TOWNSHIP
ZONING APPROVED
6663

William E. McCallister
Zoning Inspector
4/17/87