


LEGEND:

- IRON PIN OR PIPE FOUND OR SET
EXISTING ELEVATION
PROPOSED ELEVATION
- PROPOSED FLOW
- T.B.M. ELEVATION 620.24
- TOP OF HYDRANT AT
- FINISH FLOOR 617.38 BSMT. FLOOR SLAB
- TOP FOOTER GARAGE FLOOR 616.69
- SAN. CONN. 610.5 ± STM. CONN.
- AS BUILT FINISH FLOOR
- AS BUILT GARAGE FLOOR
- AS BUILT BASEMENT FLOOR

PLOT PLAN FOR SUBLOT

PERMANENT PARCEL NO. 118-664-118
STREET ADDRESS MORRELL AVENUE
IN THE G.E. MEIGS RESERVEY BLOCK 122 SUBDIVISION 11.9
IN THE CITY OF PAINESVILLE TWP, LAKE COUNTY, OHIO
PREPARED FOR MARKEL CONSTRUCTION
DATE 3-24-2004 SCALE 1"=20'
AS BUILT DATE
AS BUILT ELEVATIONS
SIDEWALKS AND APRONS (6" THICK AT DRIVEWAYS)
PROPOSED SWALES
SCHADE SURVEYING COMPANY 951-6454
4043 ERIE ST. WILLIAMS, OHIO 308 No. 04-690
F8114

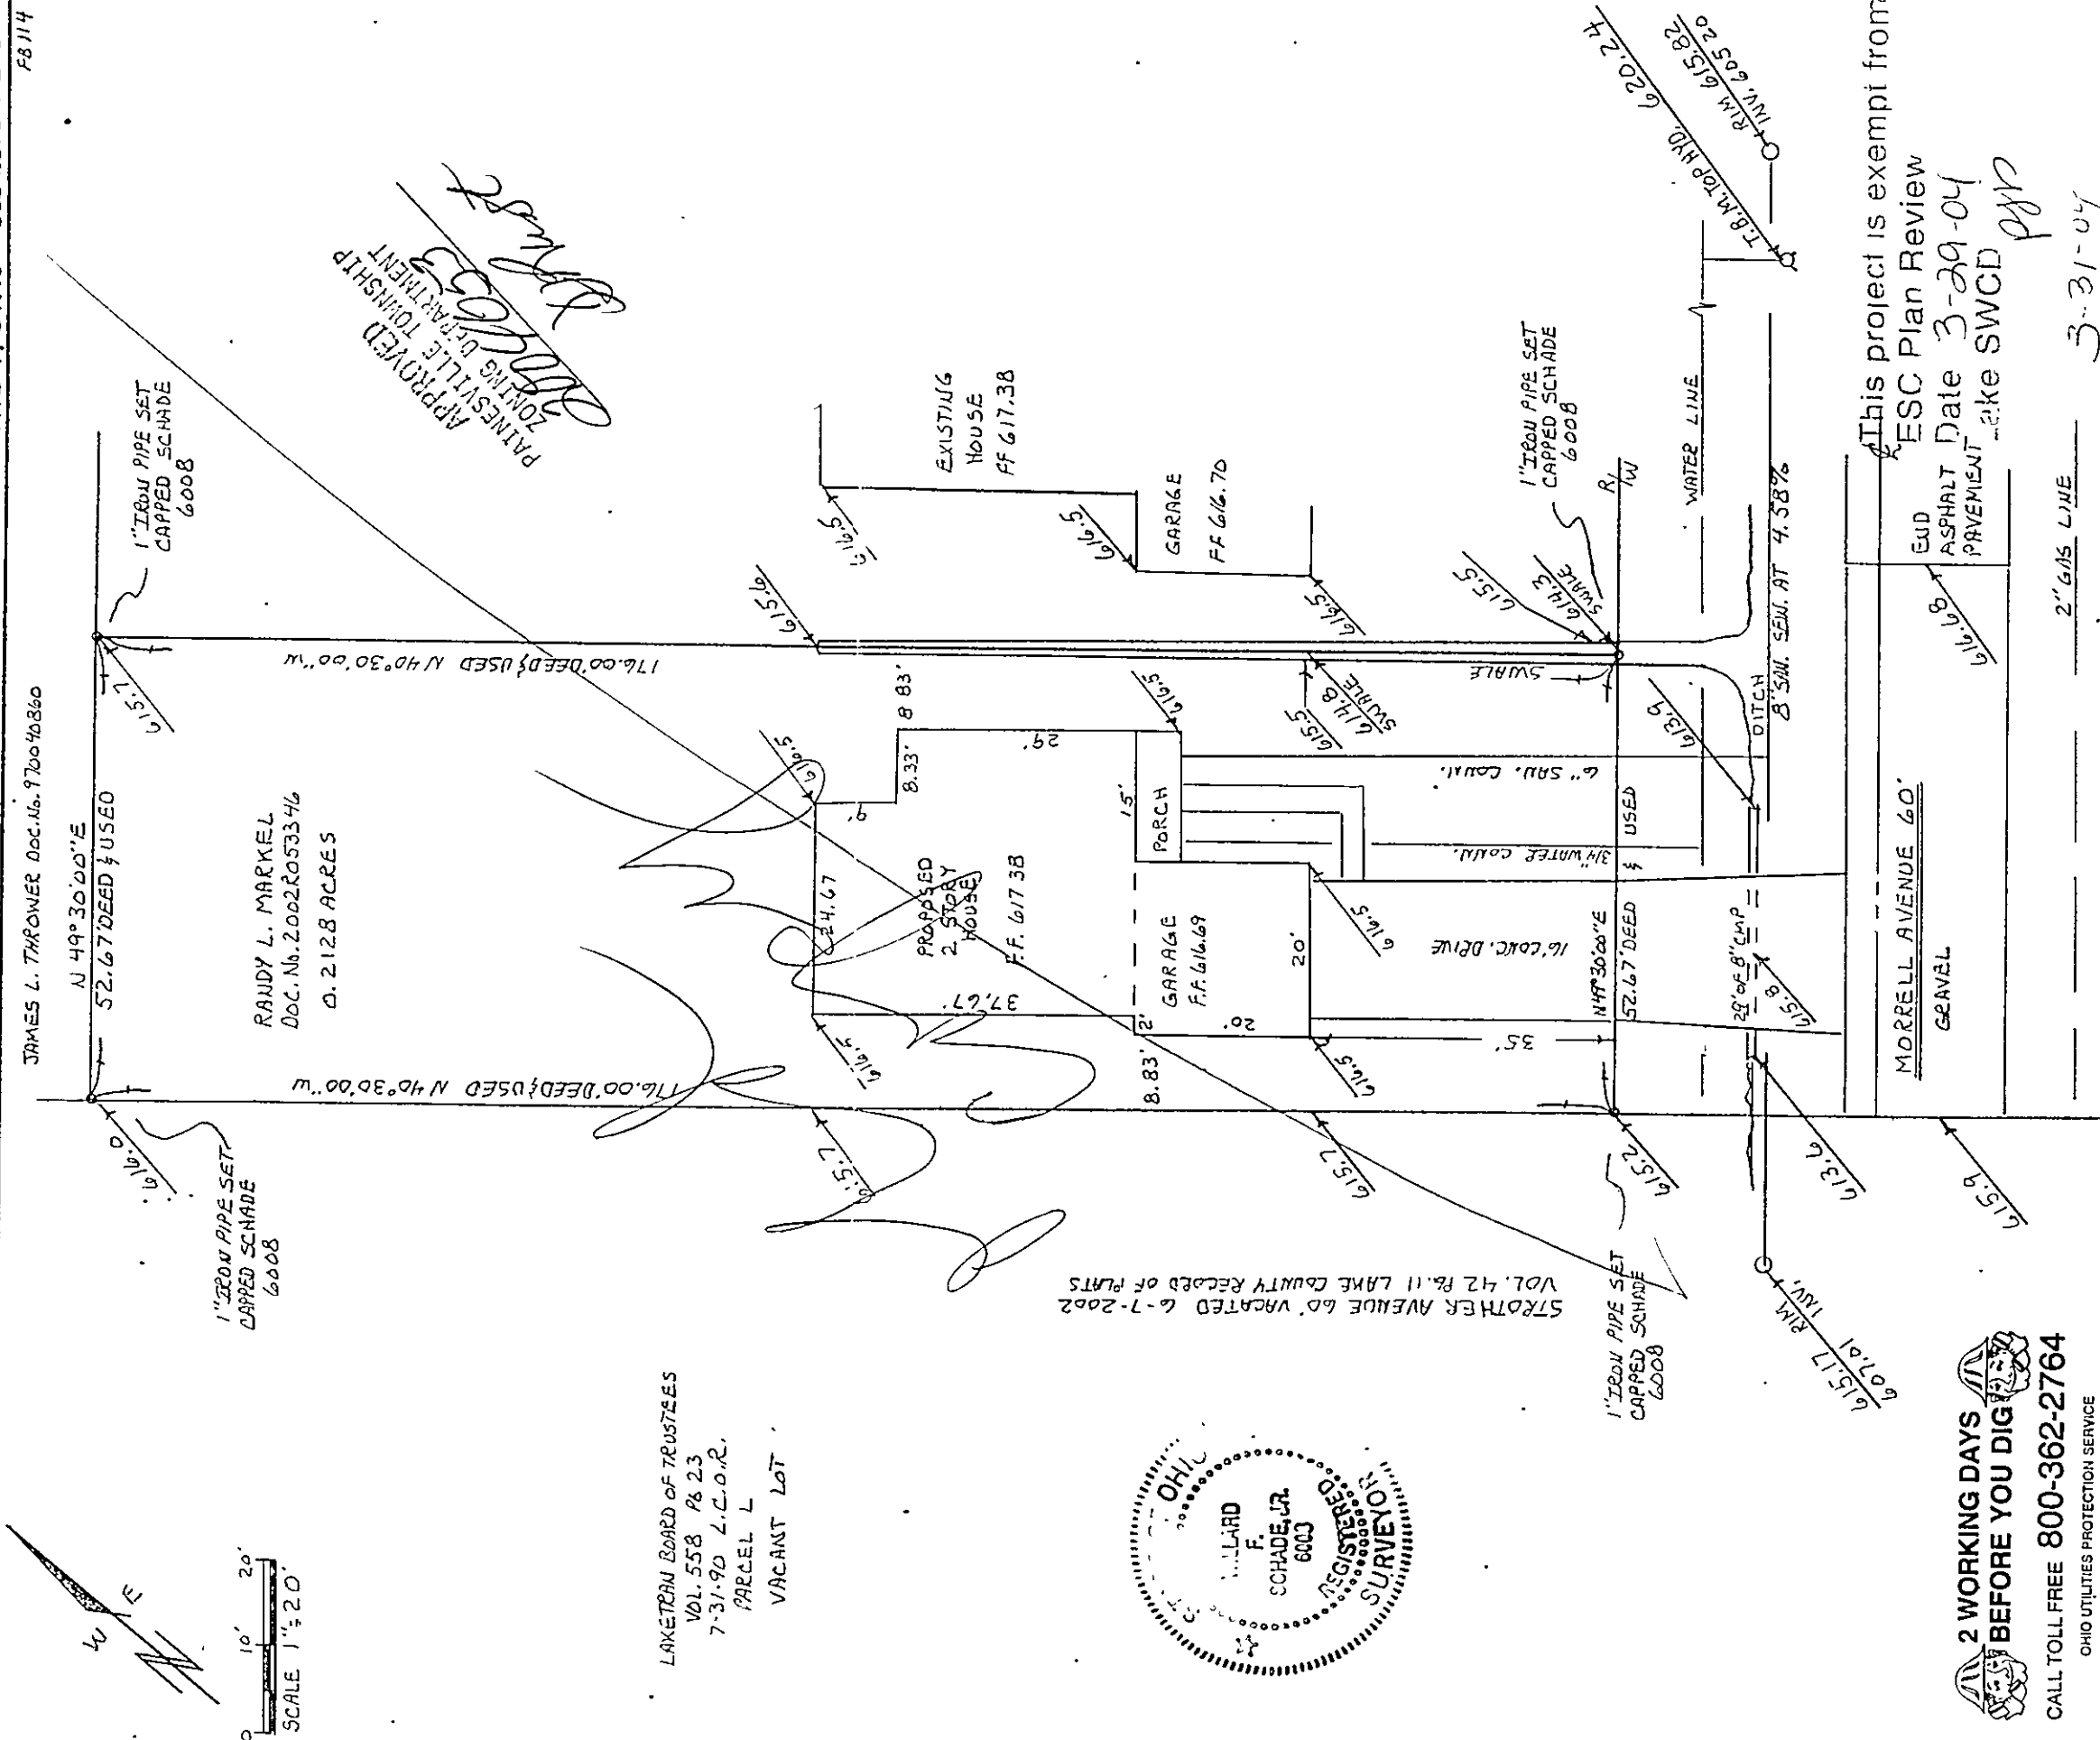

2 WORKING DAYS
BEFORE YOU DIG

CALL TOLL FREE 800-362-2764
OHIO UTILITIES PROTECTION SERVICE

CERTIFICATION: DIMENSIONS ARE EXPRESSED IN FEET AND DECIMAL PARTS THERE OF
MONUMENTS ARE AT POINTS SHOWN AND ARE CERTIFIED CORRECT

WILLARD F. SCHADE
WILLARD F. SCHADE
REG. SURVEYOR
6008