


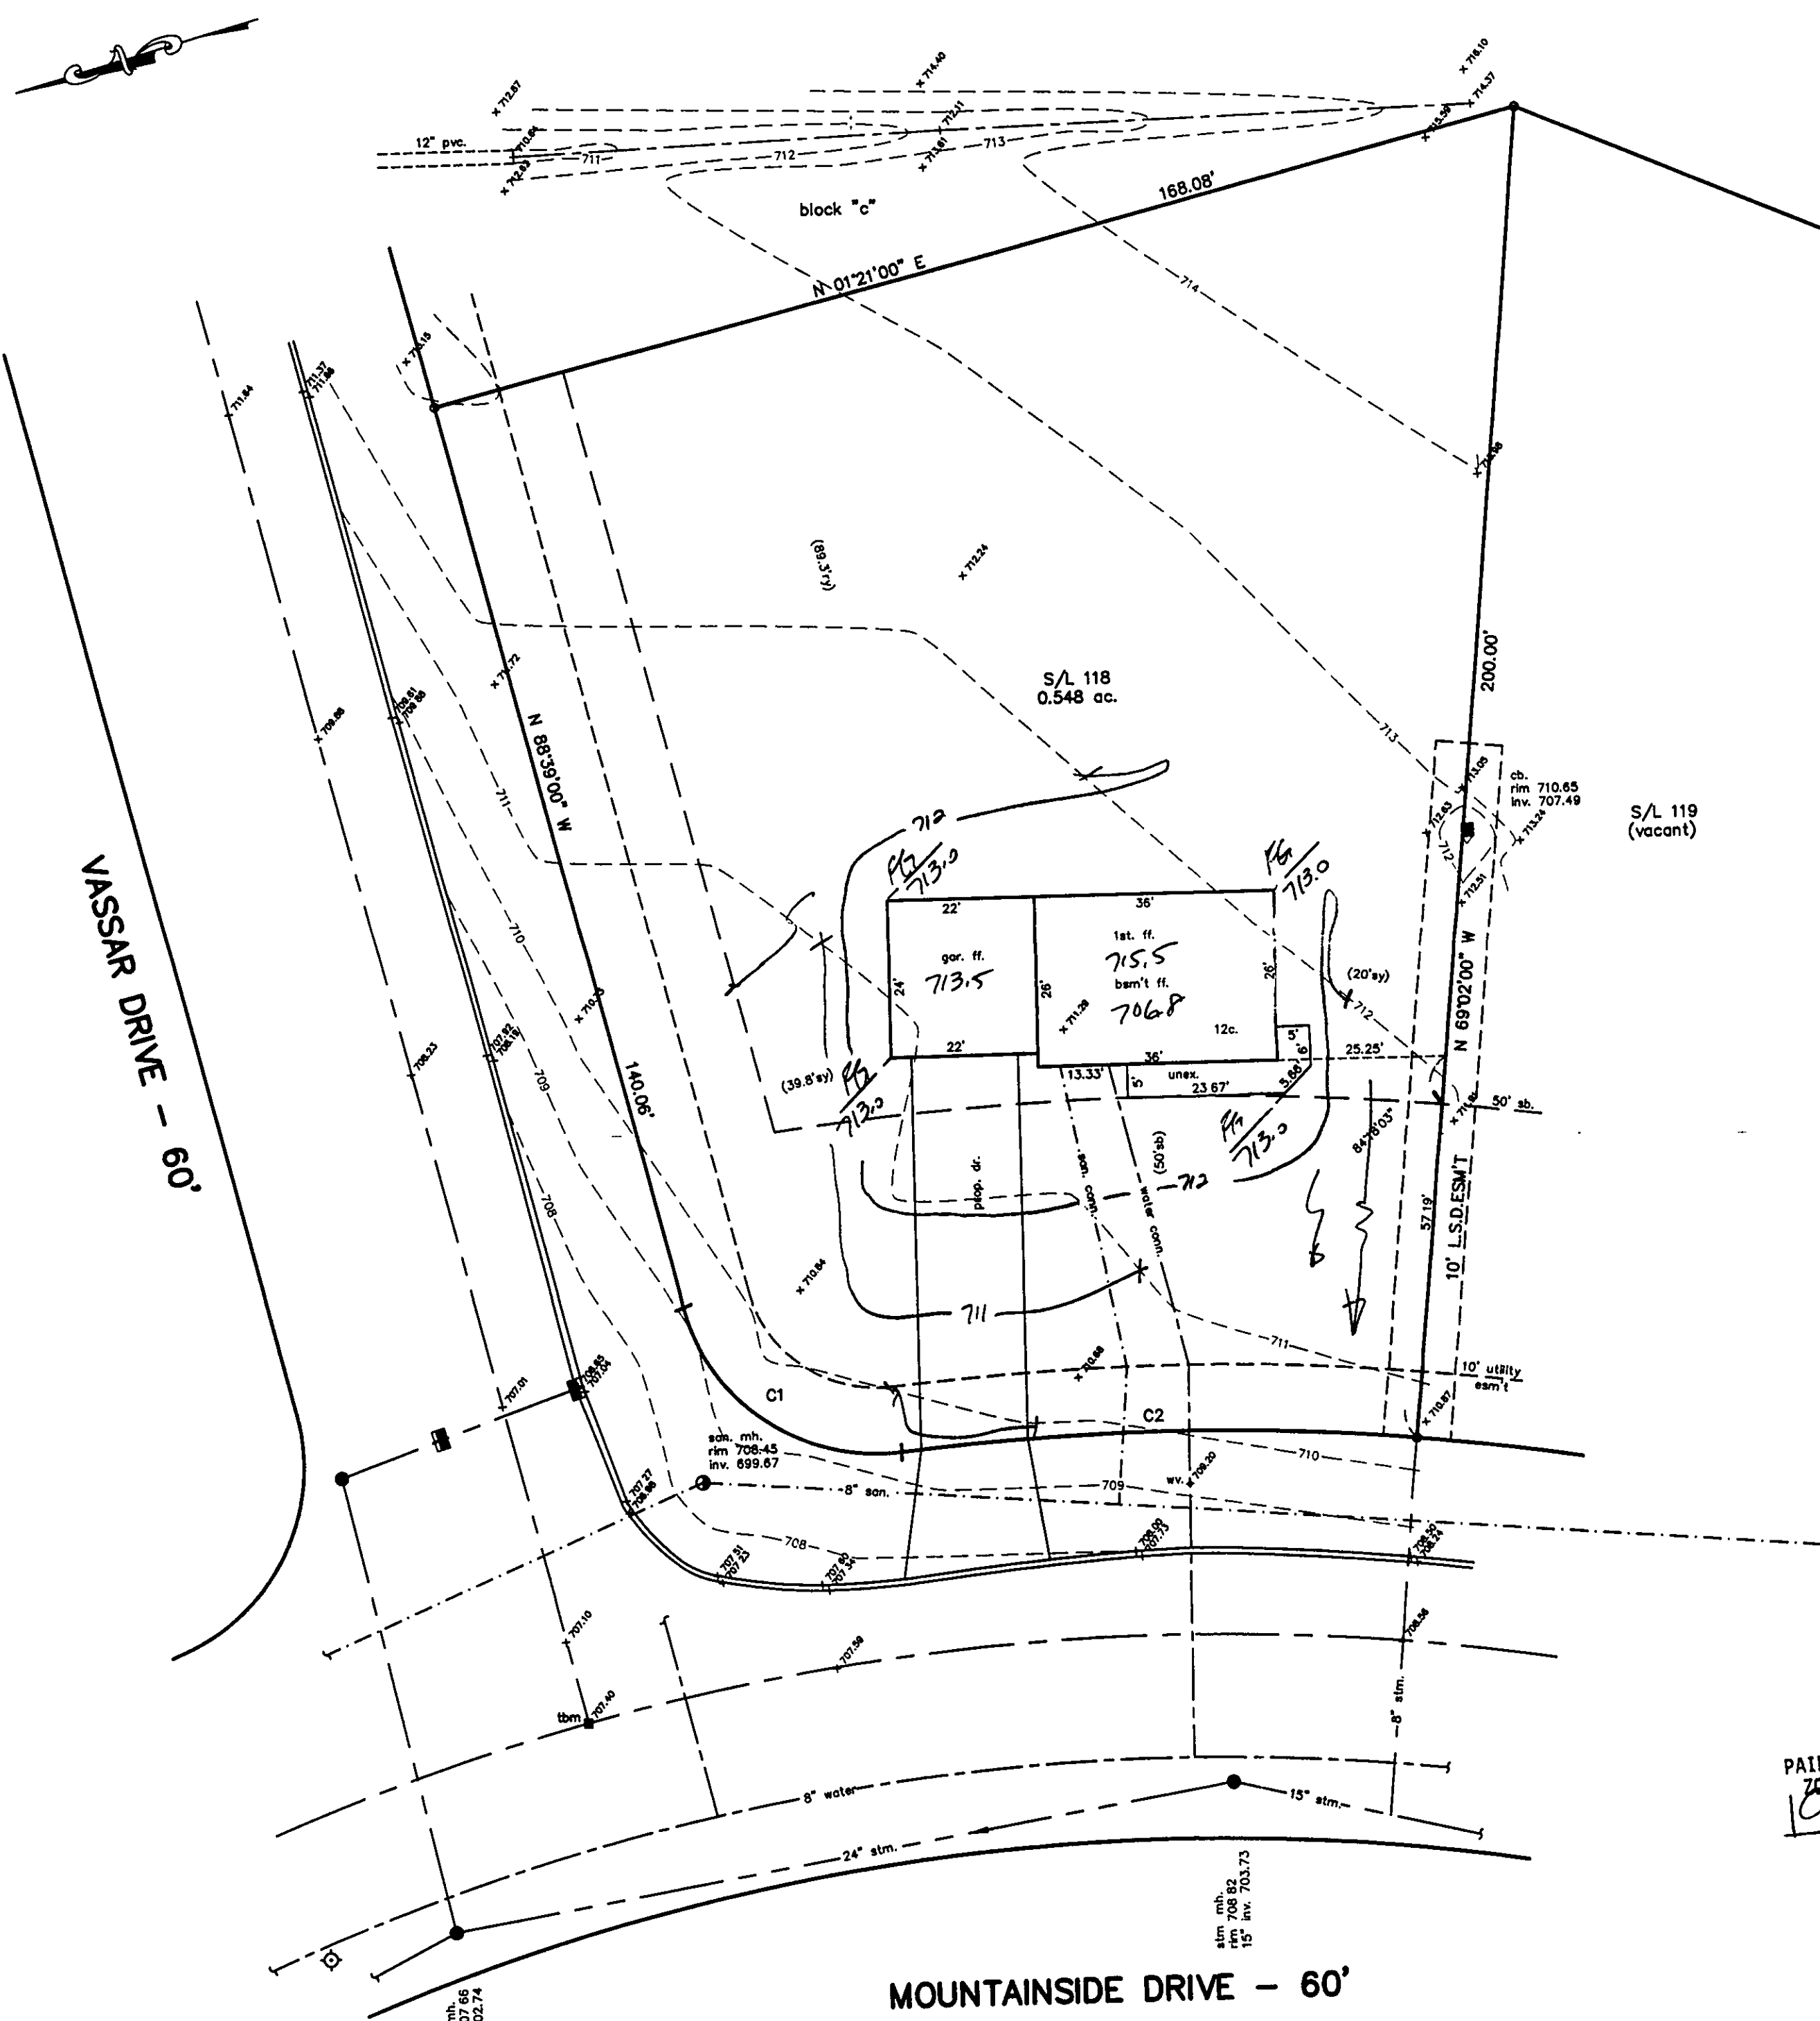

SITE PLAN

PAINESVILLE TWP., LAKE COUNTY, OHIO
for: MALKAMAKI BUILDERS

CLIENT		OWNER	
ADDRESS	STREET	CITY	ZIP
HEATHERSTONE #2		TRACT	STREET
SUBDIVISION 31-21	NAME	LOT	
118	VOL-PG. MOUNTAINSIDE DR.	VOL-PG.	PERM. PARCEL NO.
SUBLOT NO.	STREET		

LEGEND

SANITARY MANHOLE	---○---
STORM MANHOLE	---●---
INLET OR CATCH BASIN	---◇---
HYDRANT	---⊕---
EXISTING CONTOURS	---○---
PROPOSED CONTOURS	---○---

AS BUILT ELEVATION
INDICATES DIRECTION OF SURFACE DRAINAGE

REMARKS

ALL BOUNDARY DATA SHOWN WAS OBTAINED FROM (DEEDS, RECORDED SUBDIVISION PLAT OR OTHER PUBLIC RECORDS)

LOCATIONS AS SHOWN OF ADJACENT WELLS AND SEPTIC TANKS OBTAINED FROM LAKE COUNTY HEALTH DEPARTMENT

DESIGN CERTIFICATION

THIS PLAT WAS PREPARED BY ME, AND IS CORRECT TO THE BEST OF MY KNOWLEDGE AND BELIEF

Thomas P. Gilles #6313
NAME SURVEYOR REGISTRATION NO.

CHECK LIST

NO. OF BEDROOMS	WATER MAIN SIZE, LOCATION
DIMENSIONS	SAN. SEWER SIZE & OR. LOC.
BEARINGS	SAN. MH. CAST. ELEV. INV. ELEV.
TIE TO NEAREST STREET	SAN. CONN. SIZE, LOC. DEPTH
SUBLOT NO. PARCEL NO.	STORM SEWER SIZE & OR. LOC.
SURROUNDING OWNERS	STORM MH. CAST. ELEV. INV. ELEV.
BLDG. DIMENSIONS FIN GR.	PAVT TYPE GRADE CURBS
BLDG. TIES FLY. GRADES	GAS LINE LOC. SIZE PRESSURE
APRON TYPE WIDTH THICKNESS	SEPTIC TANK LOCATION & DUPLICATION AREA
SIDEWALK TYPE WIDTH THICKNESS	WELL LOCATION
CULVERT TYPE DIA. LENGTH	ISOLATION RADIUS FROM WELL
ROCK OUTCROPPINGS	

REVISIONS			PLAN PREPARED BY:	
NO.	DATE	BY	BABCOCK JONES & ASSOCIATES, INC.	
1			PAINESVILLE, OHIO	
2			DRAWN BY T.R.	SCALE 1"=20'
3			CHK'D. H.J.	DATE 4/10/99
4			APP'D K.J.	PHONE NO. 440-367-1811
5				DRAWING NO. 92-186-118

"AS BUILT" CERTIFICATION
I, HEREBY CERTIFY THAT THE CIRCLED GRADES ARE EXISTING
FINISH GRADES CHECKED IN THE FIELD ON 19____, 19____
AND ARE CORRECT TO THE BEST OF MY KNOWLEDGE AND BELIEF.

REGISTERED SURVEYOR	REG. NO.
son. mh. rim 708.45 inv. 699.67	C1: R=30.00' L=42.82' C=39.28' D=81°47'12" S50°27'24"W
son. mh. rim 711.32 inv. 700.45	C2: R=390.00' L=77.62' C=77.49' D=11°24'12" N15°15'54"E
TBM-IRON PIN MON. ELEV.=707.40	

APPROVED
PAINESVILLE TOWNSHIP
ZONING DEPARTMENT
19990104
D. Rust

Grading Plan Approved
as shown and/or noted
THOMAS P. GILLES, P.E.
Lake County Engineer
By *T. Jones* Date 5/1/99
swale as shown

