


Grading Plan Approved
as shown and/or noted
JAMES R. GILLS, P.E.
Lake County Engineer

By TAM Date 1/27/01
Lower F.G. AS NOTED
Swale to yard drain
Reference zoning permit #2001008

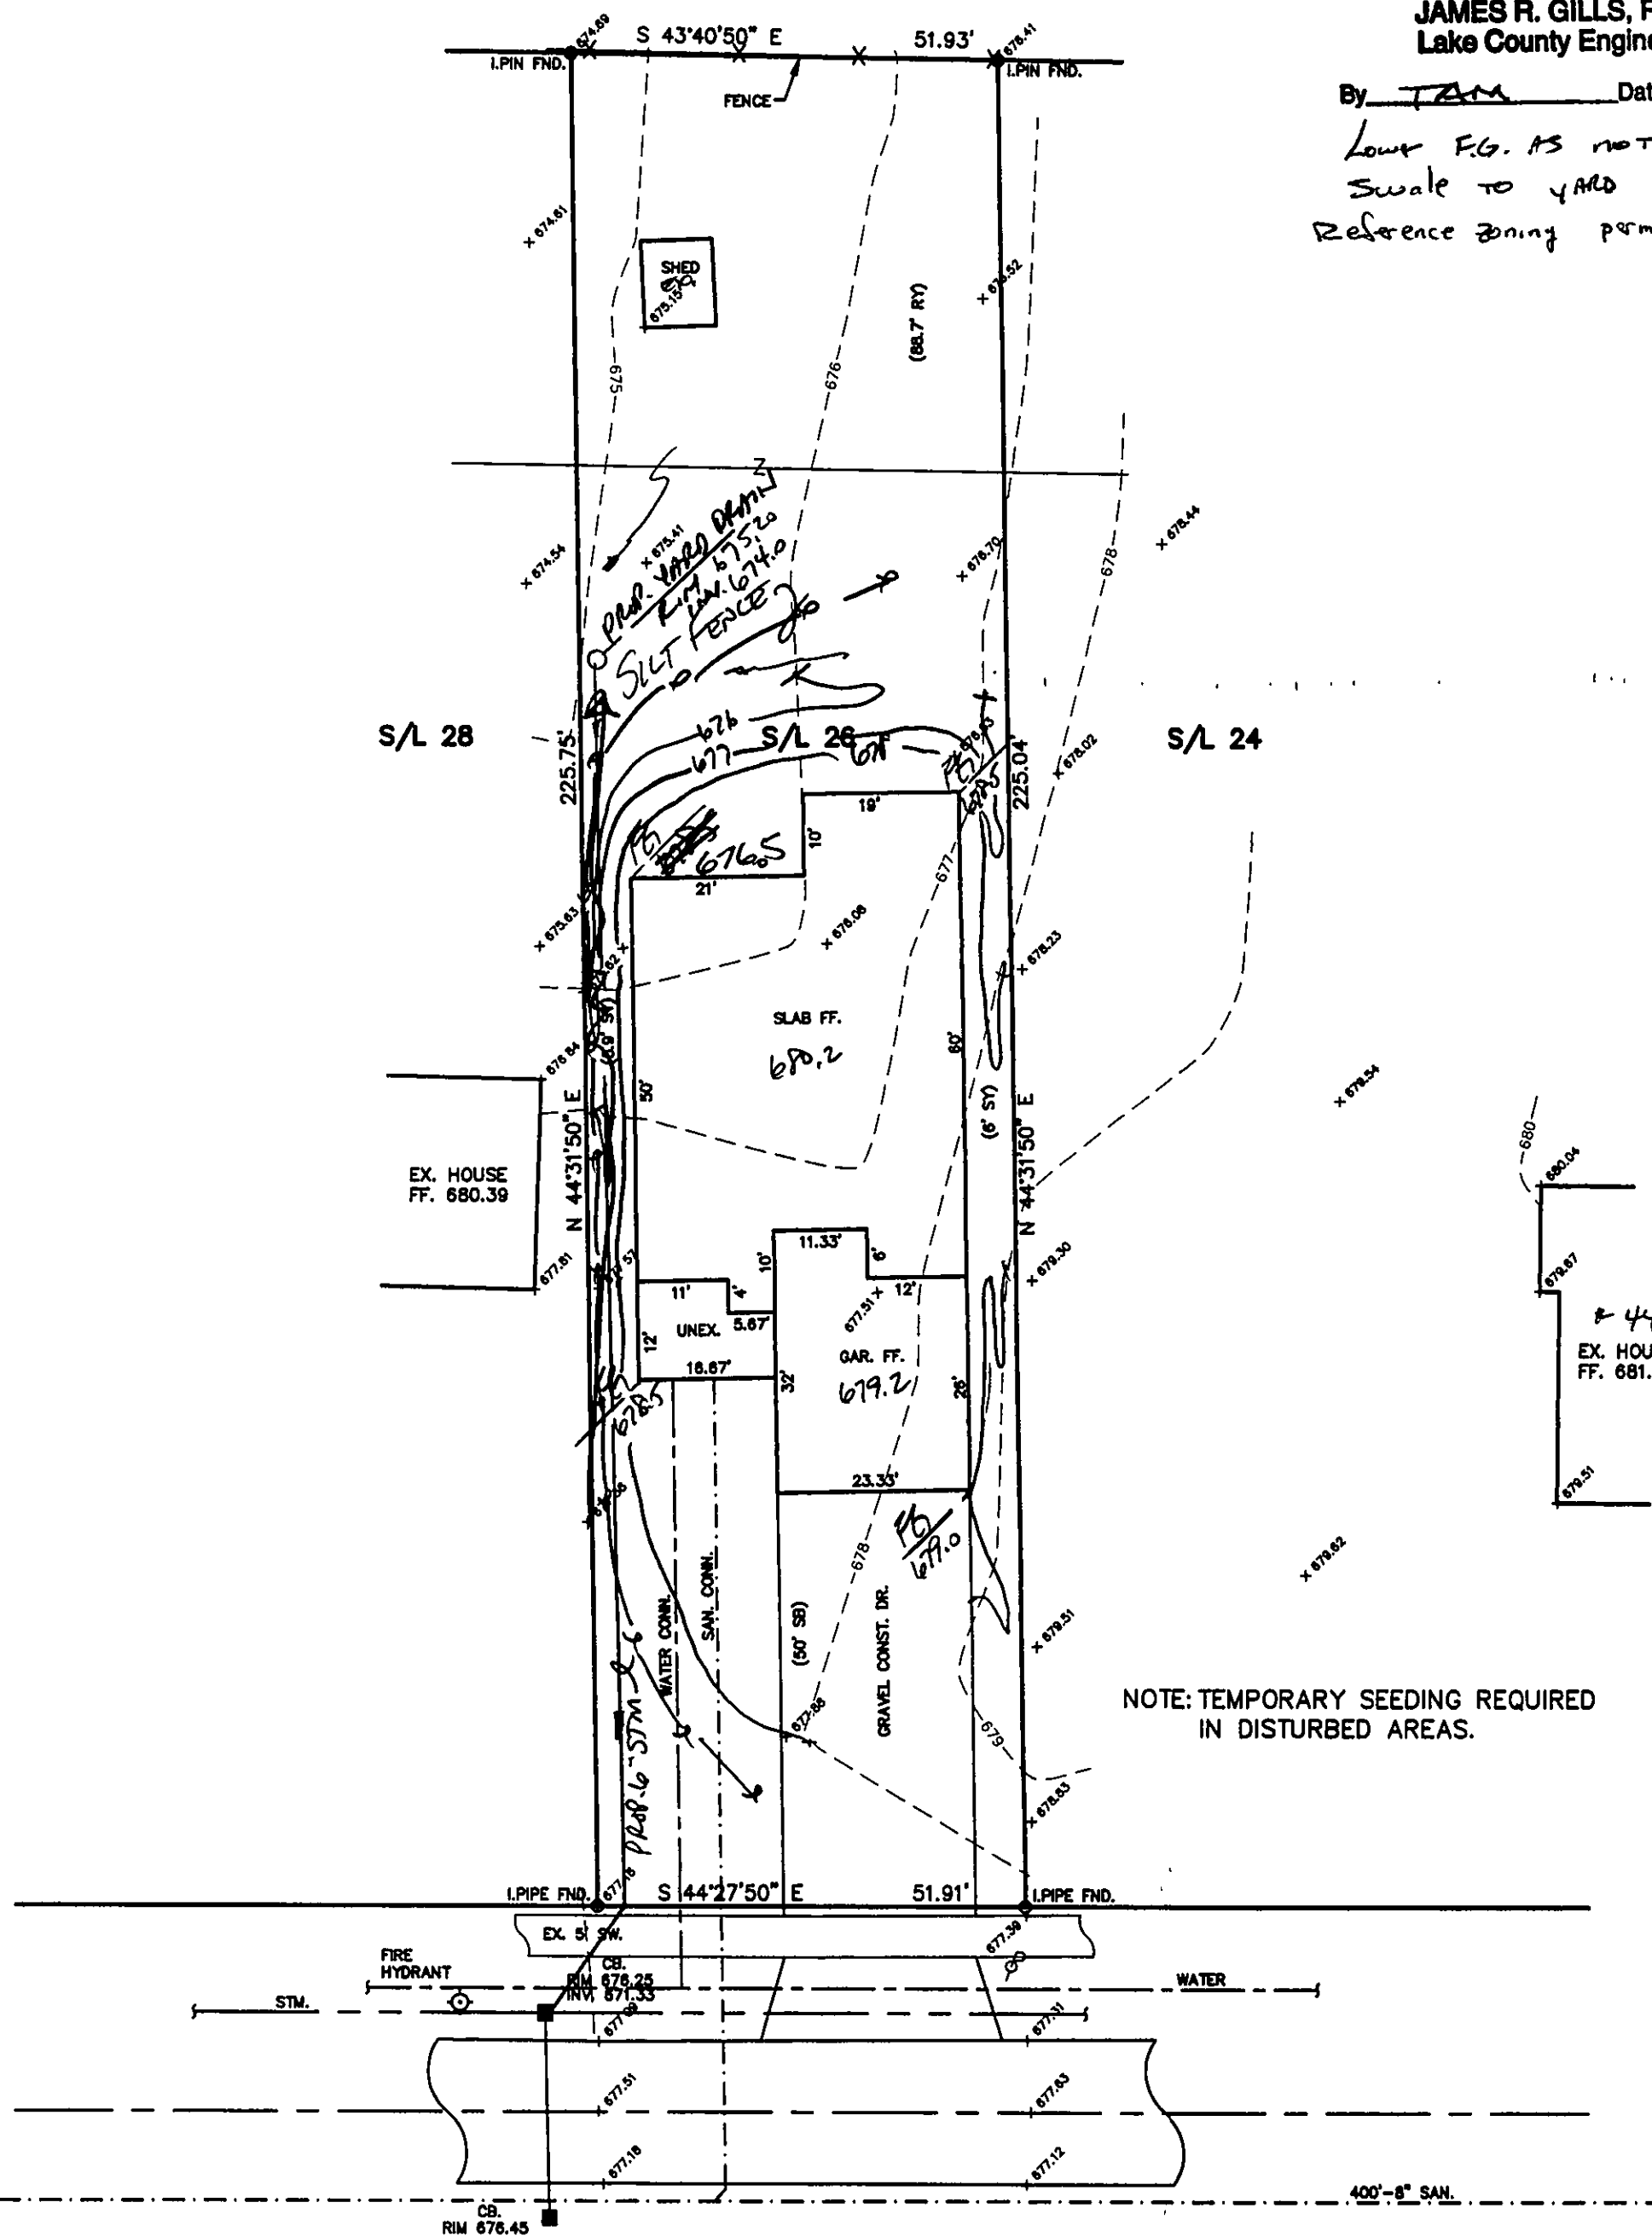

NOTE: TEMPORARY SEEDING REQUIRED
IN DISTURBED AREAS.

NORTH DOAN AVENUE - 50'

SITE PLAN

PAINESVILLE TWP., LAKE COUNTY, OHIO

for: MELISSA WEISS

CLIENT		OWNER	
ADDRESS	STREET	CITY	ZIP
DOAN AVE ALLOT.		TRACT	
SUBDIVISION	F-72	NAME	STREET
26	VOL-PG	LOT	STREET
SUBLOT NO.	STREET	VOL-PG	PERM. PARCEL NO.

LEGEND

SANITARY MANHOLE	---○---	EXIST. ELEV. - 100.0	PROP. ELEV.
STORM MANHOLE	---●---	100.0 ± 2	
INLET OR CATCH BASIN	---■---	AS BUILT ELEVATION	
HYDRANT	---⊙---	INDICATES	
EXISTING CONTOURS	---○---	DIRECTION OF	
PROPOSED CONTOURS	---○---	SURFACE DRAINAGE	

REMARKS

ALL BOUNDARY DATA SHOWN WAS OBTAINED FROM (DEEDS, RECORDED
SUBDIVISION PLAT OR OTHER PUBLIC RECORDS)

LOCATIONS AS SHOWN OF ADJACENT WELLS AND SEPTIC TANKS OBTAINED FROM
LAKE COUNTY HEALTH DEPARTMENT

DESIGN CERTIFICATION

THIS PLAT WAS PREPARED BY ME, AND IS CORRECT
TO THE BEST OF MY KNOWLEDGE AND BELIEF.

NAME Harry S. Jones, Jr. SURVEYOR REGISTRATION NO. 6343

CHECK LIST

NO. OF BEDROOMS	WATER MAIN SIZE, LOCATION
DIMENSIONS	SAN. SEWER SIZE & OR. LOC.
BEARINGS	SAN. MH. CAST. ELEV. INV. ELEV.
TIE TO NEAREST STREET	SAN. CONN. SIZE, LOC. DEPTH
SUBLOT NO. PARCEL NO.	STORM SEWER SIZE & OR. LOC.
SURROUNDING OWNERS	STORM MH. CAST. ELEV. INV. ELEV.
BLDG. DIMENSIONS FIN GR.	PAV'T TYPE GRADE CURBS
BLDG. TIES FL'R. GRADES	GAS LINE LOC. SIZE PRESSURE
APRON TYPE WIDTH THICKNESS	SEPTIC TANK LOCATION & DUPLICATION AREA
SIDEWALK TYPE WIDTH THICKNESS	WELL LOCATION
CULVERT TYPE DIA. LENGTH	ISOLATION RADIUS FROM WELL
ROCK OUTCROPPINGS	

REVISIONS			PLAN PREPARED BY:	
NO.	DATE	BY	BABCOCK JONES & ASSOCIATES, INC.	
1	1/29/01	TRT	PAINESVILLE, OHIO	
2			DRAWN BY T.R.	SCALE 1" = 20'
3			CHK'D. H.J.	DATE 1/21/01
4			CREW CHIEF K.J.	APP'D H.J.
5			PHONE NO. 440-357-1811	DRAWING NO. 01-005

"AS BUILT" CERTIFICATION
I, HEREBY CERTIFY THAT THE CIRCLED GRADES ARE EXISTING
FINISH GRADES CHECKED IN THE FIELD ON 1/21/01, 2001
AND ARE CORRECT TO THE BEST OF MY KNOWLEDGE AND BELIEF.

REGISTERED SURVEYOR

REG. NO.

SAN. MH.
RIM 675.97
INV. 666.76

SAN. MH.(BM)
RIM 676.61
INV. 669.16

