


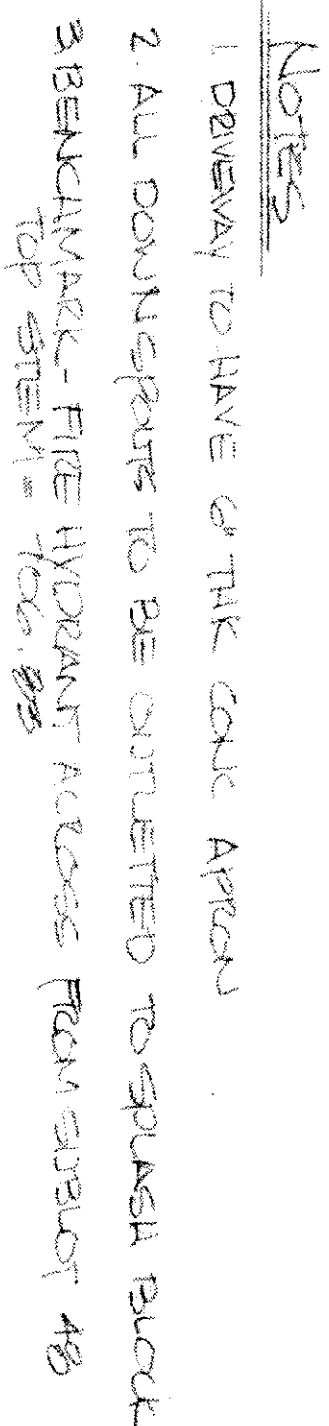

Grading Plan Approved  
as shown and/or noted  
THOMAS P. GILLES, P.E.  
Lake County Engineer  
G/H  
By \_\_\_\_\_ Date 3/6/19  
Discharge Sump pump to  
Storm Sewer.

THE PLAN IS PREPARED BY ME AND IS CORRECT  
TO THE BEST OF MY KNOWLEDGE.

Don't Monday P.S. "6820

| EXISTING CONTOURS<br>PROPOSED CONTOURS                                                | EXISTING ELEVATION<br>PROPOSED ELEVATION                                           | DIRECTION OF SURFACE DRAINAGE                                                         |
|---------------------------------------------------------------------------------------|------------------------------------------------------------------------------------|---------------------------------------------------------------------------------------|
|  | <div style="text-align: center;"> <div>100.00</div> <hr/> <div>100.00</div> </div> |  |

|                                               |                                 |
|-----------------------------------------------|---------------------------------|
| SITE: RAN - SUBLOT 4B NEUMAR DRIVE GO'        |                                 |
| MATERIAL: WOODS SUBDIVISION #2 RAINEVILLE TWP |                                 |
| SCALE: 1" = 20'                               | APPROVED BY: <i>[Signature]</i> |
| DATE: MAR. 8, 1980                            | DRAWN BY: D. NOVAK              |
| PREPARED BY: HINEBAUGH AND ASSOCIATES         |                                 |
| 38085 W. SPANGLING ST. WINDOGBAY ON 440914    |                                 |
| 216-246-1761                                  | DRAWING NUMBER: 90-016-48       |