

for SPEAR BUILDERS, INC. OWNER
CLIENT
7581 MIDDLE RIDGE RD. MADISON
ADDRESS STREET CITY

7581 MIDDLE RIDGE RD. MADISON.
ADDRESS STREET CITY

59	IMPERIAL WOODS	SUBDIVISION NO. 2	X	45
SUBLOT NO.	SUBDIVISION NAME		VOL.	PAGE
20 & 28, 1	PAINESVILLE TOWNSHIP			
LOT, TRACT			OHIO	

ALL BOUNDARY DATA SHOWN WAS OBTAINED FROM (DEEDS, RECORDED SUBDIVISION PLAT OR OTHER PUBLIC RECORDS). LOCATIONS AS SHOWN OF ADJACENT WELLS AND SEPTIC TANKS OBTAINED FROM LAKE COUNTY HEALTH DEPARTMENT.

SANITARY MANHOLE — — — — —
 PROPOSED CONTOURS —————
 EXIST. ELEV. → 100.0
 100.0 → PROP. ELEV.


WATER VALVE (GAS) — — — — —
 DIRECTION OF
 SURFACE DRAINAGE

NO. OF BEDROOMS
DIMENSIONS
BEARINGS
TIE TO NEAREST STREET
SUBLOT NO. PARCEL NO.
SURROUNDING OWNERS
BLDG. DIMENSIONS FIN. GR.
BLDG. TIES FL. R. GRADES
APRON TYPE WIDTH THICKNESS
SIDEWALK TYPE WIDTH THICKNESS
CURVERT TYPE DIA. LENGTH
ROCK OUTCROPPINGS
WATER MAIN SIZE, LOCATION
SAN. SEWER SIZE & GR. LOC.
SAN. MAN. CAST. ELEV. IN. ELEV.
SAN. CONN. SIZE, LOC. DEPTH
STORM SEWER SIZE & GR. LOC.
STORM MAN. CAST ELEV. INV. ELEV.
PAV'T TYPE GRADE CURVES
GAS LINE LOC. SIZE PRESSURE
SEPTIC TANK, LOCATION &
DUPLICATION AREA
WELL LOCATION
ISOLATION RADIOS FROM WELL

THIS PLAT WAS PREPARED BY ME, AND IS CORRECT TO THE
BEST OF MY KNOWLEDGE AND BELIEF. D⁵ 103-

NAME John SURVEYOR REGISTRATION NO. 168

I HEREBY CERTIFY THAT THE CIRCLED GRADES ARE EXISTING GRADES OBTAINED ON THE SITE ON _____, 19____, AND ARE CORRECT TO THE BEST OF MY KNOWLEDGE AND BELIEF.

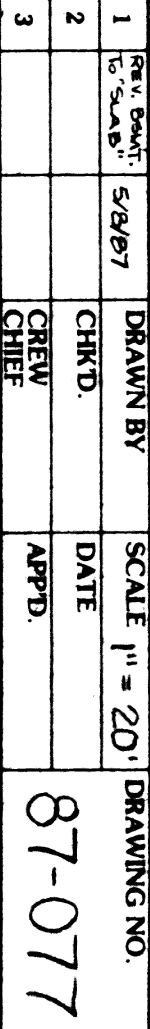

BENCHMARK: SANITARY MANHOLE WEST OF
WEST PROPERTY LINE
RIM ELEVATION 704.66

Wilder E. Messenger
Zoning Inspector

