

[illegible]

DEANMENT

7400 0000
M3 = 704700 (EX 57)
M4 = 70300 (EX 57)

5/14/44

Propose	General
House	A.F.
Fin. Sec.	707.50
709.50	

~~STORM SEWER BASEMENT.~~

Harold House
P.O. Box
70950
Carmel, Spence

2000 = 1000
 2000 = 1000
 2000 = 1000

This Permit Expires
1-6-93
PAINESVILLE TOWNSHIP
ZONING APPROVED
#8002

STM NF
RIM = 705.80
INV = 700.84

NELMAZ DRIVE 60

[illegible]

20131A

7-46
10007

7511

1. DRIVEWAY ~~AND~~ HAVE A TAX APPLZON

2 ALL DOWNPOINTS TO BE CULLETED TO SPLASH BLOCKS

3. S&P PRAP NEGATED FOR BASEMENT

4. PENULTIMATE - TOP FIBRE IN DBT - ACROSS FROM
SUBLOT 45. TOP STEM # 70921

EXISTING CONTROL
PROPOSED CONTROL


EXISTING ELEVATION
PROPOSED ELEVATION

SECTION OF SURFACE DRAINAGE

Grading Plan Approved
as shown and/or noted
THOMAS P. GILLEN, P.E.
Leiko County Engineer
(1)14
Date 10/8/92

THIS PLAN WAS PREPARED BY ME AND IS CORRECT
TO THE BEST OF MY KNOWLEDGE

Post No. 125 26820

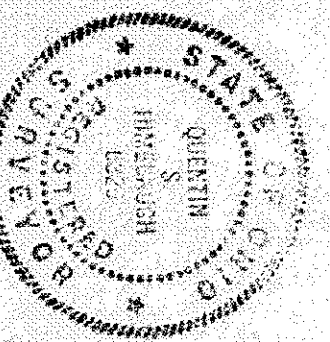

SITE PLAN SUB OF 45 NELMAR DRIVE
IMPERIAL WOODS SUB. N#2 PAINESVILLE TWP OH
SCALE: 1/2" = 20' APPROVED BY: *[Signature]* DRAWN BY: RICHARD
DATE: 11-29-90 *[Signature]* Rev. 12-20-91
PLAN PREPARED BY: HIMEBROUGH AND ASSOCIATES
380083 W. SPALDING ST WILLIAMS OH 44094
216-246-1761 90-016-45
DRAWING NUMBER