

SITE PLAN
 PAINESVILLE TOWNSHIP, LAKE COUNTY, OHIO
 for: LINDY SUNDBERG
 CLIENT OWNER

ADDRESS _____ STREET _____ CITY _____ ZIP _____

LOT _____ TRACT _____
 VOLUME _____ PAGE _____
 PERM. PARCEL NO. _____ STREET _____

SUBLOT NO. 41 SUB. NAME WELMAR ST

LEGEND

○ WATER VALVE (GAS)
 ○ WATER METER (GAS)
 ○ AS BUILT ELEVATION
 --- INDICATES DIRECTION OF SURFACE DRAINAGE
 ○ SANITARY MANHOLE
 ○ STORM MANHOLE
 ○ INLET OR CATCH BASIN
 ○ HYDRANT
 ○ EXISTING CONTOURS
 ○ PROPOSED CONTOURS
 ○ EXIST. ELEV. 100.0 PROP. ELEV. 100.0

REMARKS

ALL BOUNDARY DATA SHOWN WAS OBTAINED FROM (DEEDS, RECORDED SUBDIVISION PLAT OR OTHER PUBLIC RECORDS)

LOCATIONS AS SHOWN OF ADJACENT WELLS AND SEPTIC TANKS OBTAINED FROM LAKE COUNTY HEALTH DEPARTMENT

DESIGN CERTIFICATION

THIS PLAT WAS PREPARED BY ME, AND IS CORRECT TO THE BEST OF MY KNOWLEDGE AND BELIEF.

NAME HARRY S. JONES, JR. SURVEYOR REGISTRATION NO. 5-6343

CHECK LIST

NO. OF BEDROOMS _____ DIMENSIONS _____ WATER MAIN SIZE & GR. LOC. _____ SAN. SEWER SIZE & GR. LOC. _____ SAN. MH. CAST. ELEV. INV. ELEV. _____ SAN. CONN. SIZE, LOC. DEPTH _____ STORM SEWER SIZE & GR. LOC. _____ STORM MH. CAST ELEV. INV. ELEV. _____ PAVT TYPE GRADE CURBS _____ GAS LINE LOC. SIZE PRESSURE _____ SEPTIC TANK LOCATION & DUPLICATION AREA _____ WELL LOCATION _____ ISOLATION RADIUS FROM WELL _____

REVISIONS

NO.	DATE	BY
1		
2		
3		
4		
5		

PLAN PREPARED BY: **BABCOCK • JONES & ASSOCIATES, INC.**
 PAINESVILLE, OHIO


DRAWN BY D.L. SCALE 1" = 20' PHONE NO. 357-1811
 CHK'D. CC. DATE 3-5-90 DRAWING NO. _____
 APP'D. CC. APPD. NO. 90-038-41

"AS BUILT" CERTIFICATION

I, HEREBY CERTIFY THAT THE CIRCLED GRADES ARE EXISTING FINISH GRADES CHECKED IN THE FIELD ON _____ 19 _____ AND ARE CORRECT TO THE BEST OF MY KNOWLEDGE AND BELIEF.

REGISTERED SURVEYOR _____ REG. NO. _____
 B.M.; SAN. MH. RUM ELEV. = 706.58

This Permit Expires 3/2/91
 PAINESVILLE TOWNSHIP ZONING APPROVED
 # 7435
 Zoning Inspector

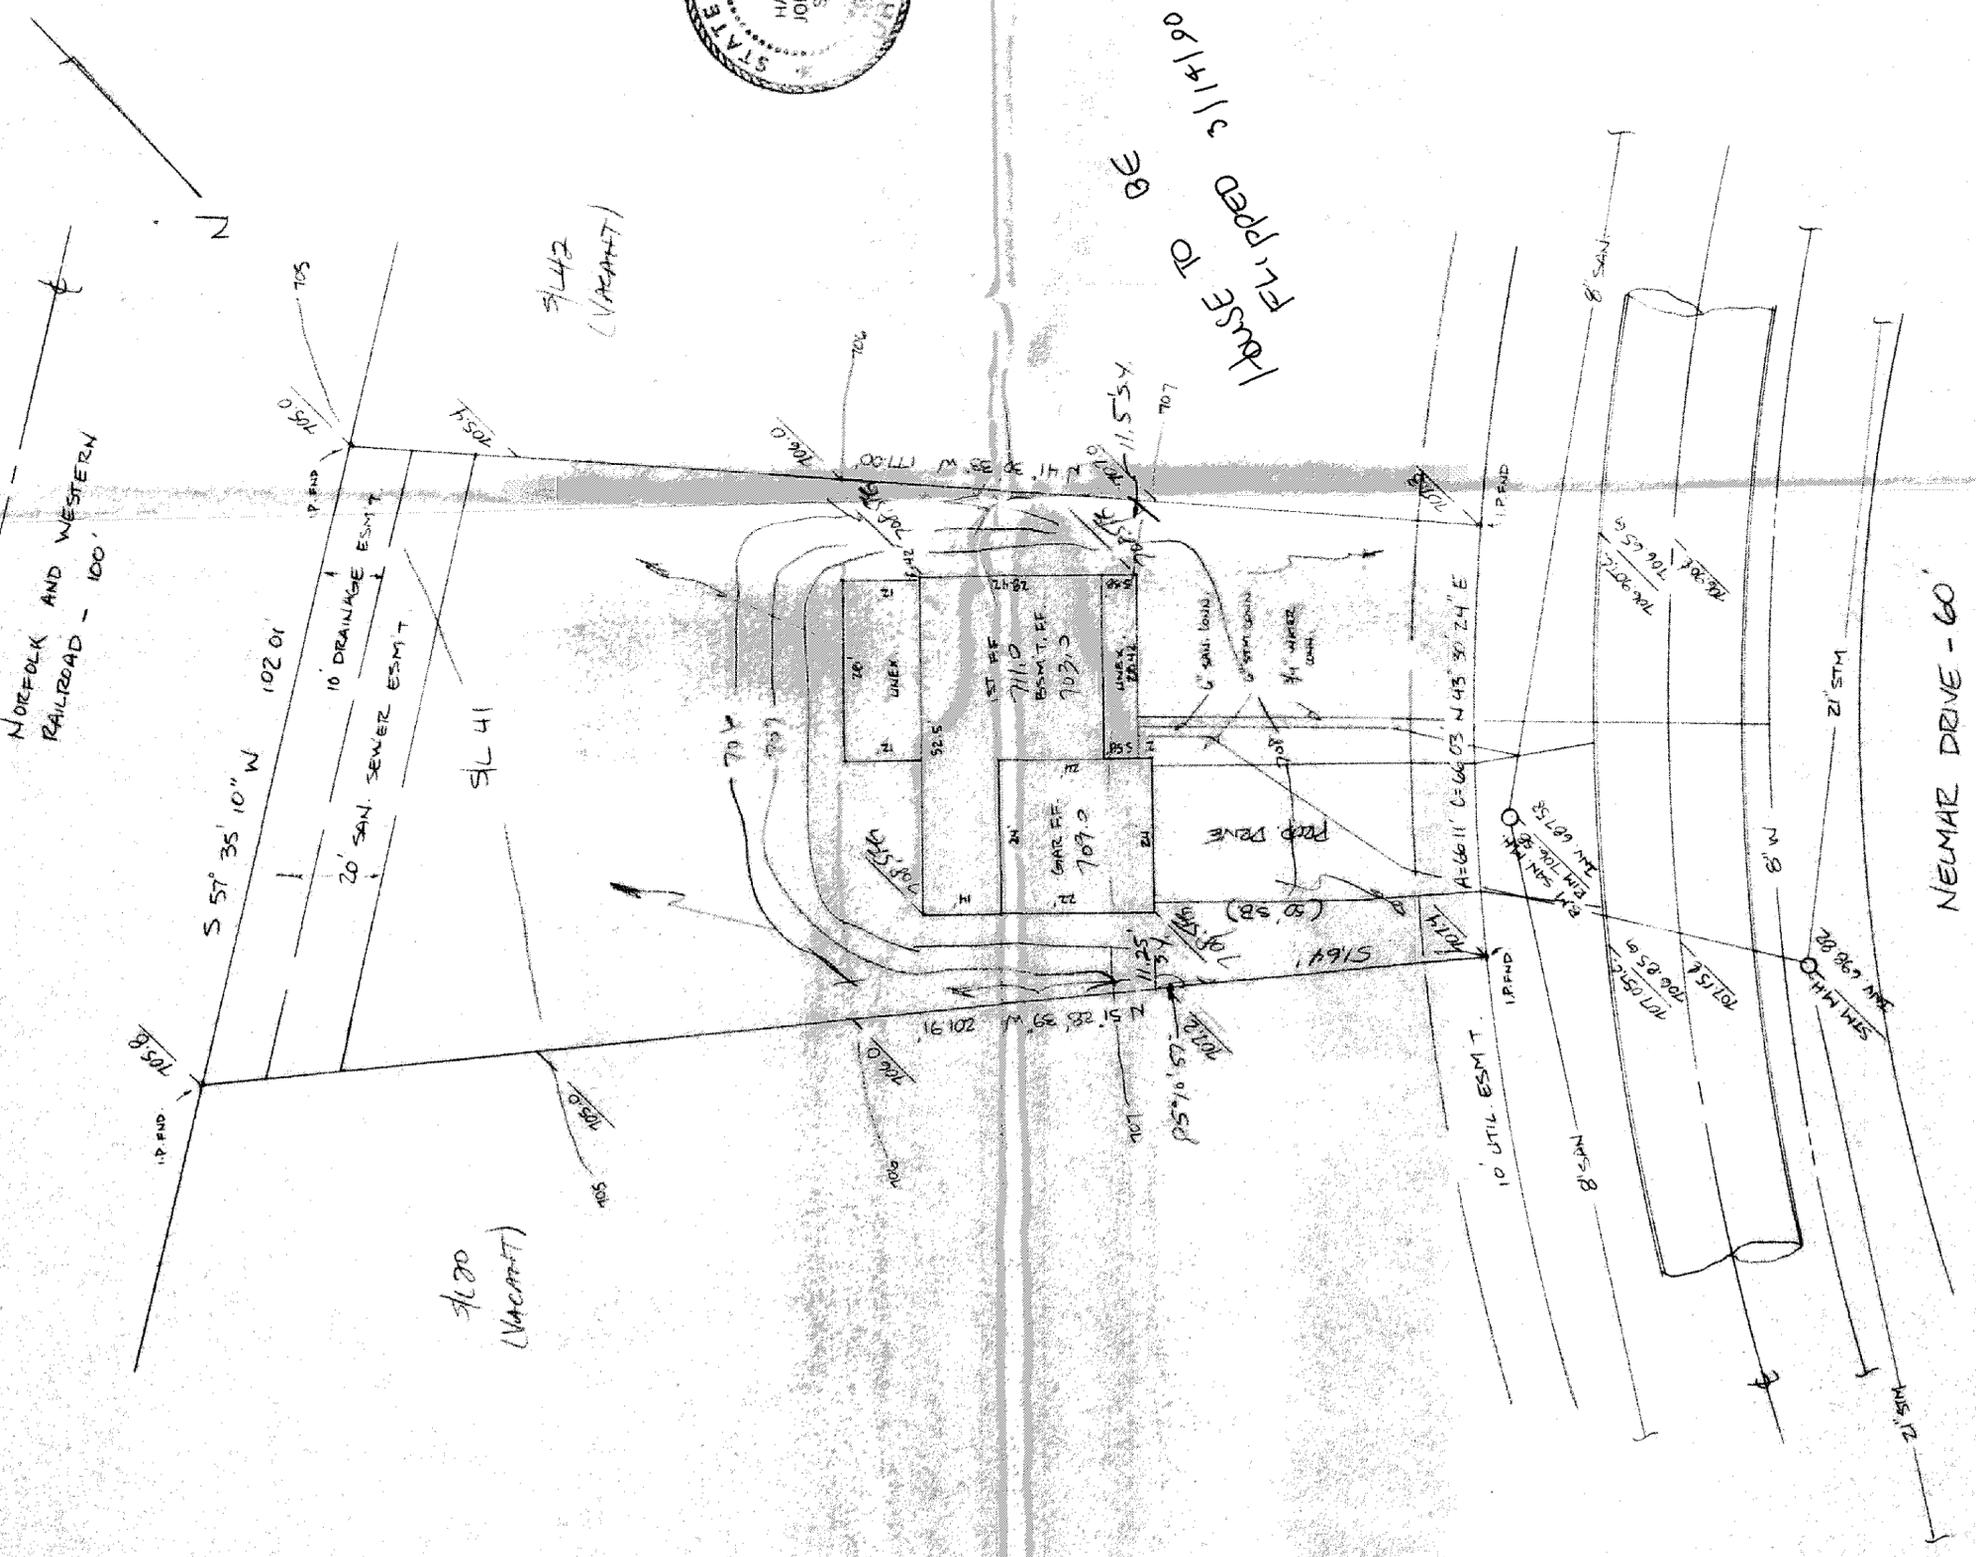

NEUMAR DRIVE - 60'