

SITE PLAN

PAINESVILLE TOWNSHIP LAKE COUNTY, OHIO

for: LAY HONES

OWNER

ADDRESS

STREET

CITY

ZIP

IMPERIAL WOODS SUB.
SUBDIVISION 1-24 NAME
25 VOL. 116
SUBLOT NO. 25 NEUMAR DE
STREET

LOT
VOLUME
PERM. PARCEL NO.
TRACT
PAGE
SHEET

LEGEND

SEWERY MANHOLE
STORM MANHOLE
INLET OR CATCH BASIN
HYDRANT
EXISTING CONTOURS
PROPOSED CONTOURS
EXIST. ELEV.
PROP. ELEV.
WATER VALVE (GAS)
WATER METER (GAS)
AS BUILT ELEVATION
INDICATES
DIRECTION OF
SURFACE DRAINAGE

REMARKS

ALL BOUNDARY DATA SHOWN WAS OBTAINED FROM IDEES, RECORDED
SUBDIVISION PLAT OR OTHER PUBLIC RECORDS
LOCATIONS AS SHOWN OF ADJACENT WELLS AND SEPTIC TANKS OBTAINED FROM
LAKE COUNTY HEALTH DEPARTMENT

DESIGN CERTIFICATION

THIS PLAT WAS PREPARED BY ME, AND IS CORRECT
TO THE BEST OF MY KNOWLEDGE AND BELIEF.

NAME

SURVEYOR

REGISTRATION NO.

CHECK LIST

NO. OF BEDROOMS
DIMENSIONS
TIE TO NEAREST STREET
SUBLOT NO. PARCEL NO.
SURROUNDING OWNERS
BLDG. DIMENSIONS FIN. OR
BLDG. TIES E.L.V., GRADARS
BLDG. TIES W.D.W. THICKNESS
CULVERT TYPE DIA., LENGTH
ROCK OUTCROPPINGS
WATER MAIN SIZE, LOCATION
SAN. SEWER SIZE & OR LOC.
SAN. MH. CAST ELEV. INV. ELEV.
SAN. CORR. SIZE, LOC. DEPTH
STORM SEWER CAST ELEV. INV. ELEV.
STORM SEWER CORR. SIZE, PRESSURE
SEPTIC TANK LOCATION & DUPLICATION AREA
WELL LOCATION
ISOLATION RADII FROM WELL

REVISIONS

NO.	DATE	BY	PLAN PREPARED BY:	SCALE	PHONE NO.
1	7/7/82	HD	BABCOCK • JONES & ASSOCIATES, INC.	1" = 20'	357-1811
2					
3					
4					
5					

"AS BUILT" CERTIFICATION

I, HEREBY CERTIFY THAT THE CIRCLED GRADES ARE EXISTING
FINISH GRADES CHECKED IN THE FIELD ON 19
AND ARE CORRECT TO THE BEST OF MY KNOWLEDGE AND BELIEF.

REGISTERED SURVEYOR

REG. NO.


T.B.M.: 21" STM M.H. S/L 28, ELEV = 704.50

Grading Plan Approved
as shown and/or noted
THOMAS P. GILLES, P.E.
Lake County Engineer

By GJH

Date 11/18/90

1. CONNECT SUMP PUMP TO 6" STORM SERVICE.
2. DOWN SPOOTS TO SPLASH BLOCKS.
3. GRADE AS INDICATED.

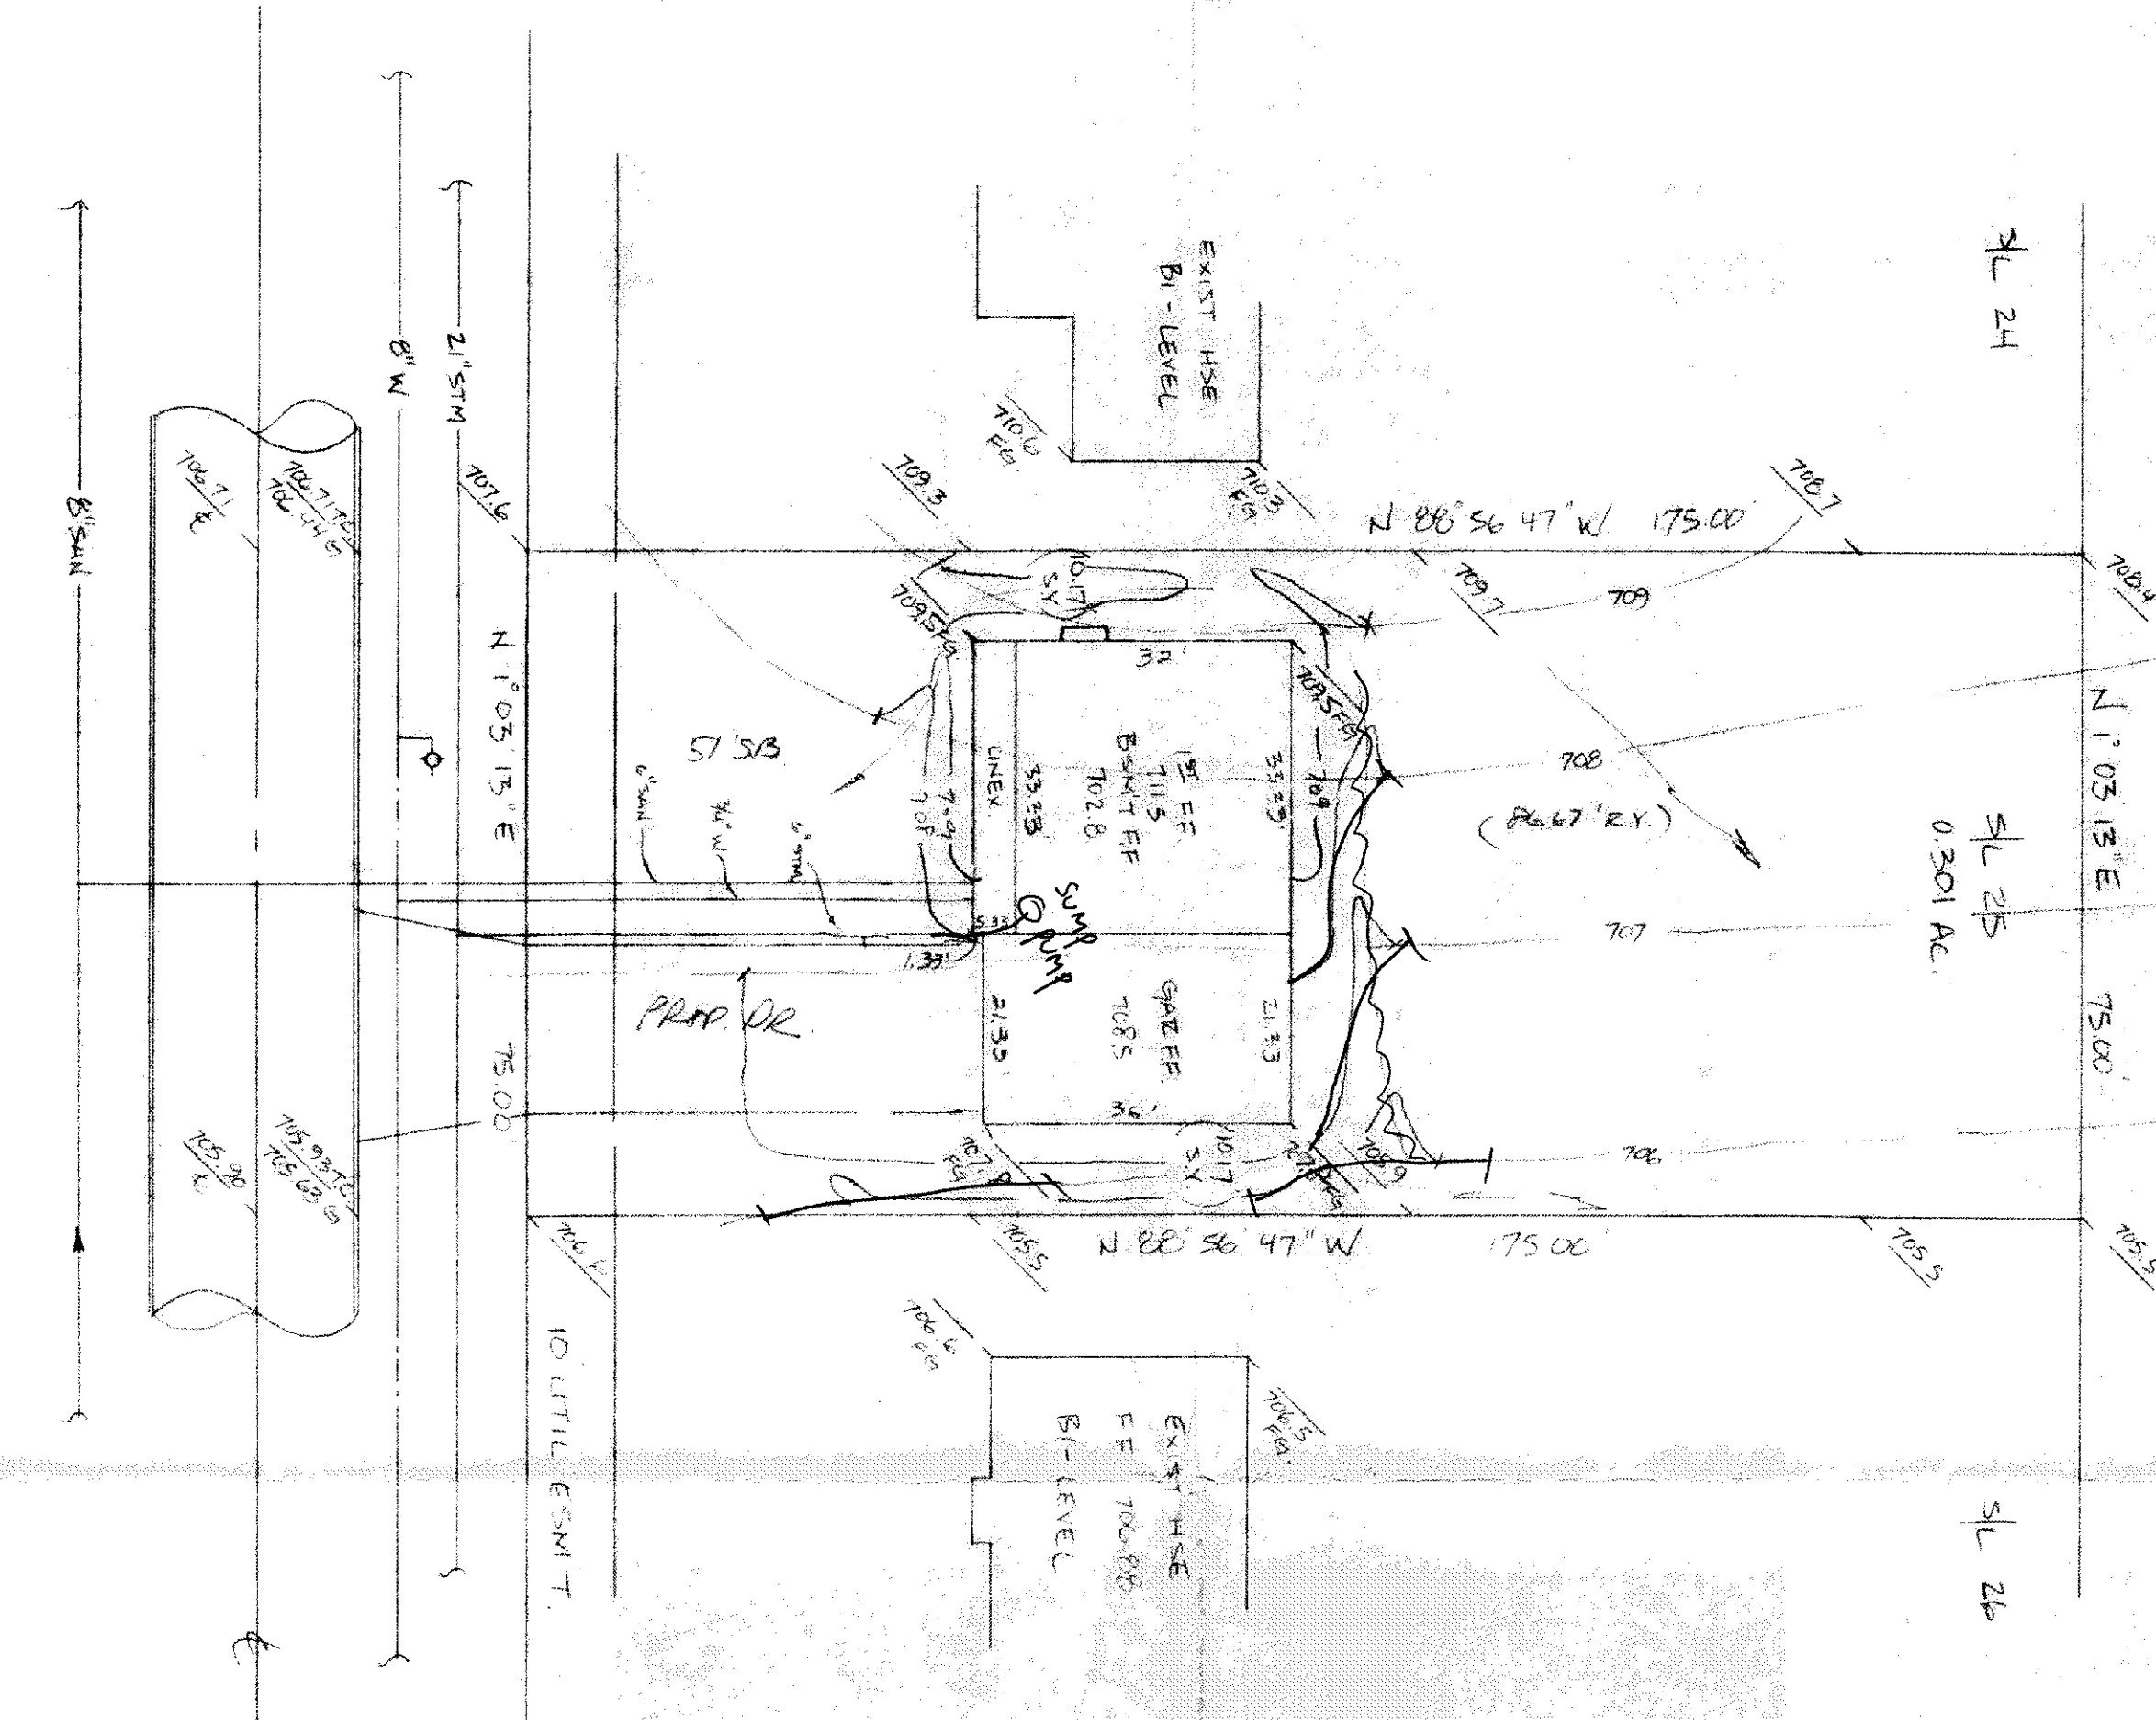

NEUMAR DRIVE - 60