

SITE PLAN

PAINESVILLE TOWNSHIP, LAKE COUNTY, OHIO

for: HEATH & HAYES

ADDRESS: 1744 ST. HADSBY CITY: PAINESVILLE ZIP: 44880

Tract No. 40005
SUBDIVISION 1-24 NAME ST. MARK DR.
VOL. 28 PAGE 1
SUBLOT NO. 28 STREET ST. MARK DR.

LEGEND

SANITARY MANHOLE ---○---
STORM MANHOLE ---●---
INLET OR CATCH BASIN ---□---
HYDRANT ---H---
EXISTING CONTOURS ------
PROPOSED CONTOURS ------
EXIST. ELEV. --- PROPOSED ELEV. ---

REMARKS

ALL BOUNDARY DATA SHOWN WAS OBTAINED FROM IDEEDS, RECORDED
SUBDIVISION PLAT OR OTHER PUBLIC RECORDS
LOCATIONS AS SHOWN OF ADJACENT WELLS AND SEPTIC TANKS OBTAINED FROM
LAKE COUNTY HEALTH DEPARTMENT

DESIGN CERTIFICATION

THIS PLAT WAS PREPARED BY ME, AND IS CORRECT
TO THE BEST OF MY KNOWLEDGE AND BELIEF.

NAME James P. Gilles, P.E. SURVEYOR REGISTRATION NO. 100543

CHECK LIST

NO. OF BEDROOMS
DIMENSIONS
SAN. SEWER SIZE, LOCATION
SAN. MAN. CAST. ELEV. INV. ELEV.
SAN. CONN. SIZE, LOC. DEPTH
STORM SEWER SIZE, LOC. DEPTH
STORM MAN. CAST. ELEV. INV. ELEV.
BLDG. DIMENSIONS FIN. GR.
BLDG. TIES F.L.R. GRADES
APPROX. TYPE WIDTH THICKNESS
SIDEWALK TYPE WIDTH THICKNESS
CULVERT TYPE DIA. LENGTH
ROCK OUTCROPPINGS
ISOLATION RADIUS FROM WELL

PLAN PREPARED BY:

NO. DATE BY
1
2
3
4
5
6

REVISIONS
NO. DATE BY
1
2
3
4
5
6

"AS BUILT" CERTIFICATION

I, HEREBY CERTIFY THAT THE CIRCLED GRADES ARE EXISTING
FINISH GRADES CHECKED IN THE FIELD ON 19
AND ARE CORRECT TO THE BEST OF MY KNOWLEDGE AND BELIEF.

REGISTERED SURVEYOR REG. NO. 784 - L.M. SMITH


ELEV. - 704.50

837.05 FORTER - 699.5
INV. SAN. LG. @ R/W - 697.0

This Permit Expires
JUN 18 1985

PAINESVILLE TOWNSHIP
ZONING APPROVED
5993

R. Hall
Zoning Inspector 6/18/84

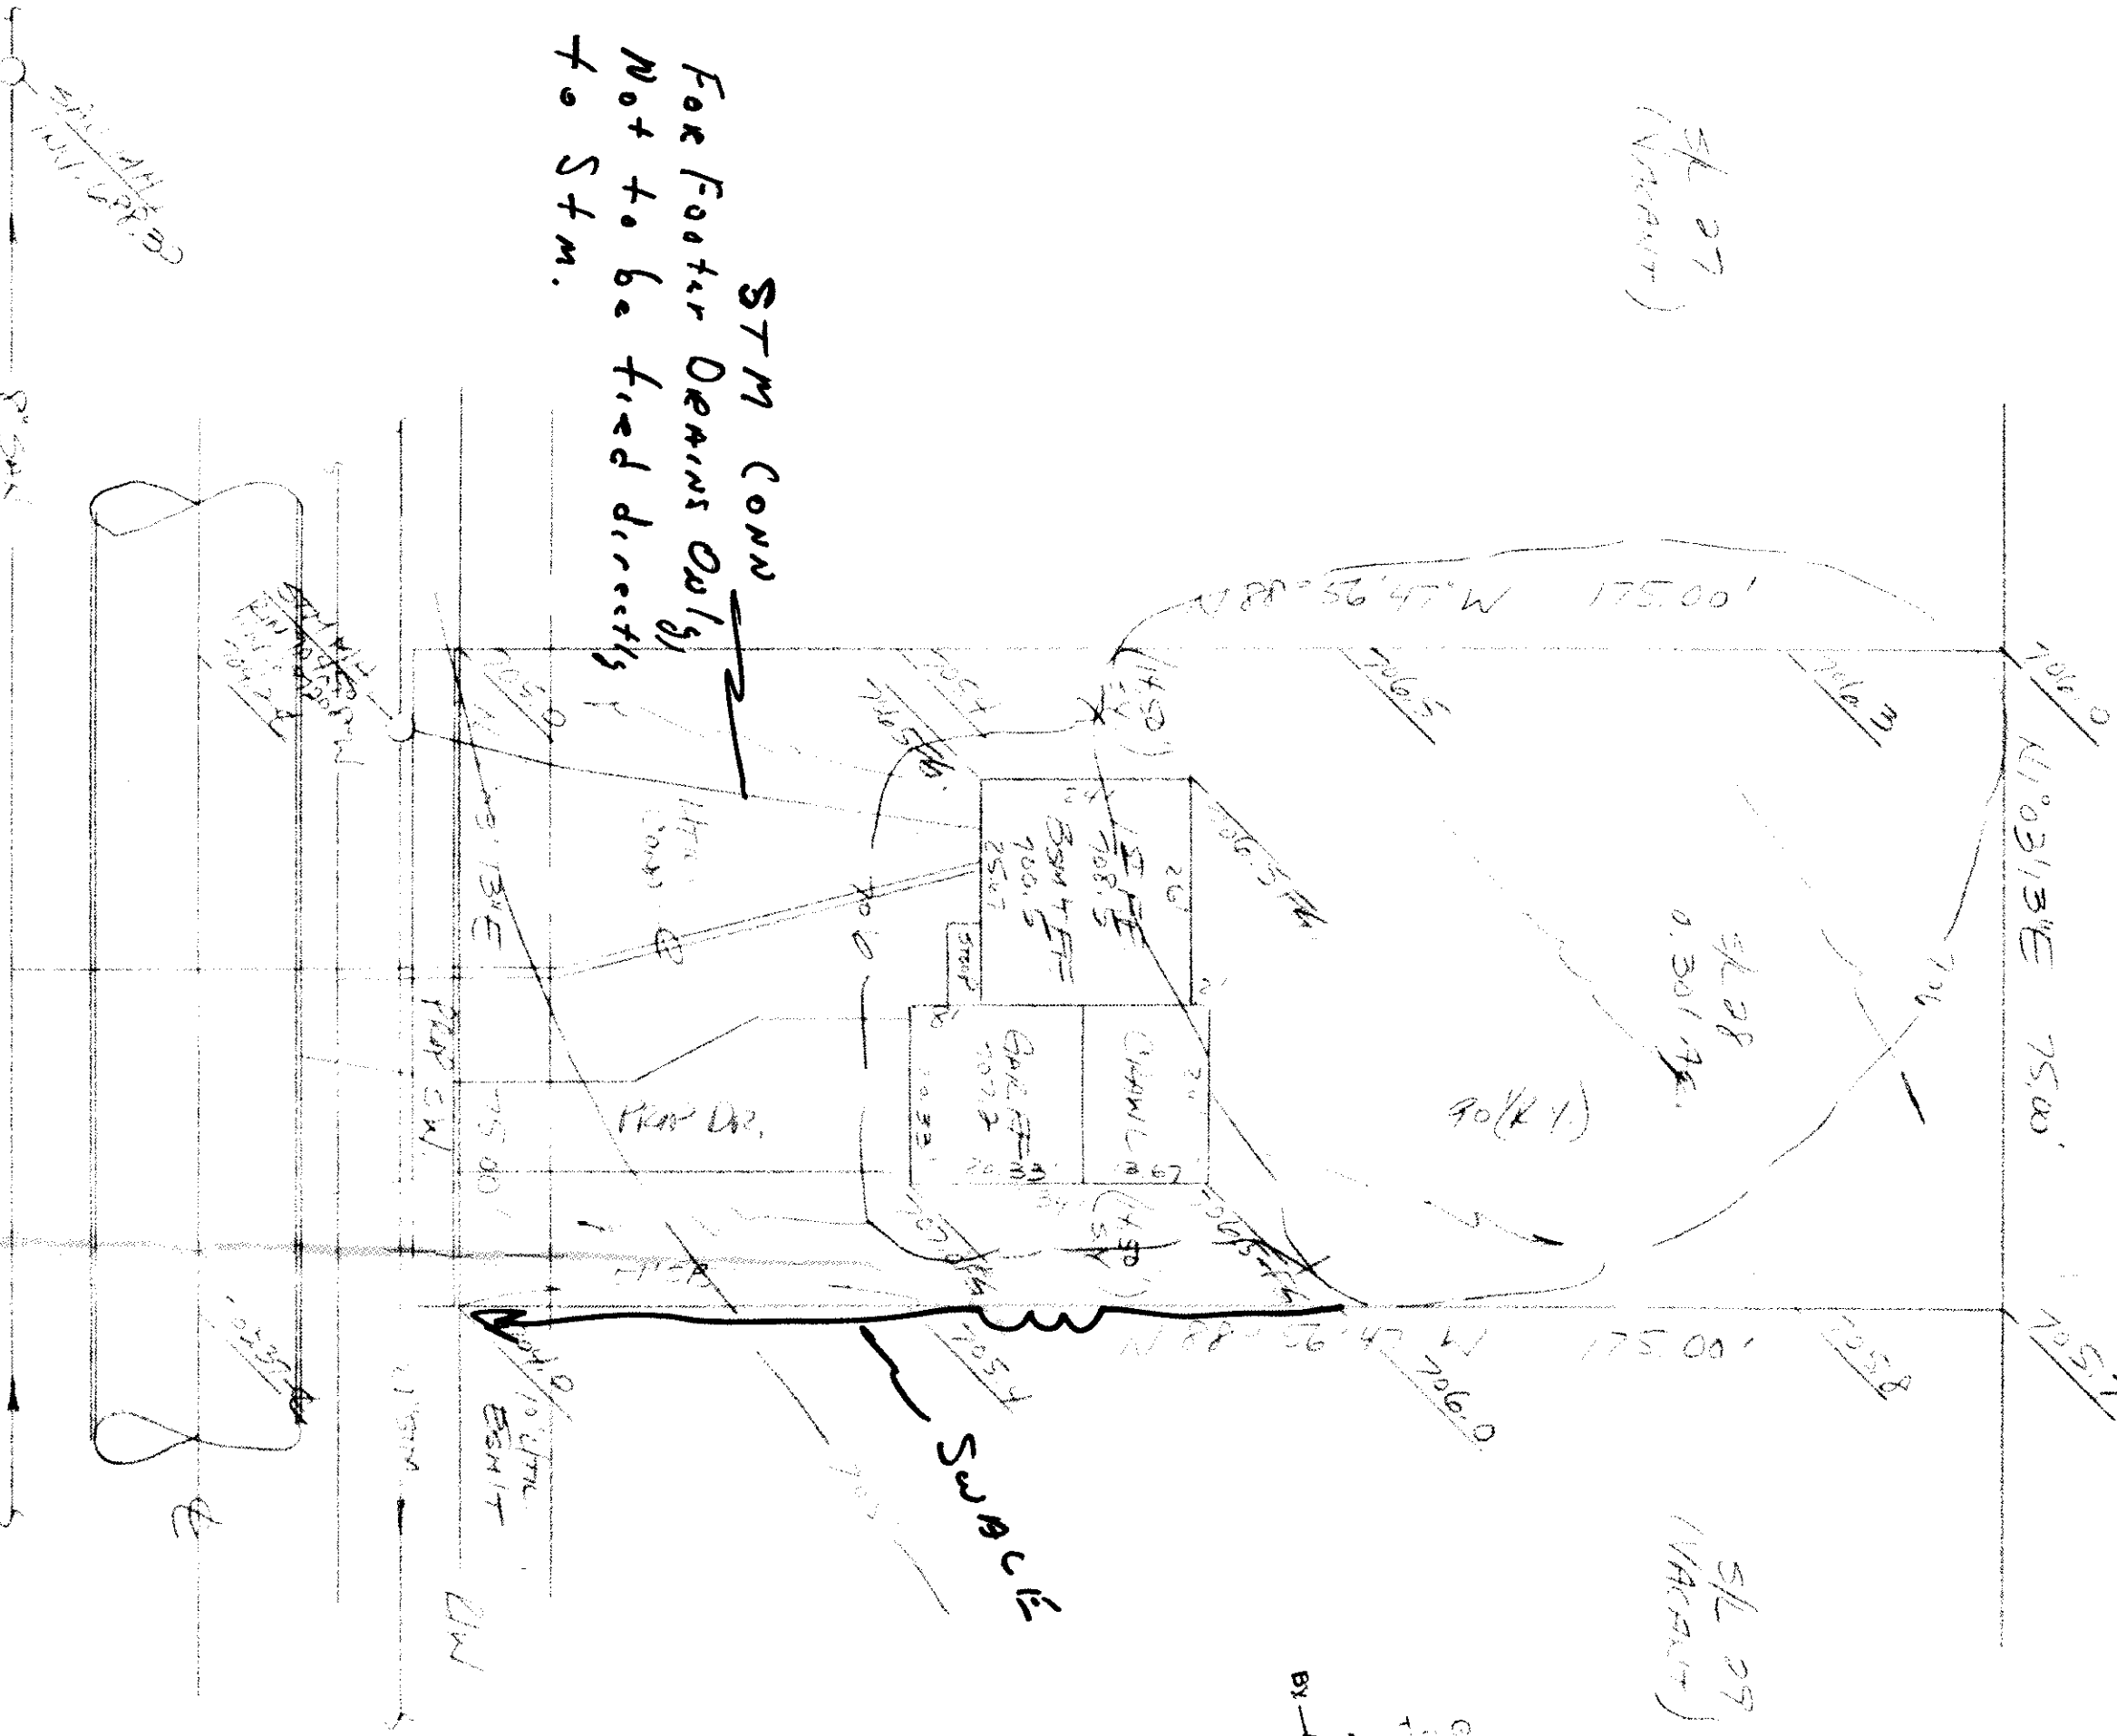

STM CONN
For Footer Drains Only
Not to be tied directly
to STM.

NEELMAR DR. - 600'

Operating Plan Approved
and/or noted
James P. Gilles, P.E.
Lake County Engineer
Date 1985
By 720