

SITE PLAN

PAINESVILLE TOWNSHIP, LAKE COUNTY, OHIO

for:

CLIENT: HELMER & SONS
OWNER: HELMER & SONS
ADDRESS: 1111 N. ST. CITY: PAINESVILLE ZIP: 44880

SUBDIVISION: 1111 N. ST. SUB
VOL. 111 PG. 111
SUBLOT NO. 111 STREET 111

LEGEND

SANITARY MANHOLE ---●---
STORM MANHOLE ---●---
INLET OR CATCH BASIN ---●---
HYDRANT ---●---
EXISTING CONTOURS ---●---
PROPOSED CONTOURS ---●---
EXIST. ELEV. ---●---
PROP. ELEV. ---●---

REMARKS

ALL BOUNDARY DATA SHOWN WAS OBTAINED FROM IDEERS, RECORDED
SUBDIVISION PLAT OR OTHER PUBLIC RECORDS
LOCATIONS AS SHOWN OF ADJACENT WELLS AND SEPTIC TANKS OBTAINED FROM
LAKE COUNTY HEALTH DEPARTMENT

DESIGN CERTIFICATION

THIS PLAT WAS PREPARED BY ME, AND IS CORRECT
TO THE BEST OF MY KNOWLEDGE AND BELIEF.

NAME: PAINEVILLE SURVEYOR REGISTRATION NO. 111

CHECK LIST

NO. OF BEDROOMS: 1
DIMENSIONS: 111' x 111'
SAN. SEWER SIZE: 111" GR. LOC. 111'
SAN. MH. CAST. ELEV. INV. ELEV. 111'
SAN. CONN. SIZE: 111" LOC. DEPTH 111'
SURROUNDING OWNERS: 111'
BLDG. DIMENSIONS: 111' x 111'
BLDG. TIES: 111'
APPROX. TYPE WIDTH THICKNESS: 111'
SIDEWALK TYPE: 111'
CULVERT TYPE DIA. LENGTH: 111'
ROCK OUTCROPPINGS: 111'

PLAN PREPARED BY:

BABCOCK • JONES & ASSOCIATES, INC.

PAINESVILLE, OHIO

NO.	DATE	BY	SCALE	PHONE NO.
1				357-1811
2				
3				
4				
5				

"AS BUILT" CERTIFICATION

I, HEREBY CERTIFY THAT THE CIRCLED GRADES ARE EXISTING
FINISH GRADES CHECKED IN THE FIELD ON 19
AND ARE CORRECT TO THE BEST OF MY KNOWLEDGE AND BELIEF.

REGISTERED SURVEYOR

REG. NO.

TBM - 1111 N. ST. 1111
ELEV. - 1111.50

END OF PLAT 1111.50
1111 N. ST. - 1111.50


This House moves from
SLC 27 to SLC 28

Grading Plan Approved
as shown and/or noted
THOMAS P. GILLES, P.E.
Lake County Engineer
By: 1111 Date: 11/11/84
STM. CONN. - Down Spout
Not to be tied in, no
direct conn. of footer
drains to STM.

Modified by 1111 to
add 2x20 feet to
new. PMH 5/11/84

This Permit Expires
MAY 11 1985
PAINESVILLE TOWNSHIP
ZONING APPROVED
5967
Zoning Inspector 5/11/84

NEELMAR DR. - 60'

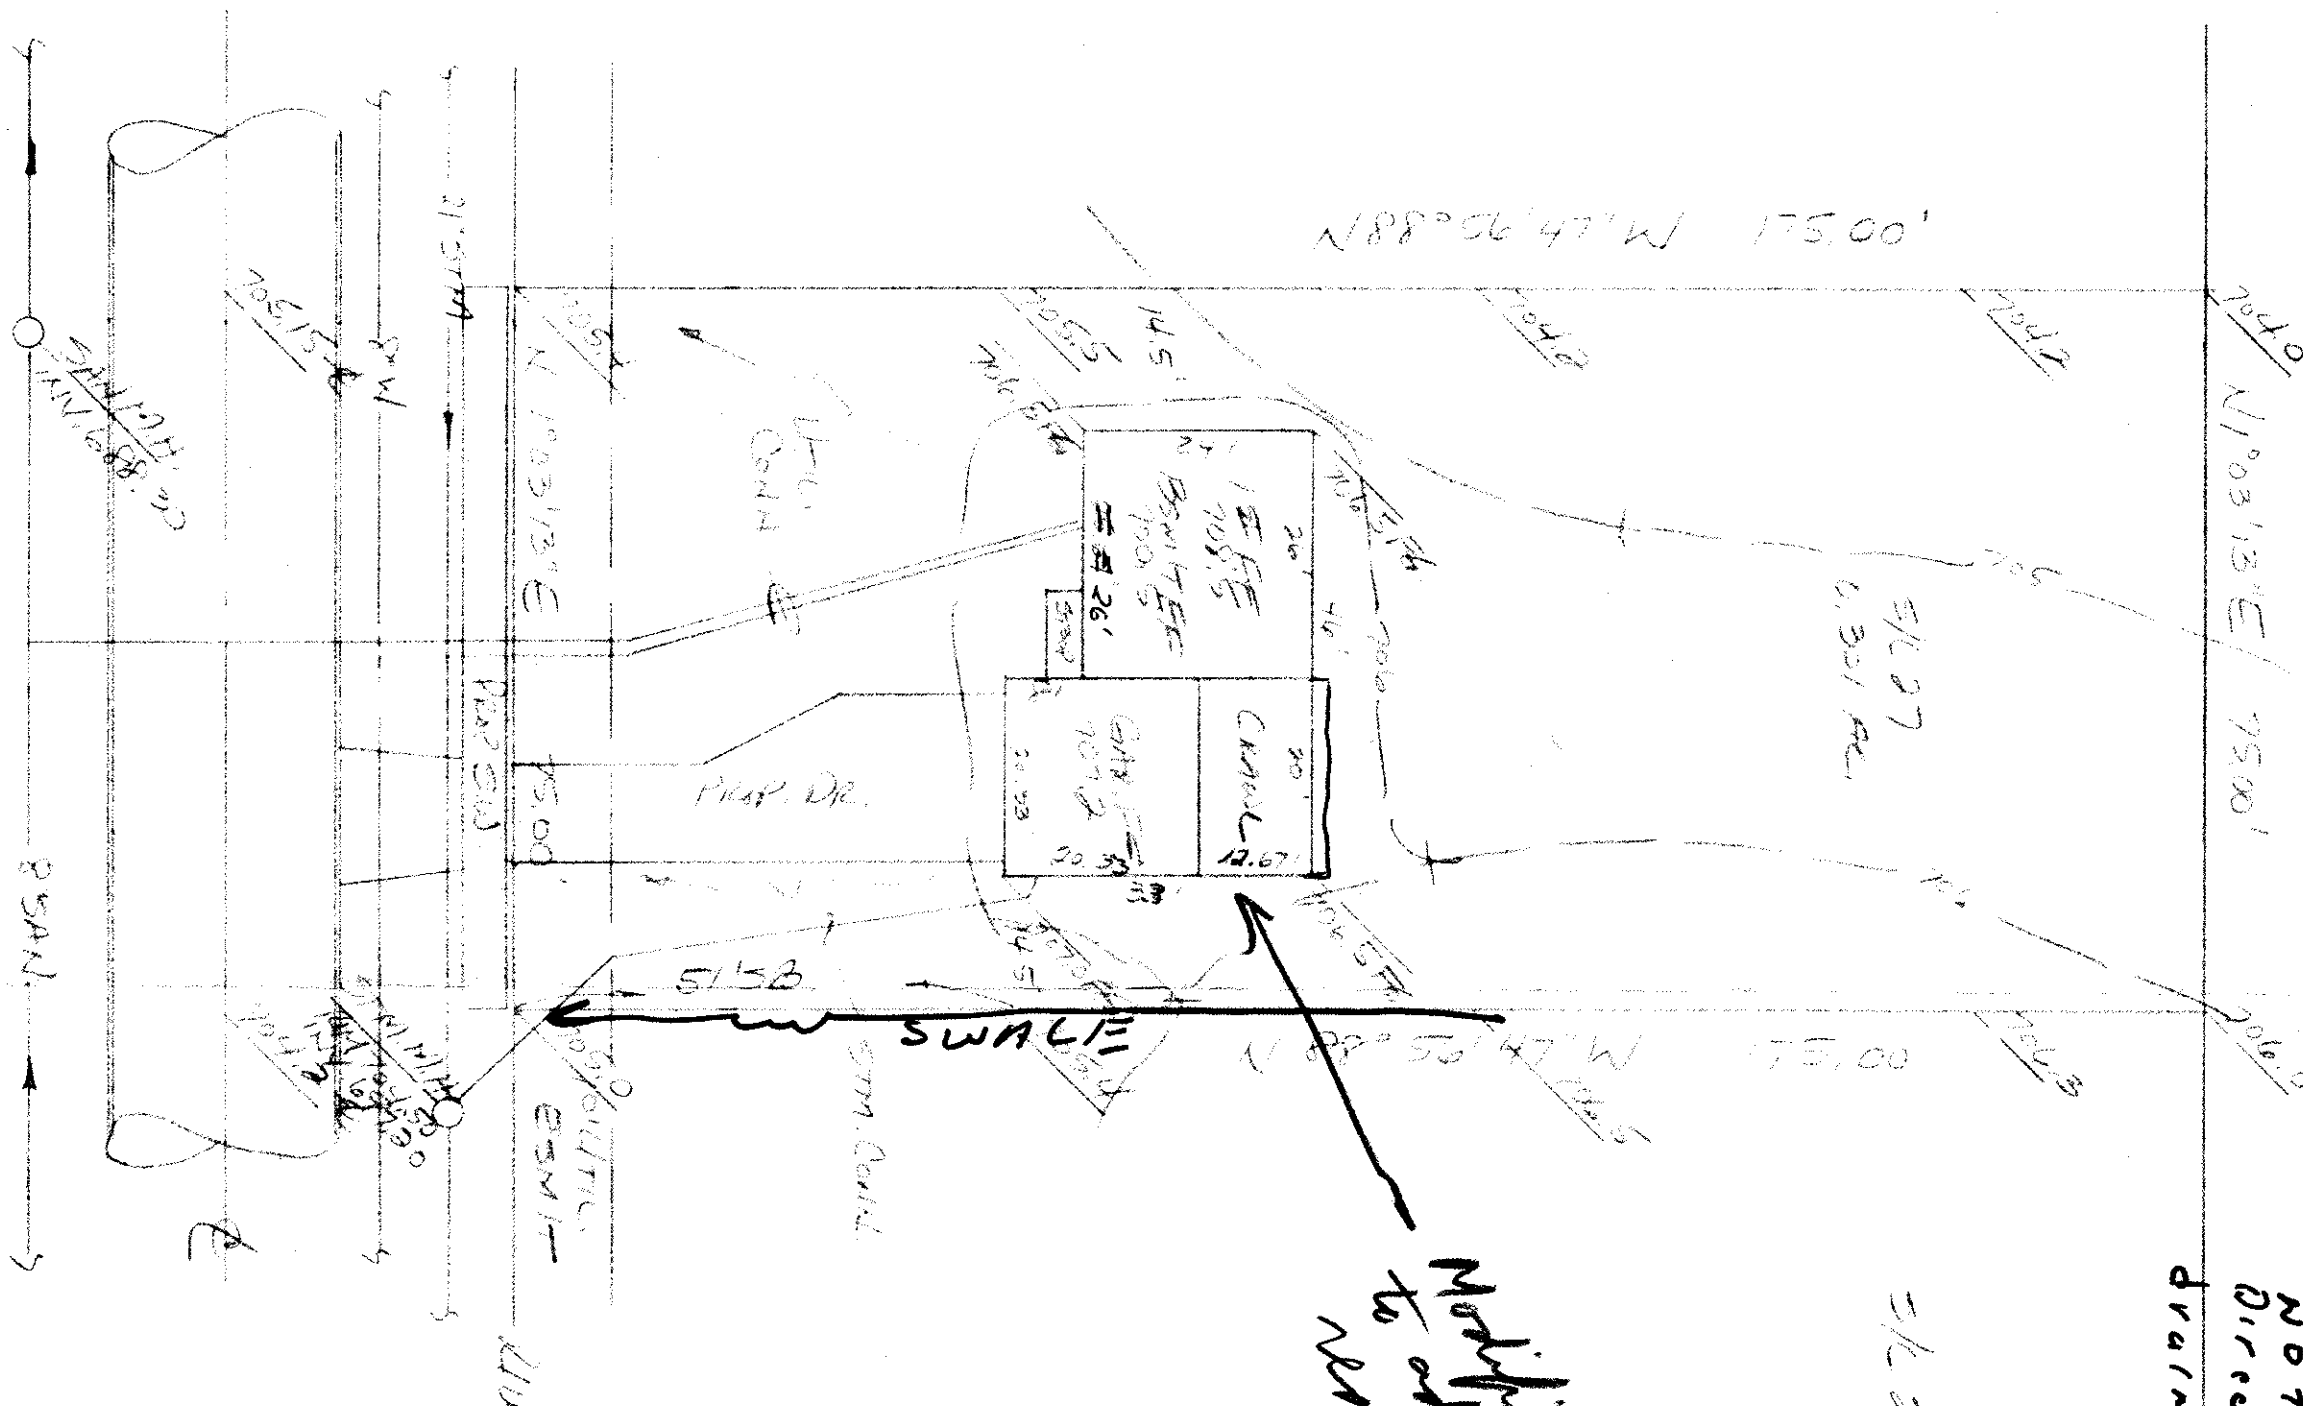

SLC 26
1111.50