


EXIST
ROAD

1"=20'

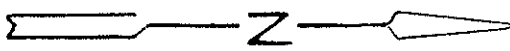

EXIST
ROAD

WATER LINE

PONTIAC AVE.
34'

BENCHMARK-100.00 (ASSUMED)
N. RIM SAND MH: INV 89.33

8" SAND

ORCHARD BLVD. 40'

FE 435.73

3/4" WATER CONN.

6" SAN CONN.

FE 435.73

FE 435.73

SITE PLAN

FOR
THE SHELTON'S

BEING SUBLOT No. 20, 21, & 22,
BLOCK No. 9, FAIRVIEW - ON THE
LAKE SUBD. TOWNSHIP OF FAIRVIEW,
COUNTY OF LAKE, STATE OF OHIO.
VOL. 521-1182 THRU 1186

FE-102.64

D.L. & E. DAVIS
VOL. 806-572

N0°03'00"E 100.00'

101.5'

20'

161.2'

12'

CARPORT

FF-101.4

2 12' CONC. D/W

3/4" WATER CONN.

6" SAN CONN.

15'x15' SLAB

FF-102.07

50.0'

101.5'

51.3'

101.5'

51.3'


101.5'

51.3'

101.5'

S.J. BRAMLEY
VOL. 170-375

FF-100.78

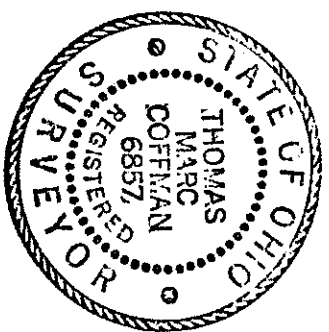

Grading Plan Approved
as shown and/or noted
THOMAS P. GILLESPIE
Lake County Engineer
By GJH Date 6/11/91

12" DRIVE CULVERT REQUIRED

VILLAGE SURVEYING Co.
202 THIRD ST., FAIRPORT HBR., OHIO 44017
(216 357-1359)

201106
7180

Varian 6/12/91
Approved
By Jeffery W. Waples
Jr.

I, the undersigned hereby certify that
this topography, indicated by 1" contour,
and elevations shown hereon represent an
actual field survey made by me on March 26, 1991
and that the elevations were taken at
appropriate intervals and that as of that
date they existed as indicated herein.

J.M. Coffman P.S.
No. 6857