

2

SITE PLAN

PAIDVILLE TOWNSHIP, LAKE COUNTY, OHIO

for: WILLIAM BUILDERS

OWNER

ADDRESS STREET CITY ZIP

SUBDIVISION VOL. - PG. NAME LOT TRACT

SUBLOT NO. STREET MAP NO. 1000

LEGEND

LEGEND
SANITARY MANHOLE
STORM MANHOLE
INLET OR CATCH BASIN
HYDRANT
EXISTING CONTOURS
PROPOSED CONTOURS
EXIST. ELEV. 1000
PROP. ELEV. 1000

REMARKS

ALL BOUNDARY DATA SHOWN WAS OBTAINED FROM IDEEDS, RECORDED SUBDIVISION PLAT OR OTHER PUBLIC RECORDS
LOCATIONS AS SHOWN OF ADJACENT WELLS AND SEPTIC TANKS OBTAINED FROM LAKE COUNTY HEALTH DEPARTMENT

DESIGN CERTIFICATION

THIS PLAT WAS PREPARED BY ME, AND IS CORRECT TO THE BEST OF MY KNOWLEDGE AND BELIEF.

NAME SURVEYOR REGISTRATION NO.

CHECK LIST

NO. OF BEDROOMS
DRAINAGE
REARINGS
TIE TO NEAREST STREET
SUBLOT NO. PARCEL NO.
SURROUNDING OWNERS
BLDG. DIMENSIONS FIN OR
BLDG. TIES P.L.T. GRADERS
ADJACENT TYPE WELLS THICKNESS
CULVERT TYPE DIA. LENGTH
NOCK OUTCROPPINGS

PLAN PREPARED BY: BABCOCK • JONES & ASSOCIATES, INC. PAINESVILLE, OHIO

NO.	DATE	BY
1	5/3/88	HB
2	5/1/88	HB
3	5/1/88	HB
4	5/1/88	HB
5	5/1/88	HB

"AS BUILT" CERTIFICATION

I, HEREBY CERTIFY THAT THE CIRCLED GRADES ARE EXISTING FINISH GRADES CHECKED IN THE FIELD ON 19 19

REGISTERED SURVEYOR REG. NO.

LOW YIELD WATER FIXTURES REQUIRED ON ALL:

Shower Head

Toilet

Creating Plans Approved
THOMAS P. GILLER, P.E.
Lake County Engineer


This Permit Expires
JUNE 26 1990
PAIDVILLE TOWNSHIP
ZONING APPROVED
7257
R. M. Hall
DEPUTY Zoning Inspector
6/26/89

1. 15" DRIVE CULVEY REQUIRED

7C6
(VACANT)

7C4
(VACANT)

NO vertical drain required

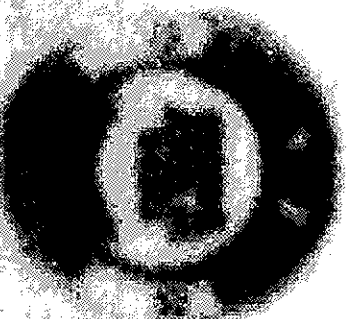

HYDRAULIC PROFILE

SCALE: HORIZ: 1" = 30'
VERT: 1" = 5'

