

GRAPHIC SCALE



(IN FEET)
1 inch = 20 ft.

EX STS MH
RIM 628.78
36" INVS 622.07

48 HOURS
BEFORE YOU DIG
Call..800-362-2764
TOLL FREE
OHIO UTILITIES PROTECTION SERVICE



EX STS MH
RIM 628.71
12" INV 623.78
15" INV 623.53
36" INVS 621.78

BENCHMARK
TOP STEM OF HYDRANT
IN FRONT OF S/L 294
ELEV = 630.42

- ① = EX WATER CONN
- ② = EX SAS LAT
- ③ = EX STS LAT
- ④ = PROP 4' CONC SIDEWALK
- ⑤ = PROP 23' CONC APRON
- Ⓐ = PROP 1" WATER CONN
- Ⓑ = PROP 6" SAS CONN
- Ⓒ = PROP 6" STS CONN

LEGEND

- = MONUMENT BOX
- ⊙ = 5/8"x30" IP SET
CAPPED "AZTECH #8249"
- = IRON PIN FOUND
- ⊕ = STORM MANHOLE
- ⊙ = SANITARY MANHOLE
- ⊗ = WATER VALVE
- ⚡ = FIRE HYDRANT
- ⊞ = ELECTRIC PEDESTAL
- ⊞ = CABLE PEDESTAL
- ⊞ = TELEPHONE PEDESTAL
- ☆ = LIGHT POLE
- △ = OFFSET HUBS
- = FLOW DIRECTION
- ↔ = SWALE
- = EXISTING GRADE
- - - = PROPOSED GRADE
- = PROP SILT FENCE
- = INLET PROTECTION
- ⊙ = SUMP PUMP
- ▨ = PROP 30' TEMPORARY
SEEDING/MULCHING

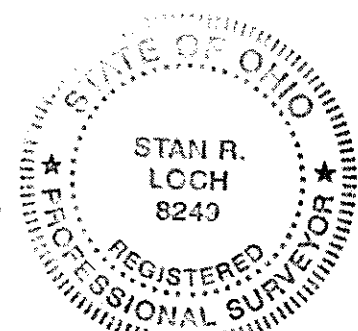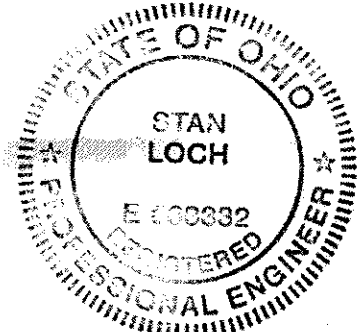

"AS-BUILT" CERTIFICATION
I HERBY CERTIFY THAT THE CIRCLED INFORMATION
IS EXISTING AS OBTAINED ON THE SITE
AND IS CORRECT TO THE BEST OF MY KNOWLEDGE
AND BELIEF.

STAN R. LOCH REG.#

"I, THE UNDERSIGNED HEREBY CERTIFY
THAT THIS TOPOGRAPHY, INDICATED BY
6", ① OR 2" CONTOURS, AND ELEVATIONS
SHOWN HEREON REPRESENT AN ACTUAL
FIELD SURVEY MADE BY ME ON THE
4TH DAY OF NOVEMBER, 2011
AND THAT THE ELEVATIONS WERE TAKEN
AT APPROPRIATE INTERVALS AND THAT
AS OF THAT DATE THEY EXISTED AS
INDICATED HEREON."

STAN R. LOCH REG.# 8249

Stormwater Management Plan
Approved as shown and/or indicated by
JAMES R. GILLS, P.E.
County Drainage Engineer

By L.S. Date 12-1-11

5425 WARNER ROAD - SUITE 12
VALLEY VIEW, OHIO 44125
440-602-9071 FAX 216-388-0259



SITE PLAN FOR
B.R. KNEZ
CONSTRUCTION, INC.
OUTRIGGER COVE
BEING SUBLT 260 IN THE
LAKE ERIE SHORES PHASE 4A
PLAT VOLUME 50, PAGE 33
P.P.#11-B-043-F-00-273-0
PAINESVILLE TOWNSHIP, COUNTY OF LAKE
STATE OF OHIO

NO. DATE DESCRIPTION BY