


W:\2004\04107\04107-192.dwg, 11/17/04 12:50:44 PM, Copyright Barrington Consulting Group

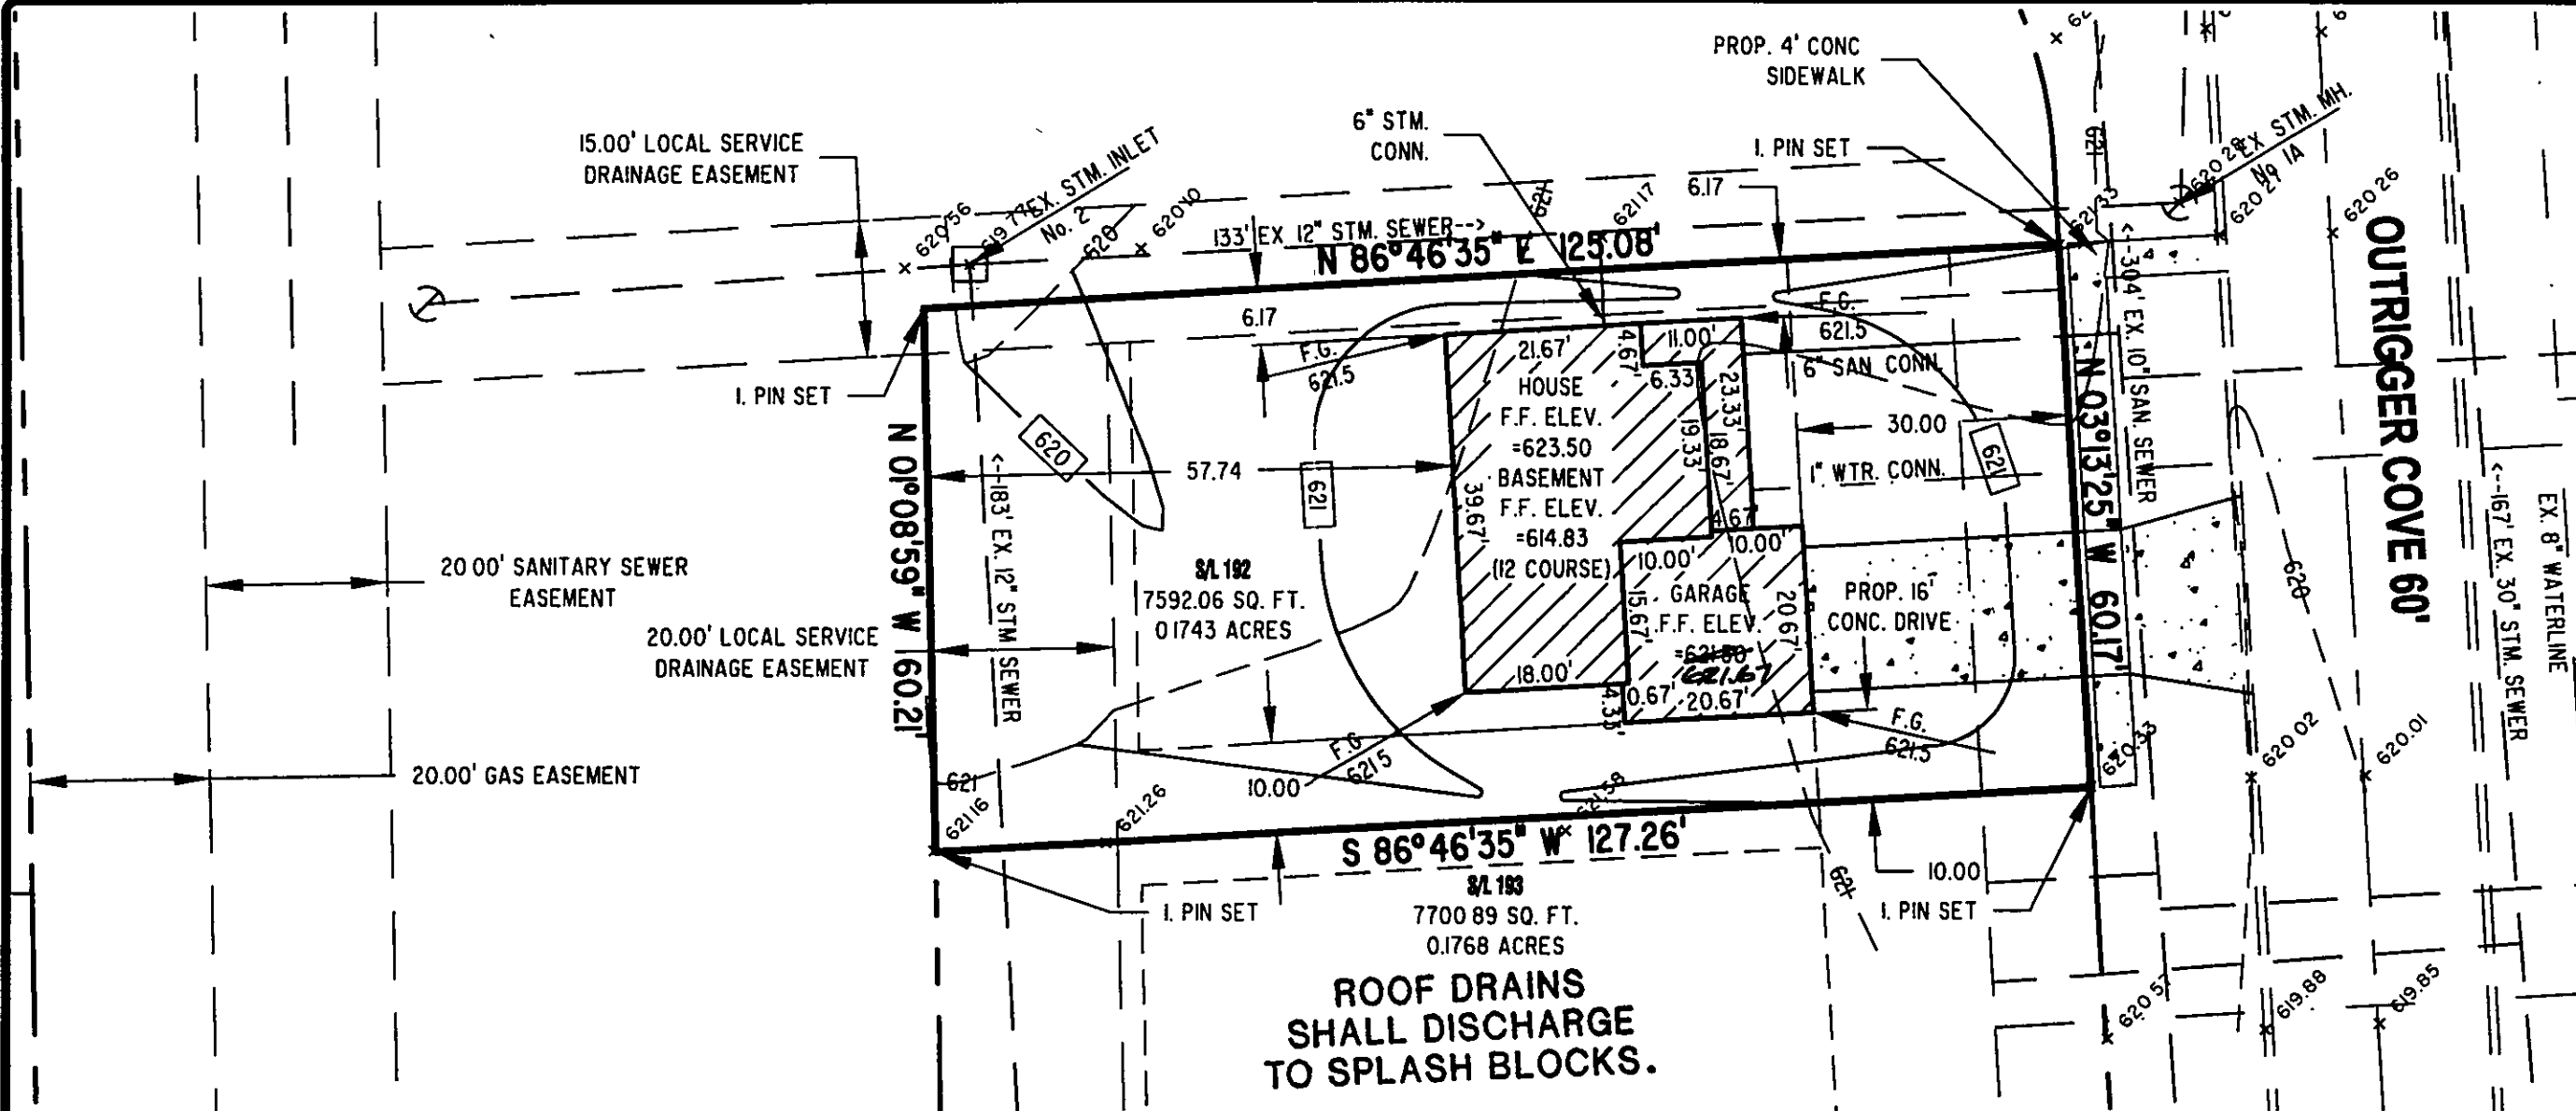

GENERAL NOTES:

1. BENCHMARK - TOP STEM OF EXISTING FIRE HYDRANT LOCATED IN FRONT SUBLOT 250, ELEVATION = 622.86.
2. DRIVEWAY APRON TO BE 6" THICK CONCRETE.
3. ALL DOWNSPOUTS TO BE OUTLETTED TO SPLASH BLOCKS. ✓
4. CONTRACTOR RESPONSIBLE FOR CONTACTING THE OHIO UTILITY PROTECTION SERVICE (1.800.362.2764) AND ALL UTILITY COMPANIES A MINIMUM OF 48 HOURS PRIOR TO CONSTRUCTION.
5. THE LOCATION BOTH HORIZONTAL AND VERTICAL OF EXISTING UNDERGROUND UTILITIES SHOWN HEREON, HAVE BEEN OBTAINED BY A DILIGENT AND COMPREHENSIVE SEARCH OF AVAILABLE RECORDS. VERIFICATION BY FIELD OBSERVATION HAS BEEN CONDUCTED WHERE PRACTICAL, HOWEVER, BARRINGTON CONSULTING GROUP, INC. DOES NOT GUARANTEE THE COMPLETENESS, NOR ACCURACY THEREOF.
6. CONTRACTOR SHALL VERIFY ELEVATIONS OF LATERAL INVERTS IN THE FIELD PRIOR TO FOUNDATION EXCAVATION.
7. SEE SHEET 2 FOR EROSION AND SEDIMENT-CONTROL PLAN
8. SEE SHEET 2 FOR SEEDING INFORMATION

CERTIFICATION :

"I THE UNDERSIGNED HEREBY CERTIFIES THAT THIS TOPOGRAPHY INDICATED BY 1 FOOT CONTOURS AND ELEVATION SHOWN HEREON REPRESENTS AN ACTUAL SURVEY MADE BY ME ON THE 12th DAY OF NOVEMBER, 2004 AND THE ELEVATIONS WERE TAKEN AT AN APPROPRIATE INTERVAL AND AS OF THAT DAY THEY EXISTED AS INDICATED HEREON.

"I HEREBY CERTIFY THAT THIS PLAN WAS PREPARED BY ME AND IS CORRECT TO THE BEST OF MY KNOWLEDGE AND BELIEF"

David W. Novak
DAVID W. NOVAK, P.S. No. 7507

CERT-1.DWG

Stormwater Management Plan
Approved as shown and/or noted by
JAMES R. GILLS, P.E.
County Drainage Engineer

By L.S. Date 11/19/04



STORM MH.'S

EX. STORM MH. #1A
RIM=620.28
INV.=615.12

EX. STORM INLET #2
RIM=619.77
INV.=615.32


APPROVED
PAINESVILLE TOWNSHIP
ZONING DEPARTMENT
2004390
DLR

GRAPHIC SCALE

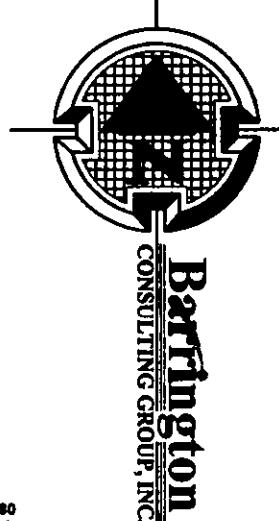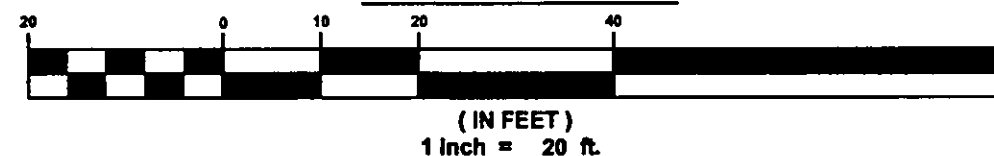

REVISIONS	BY

Barrington
CONSULTING GROUP, INC.
9114 TYLER BLVD
MENTOR, OHIO 44060
PHONE 440.285.1260 FAX 440.285.1262

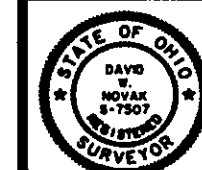

SITE PLAN
S/L 192 OUTRIGGER COVE LAKE ERIE SHORES PH. 3
PAINESVILLE TWP. OH. 44077

CANTERBURY HOMES, INC.

W50
CHECKED
DWN
DATE
NOV. 17, 2004
SCALE
1" = 20'
JOB NO.
04107-192
SHEET
1/2
OF
SHEETS

04107-192