

STORM MH'S

EX. STORM MH. #1A

RIM=620.28

INV.=615.12

EX. STORM MH. #2

RIM=620.01

INV.=611.58

1. BENCHMARK - TOP STEM OF EXISTING FIRE HYDRANT LOCATED IN FRONT SUBLOT 250, ELEVATION = 622.86.
2. DRIVEWAY APRON TO BE 6" THICK CONCRETE.
3. ALL DOWNSPOUTS TO BE OUTLETTED TO SPLASH BLOCKS.
4. CONTRACTOR RESPONSIBLE FOR CONTACTING THE OHIO UTILITY PROTECTION SERVICE (1.800.362.2764) AND ALL UTILITY COMPANIES A MINIMUM OF 48 HOURS PRIOR TO CONSTRUCTION.
5. THE LOCATION BOTH HORIZONTAL AND VERTICAL OF EXISTING UNDERGROUND UTILITIES SHOWN HEREON, HAVE BEEN OBTAINED BY A DILIGENT AND COMPREHENSIVE SEARCH OF AVAILABLE RECORDS. VERIFICATION BY FIELD OBSERVATION HAS BEEN CONDUCTED WHERE PRACTICAL, HOWEVER, BARRINGTON CONSULTING GROUP, INC. DOES NOT GUARANTEE THE COMPLETENESS, NOR ACCURACY THEREOF.
6. CONTRACTOR SHALL VERIFY ELEVATIONS OF LATERAL INVERTS IN THE FIELD PRIOR TO FOUNDATION EXCAVATION.
7. SEE SHEET 2 FOR EROSION AND SEDIMENT-CONTROL PLAN.
8. SEE SHEET 2 FOR SEEDING INFORMATION.

GENERAL NOTES:

1. THE UNDERSIGNED HEREBY CERTIFIES THAT THIS TOPOGRAPHY HEREON REPRESENTS AN ACTUAL SURVEY MADE BY ME ON THE 12th DAY OF NOVEMBER, 2004 AND THE ELEVATIONS WERE TAKEN AT AN APPROPRIATE INTERVAL AND AS OF THAT DAY THEY EXISTED AS INDICATED HEREON.


1. HEREBY CERTIFY THAT THIS PLAN WAS PREPARED BY ME AND IS CORRECT TO THE BEST OF MY KNOWLEDGE AND BELIEF.

CERTIFICATION:


DAVID W. NOVAK, P.S. No. 7507

APPROVED
Painesville Township
Zoning Department


GRAPHIC SCALE
(IN FEET)
1 inch = 20 ft.

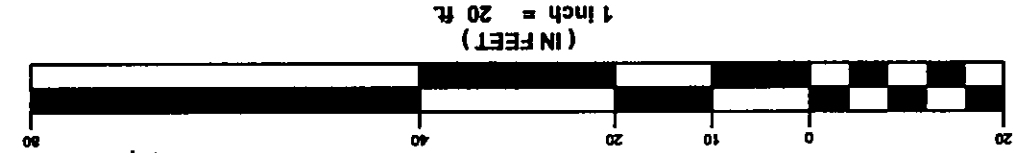

Barrington
CONSULTING GROUP, INC.

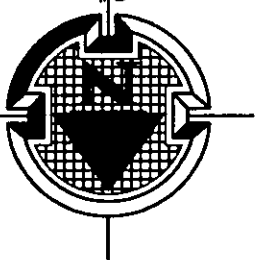

Stormwater Management Plan
Approved as shown and/or noted
JAMES R. GILLS, P.E.
County Drainage Engineer
By A.S. Date 3/4/05

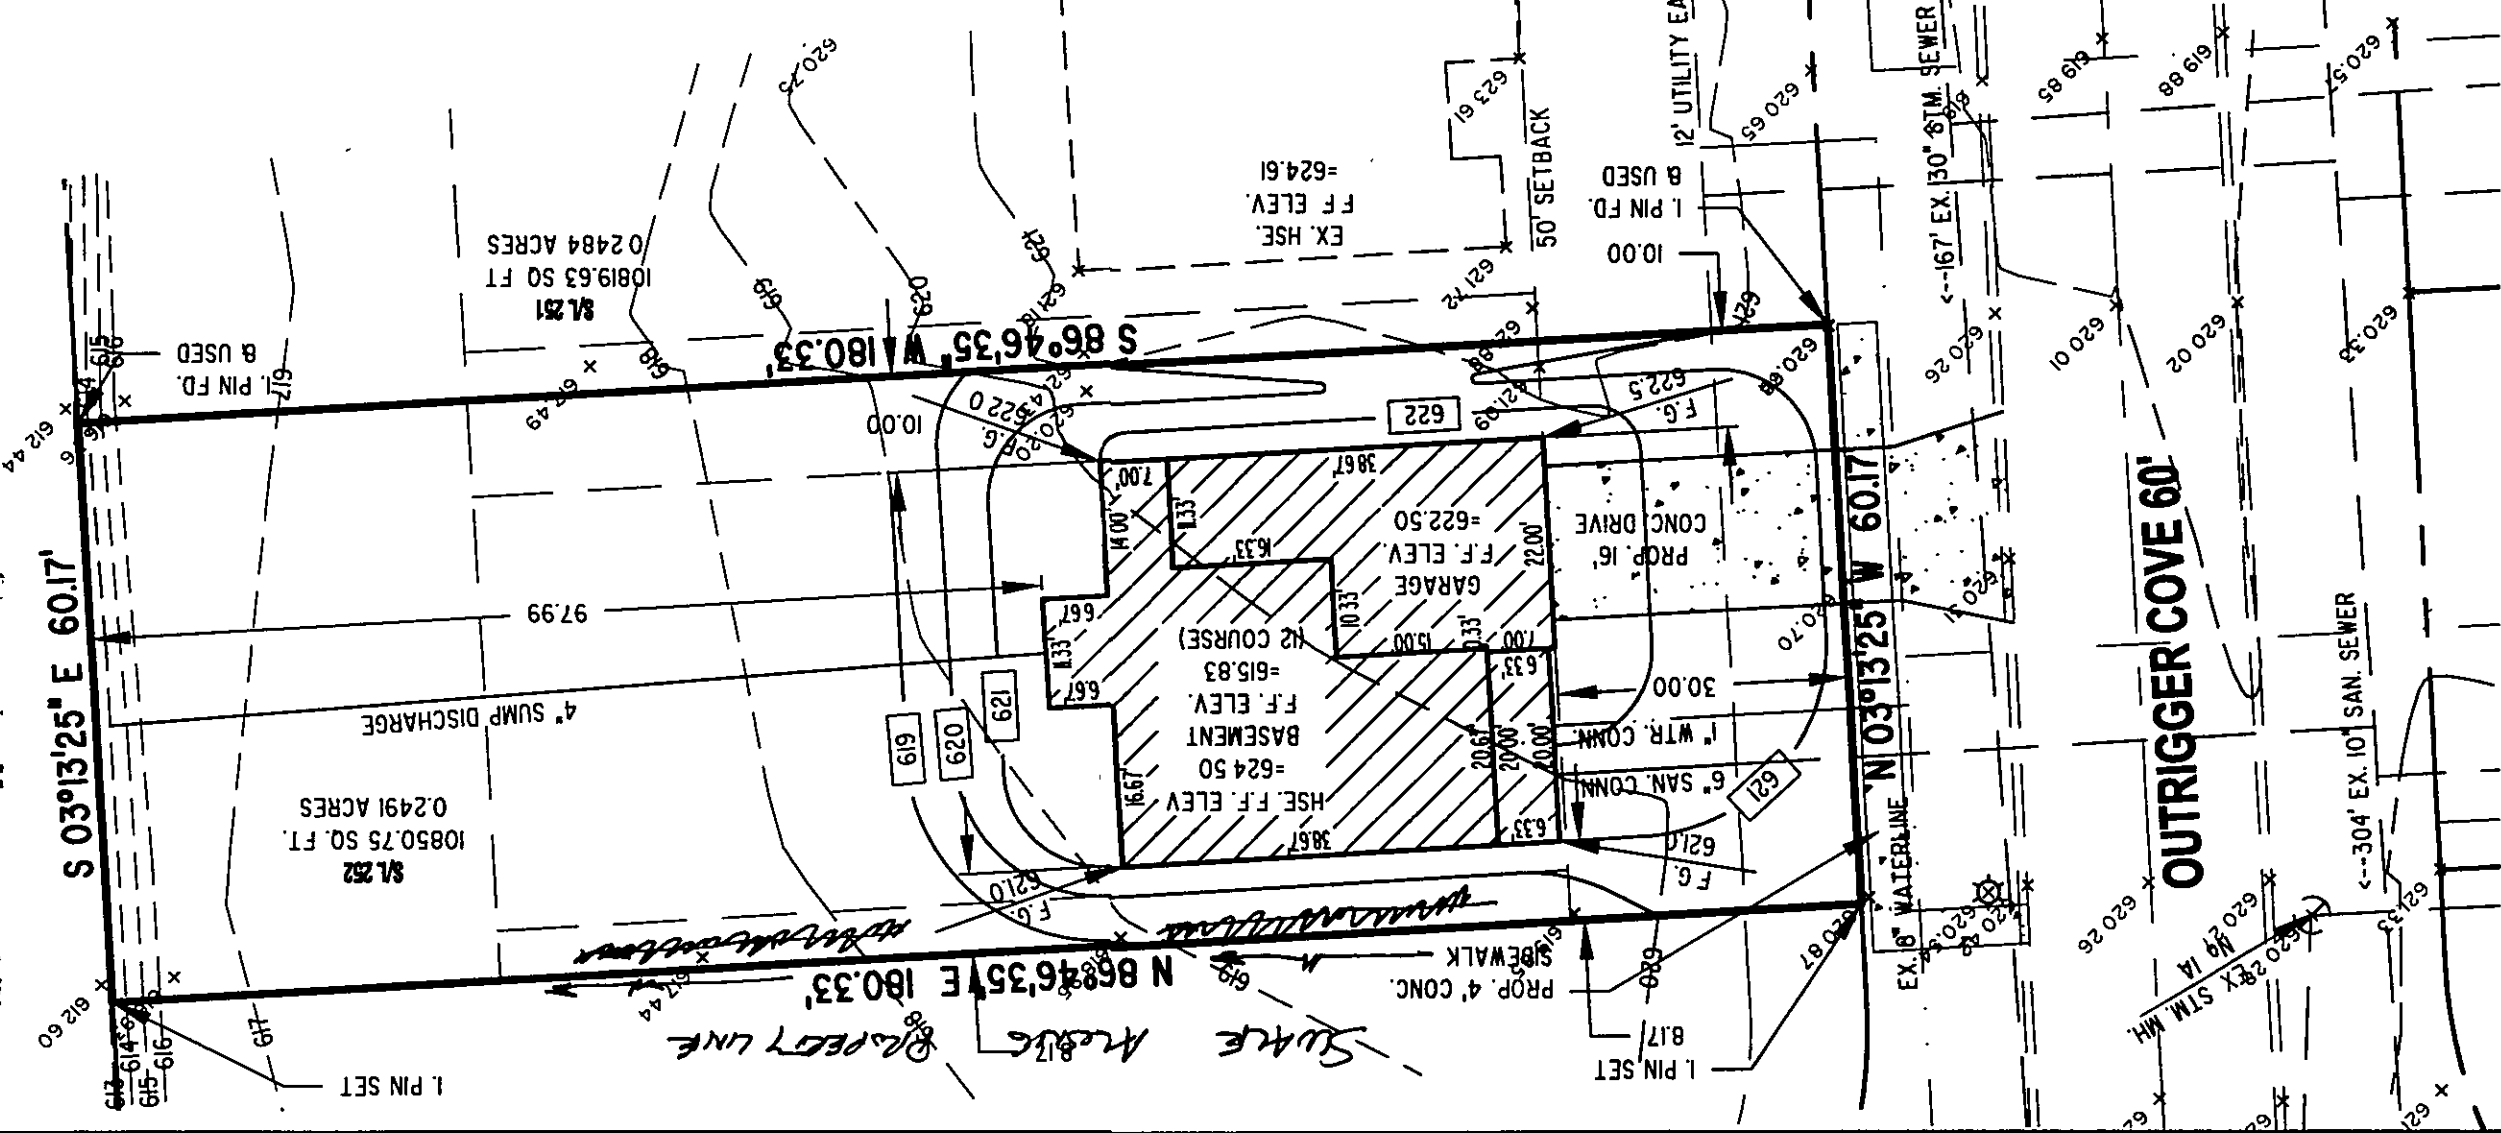

SITE PLAN
SL 232 OUTRIGGER COVE LAKE ERIE SHORES PH. 3
PANESVILLE TWP. OH. 44077
LITTLE MOUNTAIN HOMES, INC.



Barrington
CONSULTING GROUP, INC.
9114 TYLER BLVD., MENTOR, OHIO 44060
PHONE 440.285.1260 FAX 440.285.1262
BCG@BarringtonCGI.com

REVISIONS

OF SHEETS
1/2
04114-252
JOB NO.
20
SCALE
1" = 20'
MARCH 01, 2005
DWN
CHECKED
W.S.O.
DATE