


Name Henry Jones # 6343
Reg. No.

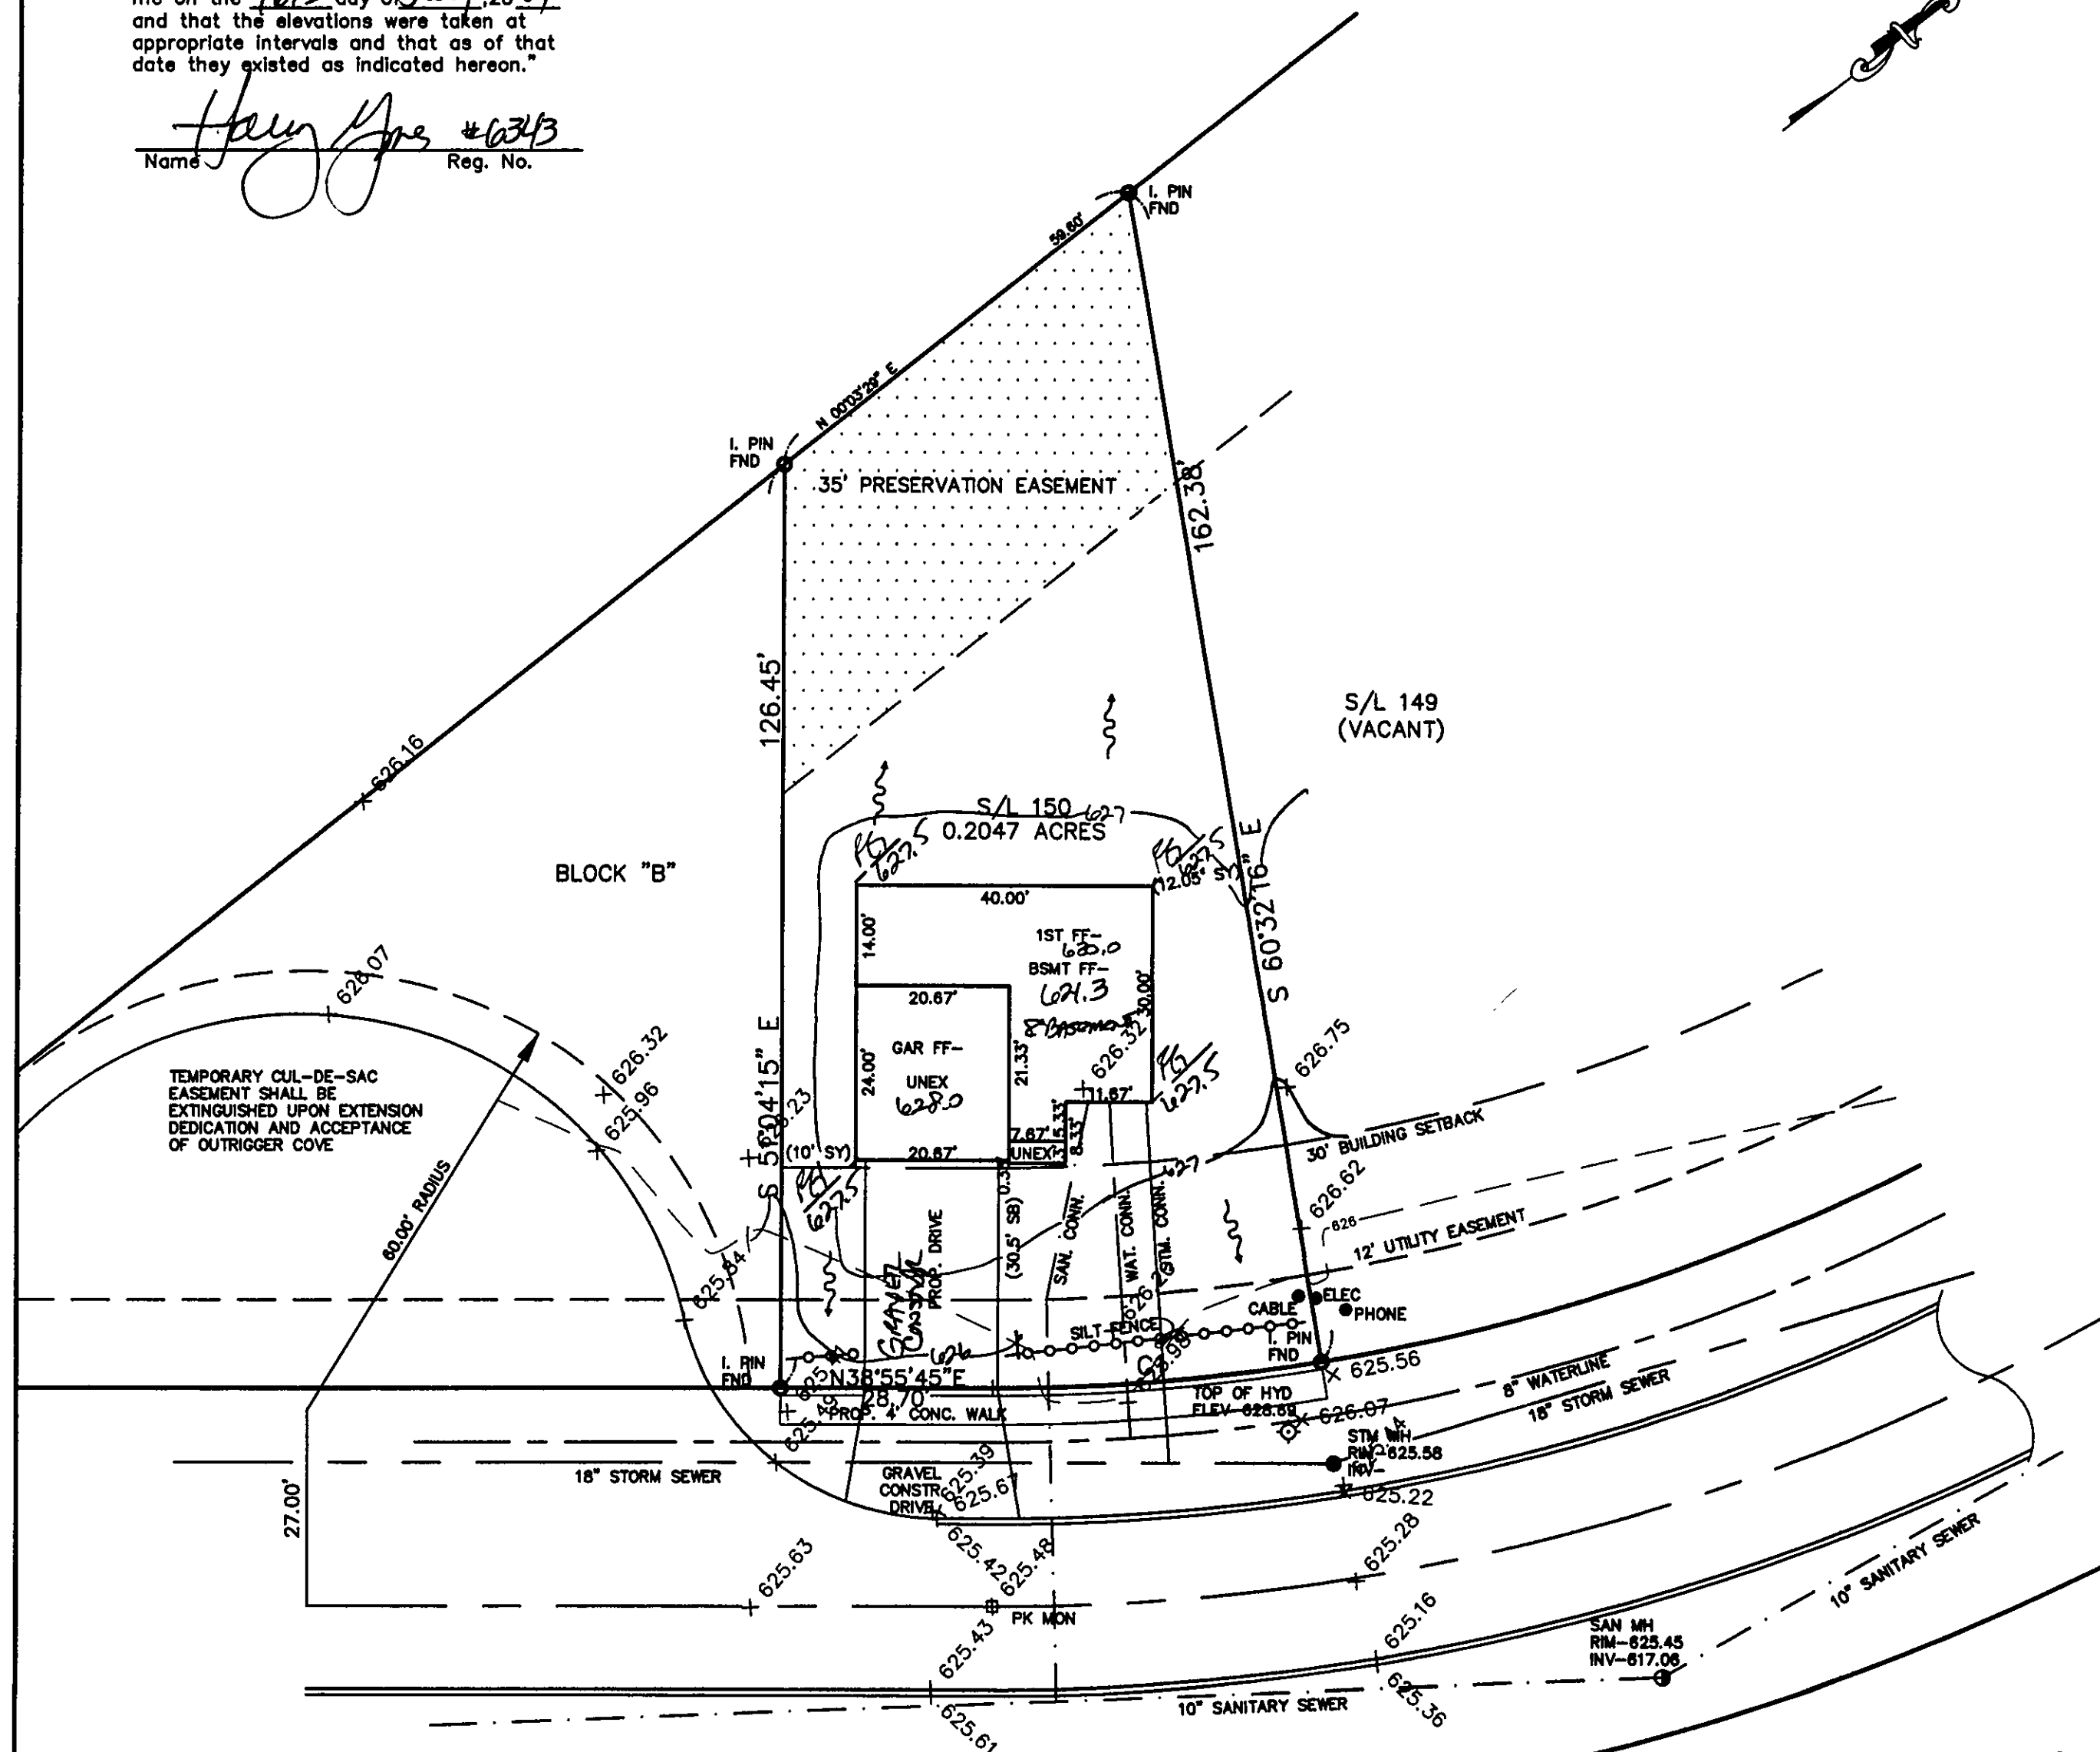

OUTRIGGER COVE - 60'

APPROVED
PAINESVILLE TOWNSHIP
ZONING DEPARTMENT
2004265
DJH