

SITE PLAN

PAINESVILLE TWP., LAKE COUNTY, OHIO
for: SHAMROCK CONST.

CLIENT		OWNER	
ADDRESS	STREET	CITY	ZIP
SOMERSET MEADOWS			
SUBDIVISION	33-18	NAME	TRACT
VOL-PG.	10-10	LOT	STREET
11	OVERLOOK DR.	LOT	STREET
SUBLOT NO.	STREET	VOL-PG.	PERM. PARCEL NO.

LEGEND	
SANITARY MANHOLE	100.0
STORM MANHOLE	100.0 ± 2 PROP. ELEV.
INLET OR CATCH BASIN	AS BUILT ELEVATION
HYDRANT	INDICATES
EXISTING CONTOURS	DIRECTION OF
PROPOSED CONTOURS	SURFACE DRAINAGE

REMARKS
ALL BOUNDARY DATA SHOWN WAS OBTAINED FROM (DEEDS, RECORDED SUBDIVISION PLAT OR OTHER PUBLIC RECORDS)
LOCATIONS AS SHOWN OF ADJACENT WELLS AND SEPTIC TANKS OBTAINED FROM LAKE COUNTY HEALTH DEPARTMENT

DESIGN CERTIFICATION
THIS PLAN WAS PREPARED BY ME, AND IS CORRECT TO THE BEST OF MY KNOWLEDGE AND BELIEF.
NAME SURVEYOR REGISTRATION NO.


CHECK LIST	
NO. OF BEDROOMS	WATER MAIN SIZE, LOCATION
DIMENSIONS	SAN. SEWER SIZE & GR. LOC.
BEARINGS	SAN. MH. CAST. ELEV. INV. ELEV.
TIE TO NEAREST STREET	SAN. CONN. SIZE, LOC. DEPTH
SUBLOT NO. PARCEL NO.	STORM SEWER SIZE & GR. LOC.
SURROUNDING OWNERS	STORM MH. CAST ELEV. INV. ELEV.
BLDG. DIMENSIONS FIN GR.	PAV'T TYPE GRADE CURBS
BLDG. TIES FL'R. GRADES	GAS LINE LOC. SIZE PRESSURE
APRON TYPE WIDTH THICKNESS	SEPTIC TANK LOCATION & DUPLICATION AREA
SIDEWALK TYPE WIDTH THICKNESS	WELL LOCATION
CULVERT TYPE DIA., LENGTH	ISOLATION RADIUS FROM WELL
ROCK OUTCROPPINGS	

REVISIONS			PLAN PREPARED BY:	
NO.	DATE	BY	BABCOCK JONES & ASSOCIATES, INC.	
1			PAINESVILLE, OHIO	
2			DRAWN BY T.R.	SCALE 1"=20'
3			CHK'D. W.B.	DATE 5/28/99
4			CHK'D. K.J.	APP'D W.B.
5			CHIEF	PHONE NO. 440-357-1811
				DRAWING NO. 98-228-11

"AS BUILT" CERTIFICATION
I, HEREBY CERTIFY THAT THE CIRCLED GRADES ARE EXISTING
FINISH GRADES CHECKED IN THE FIELD ON 19
AND ARE CORRECT TO THE BEST OF MY KNOWLEDGE AND BELIEF.

REGISTERED SURVEYOR	REG. NO.
C1: R=230.00' L=76.77' T=38.75' D=19°07'30" C=76.42' N81°08'03"E	TBM-TOP OF HYDRANT ELEV.=711.75

By TAM Date 6/4/99
Scale as shown
Lower F.G. to 712.50
ROOF DRAINS
SHALL DISCHARGE
TO SPLASH BLOCKS.

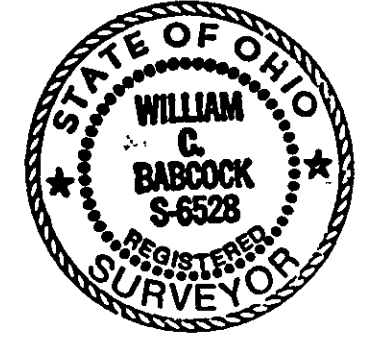

APPROVED
PAINESVILLE TOWNSHIP
ZONING DEPARTMENT
1999054
[Signature]