
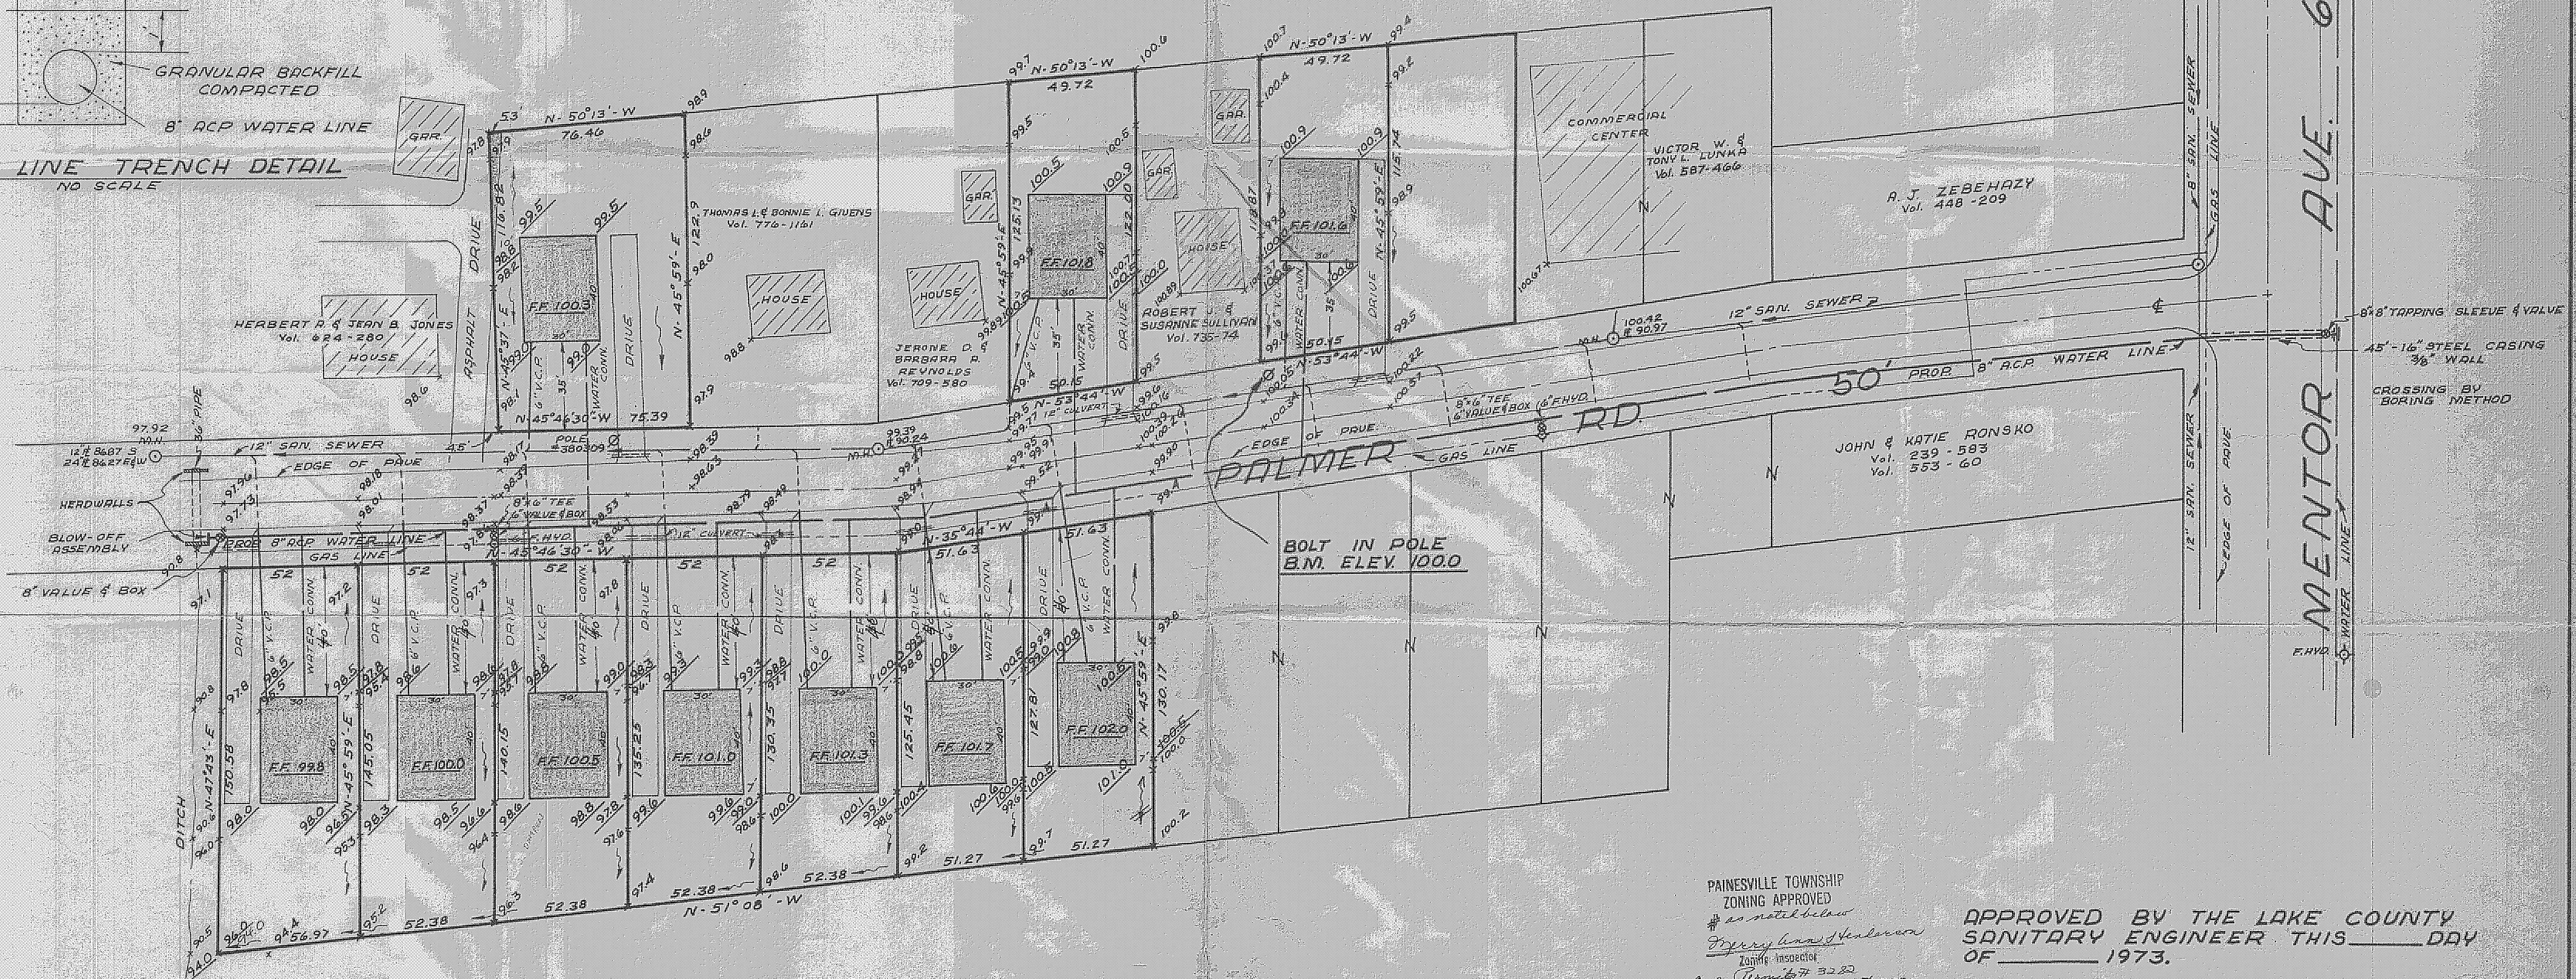


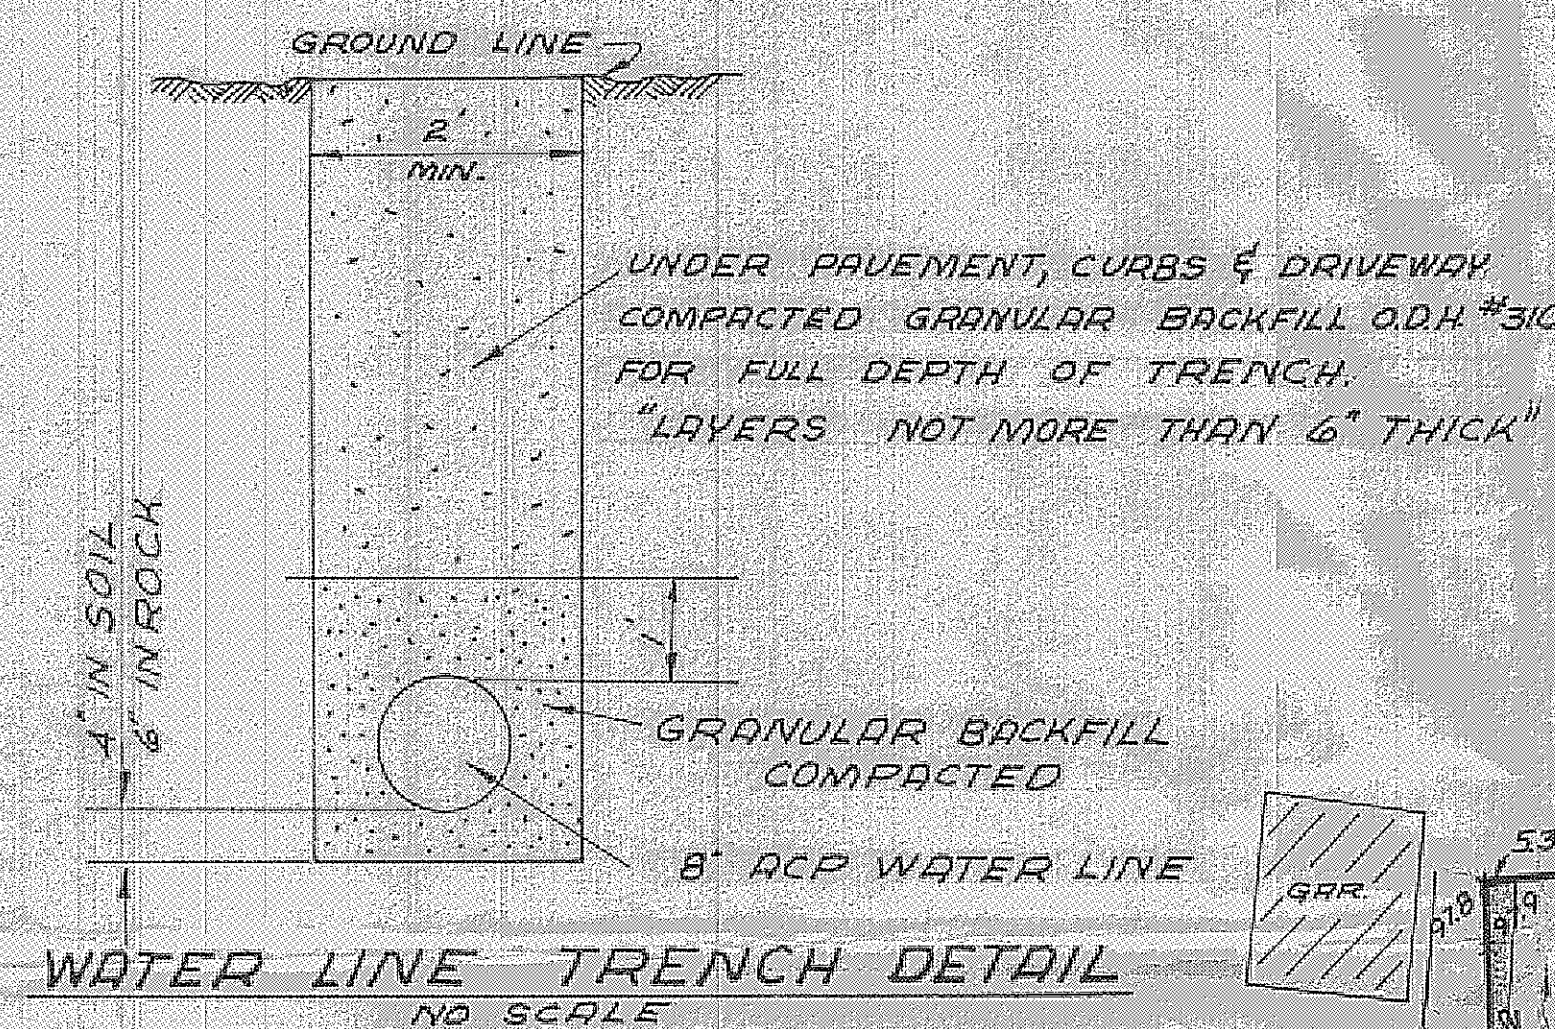

GRADING PLAN AND WATER LINE FOR

DONDORFER BROS. INC.



PART OF LOT 51
PAINESVILLE TWP., LAKE COUNTY, OHIO
SCALE: 1"=30'
AUG. 1973

PAINESVILLE TOWNSHIP
ZONING APPROVED
as noted below
Inspector
Date 9-10-73

APPROVED BY THE LAKE COUNTY
SANITARY ENGINEER THIS DAY
OF 1973.

Grading Plan Approved
as shown and/or noted
THOMAS P. GILLES, P.E.
Lake County Engineer

By J.W.K. Date 9-10-73

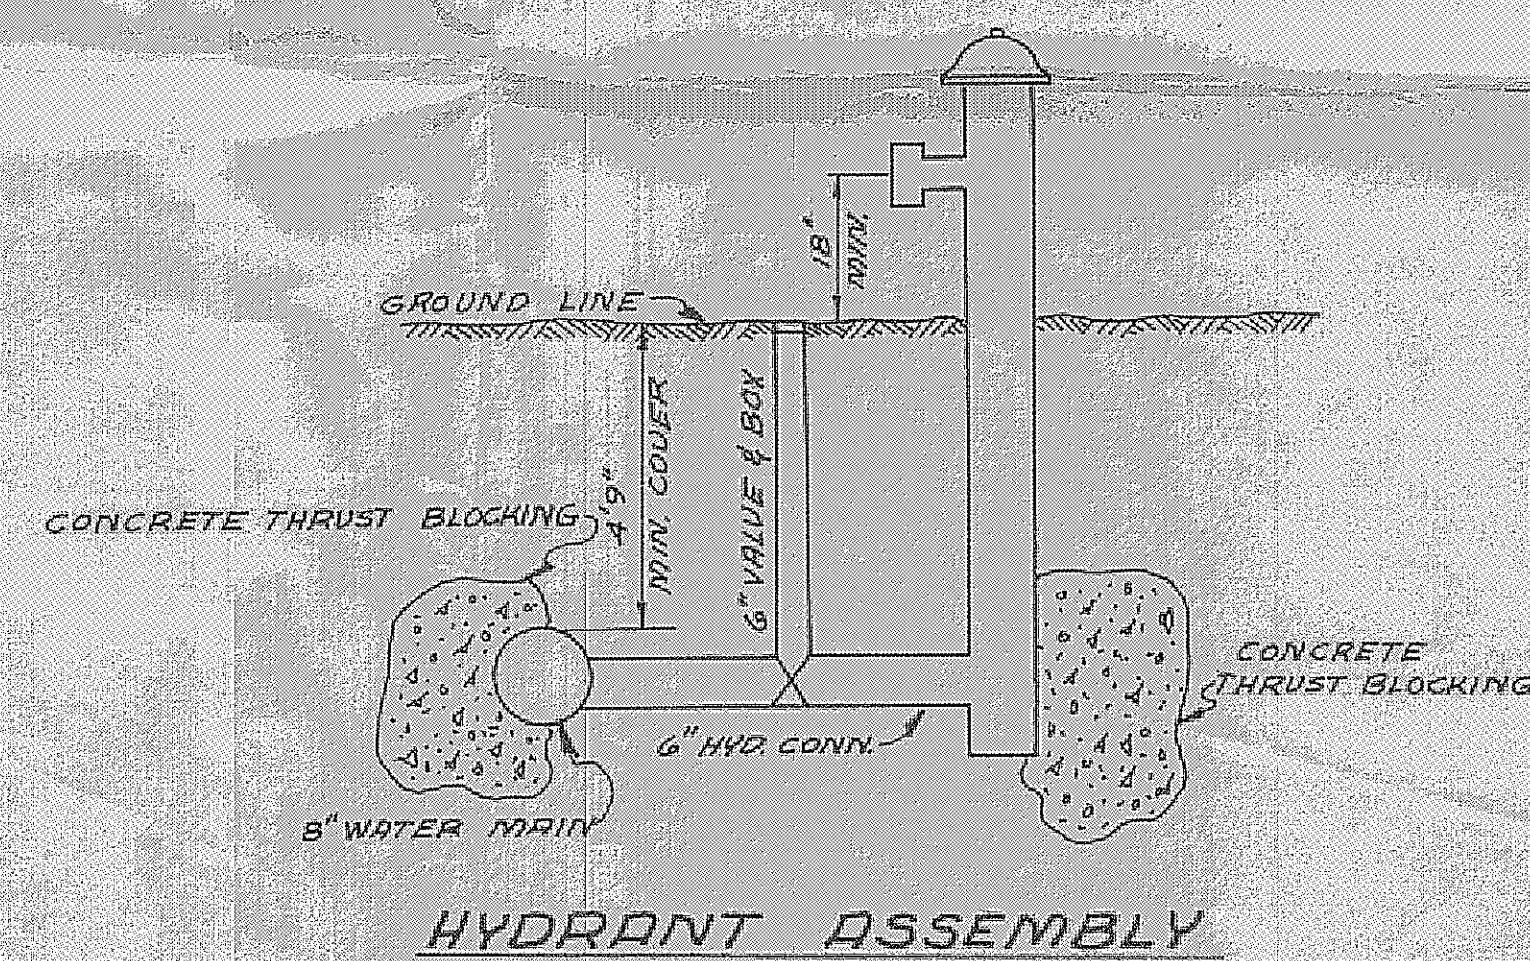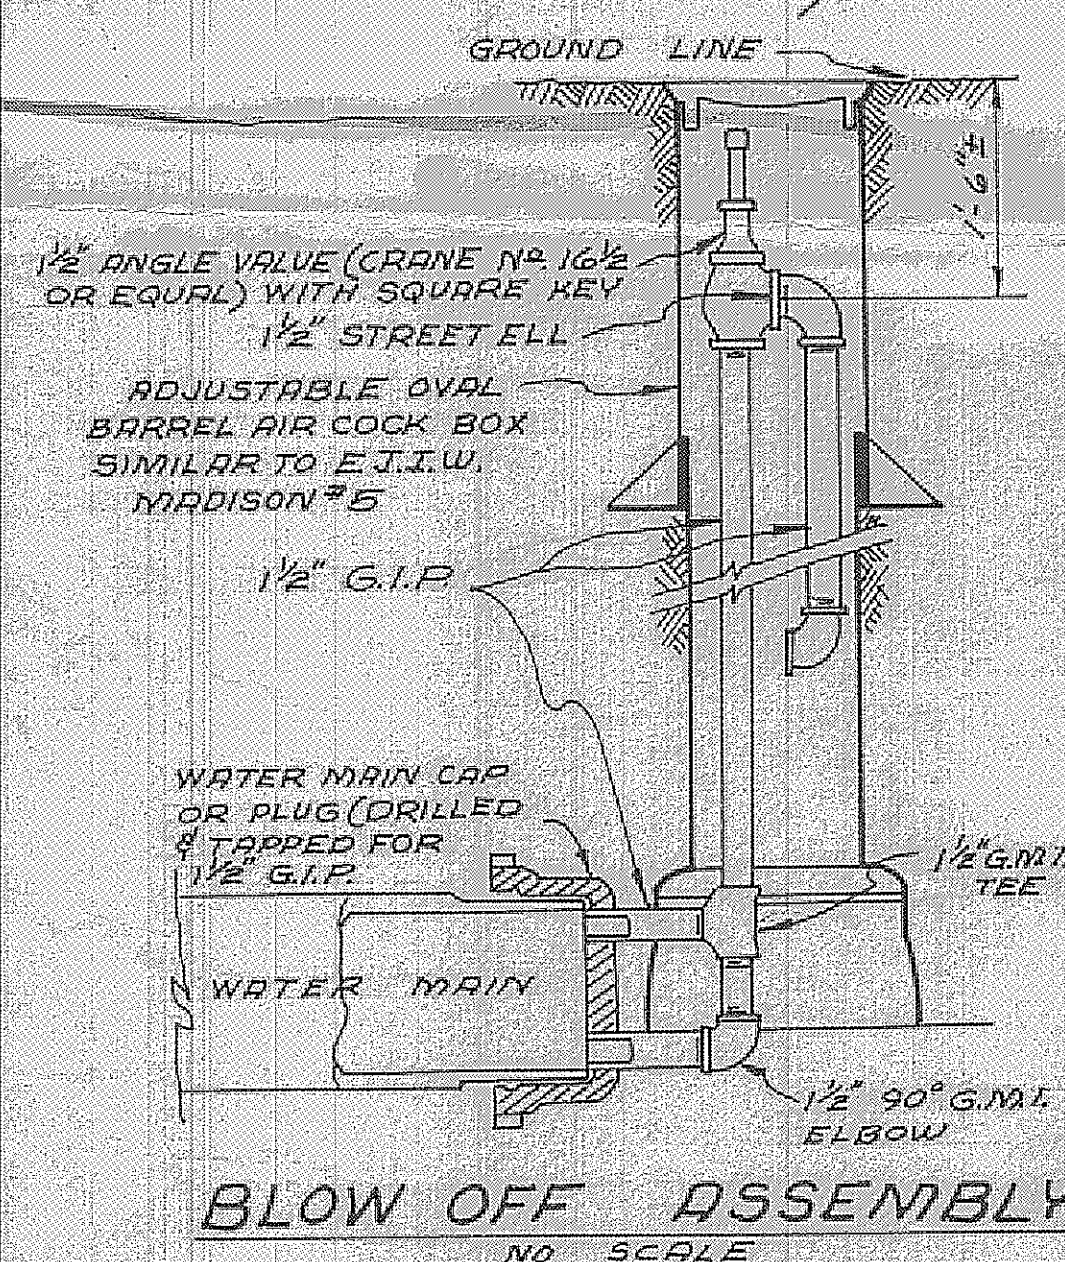

"AS BUILT" CERTIFICATION

I HEREBY CERTIFY THAT THE CIRCLED GRADES
ARE EXISTING FINISHED GRADES CHECKED IN FIELD ON
19 84

THIS SURVEY IS CORRECT TO THE BEST
OF MY KNOWLEDGE AND BELIEF

REGISTERED SURVEYOR

N.A.

COLPETZER-WOODS CONSULTANTS
CONSULTING ENGINEERS & SURVEYORS
PAINESVILLE, OHIO