

PREPARED BY
 Wilson and Associates
 Registered Surveyors
 11005 Wilson Mills Road
 Chardon, Ohio 44024
 Date: March 12, 1974
 Scale: 1"=30'

SITE PLAN

FOXFIRE TRAILS SUBDIVISION

SUBLOT NO. 7

VOLUME 5 PAGE 7

PAINESVILLE TOWNSHIP

LAKE COUNTY OHIO

for
 CASEMENT HOMES
 1251 MADISON AVE
 PAINESVILLE, OHIO

CERTIFICATION

I certify that this plat was prepared by me,
 and is correct to the best of my knowledge.

By:

Lawrence Wilson


Lawrence Wilson, Reg. Surveyor No. 5807

AS BUILT CERTIFICATION:

I certify that on _____ 1974,
 the finished grades were checked in the
 field, shown encircled, and are correct to
 the best of my knowledge.

By:

Lawrence Wilson, Reg. Surveyor No. 5807

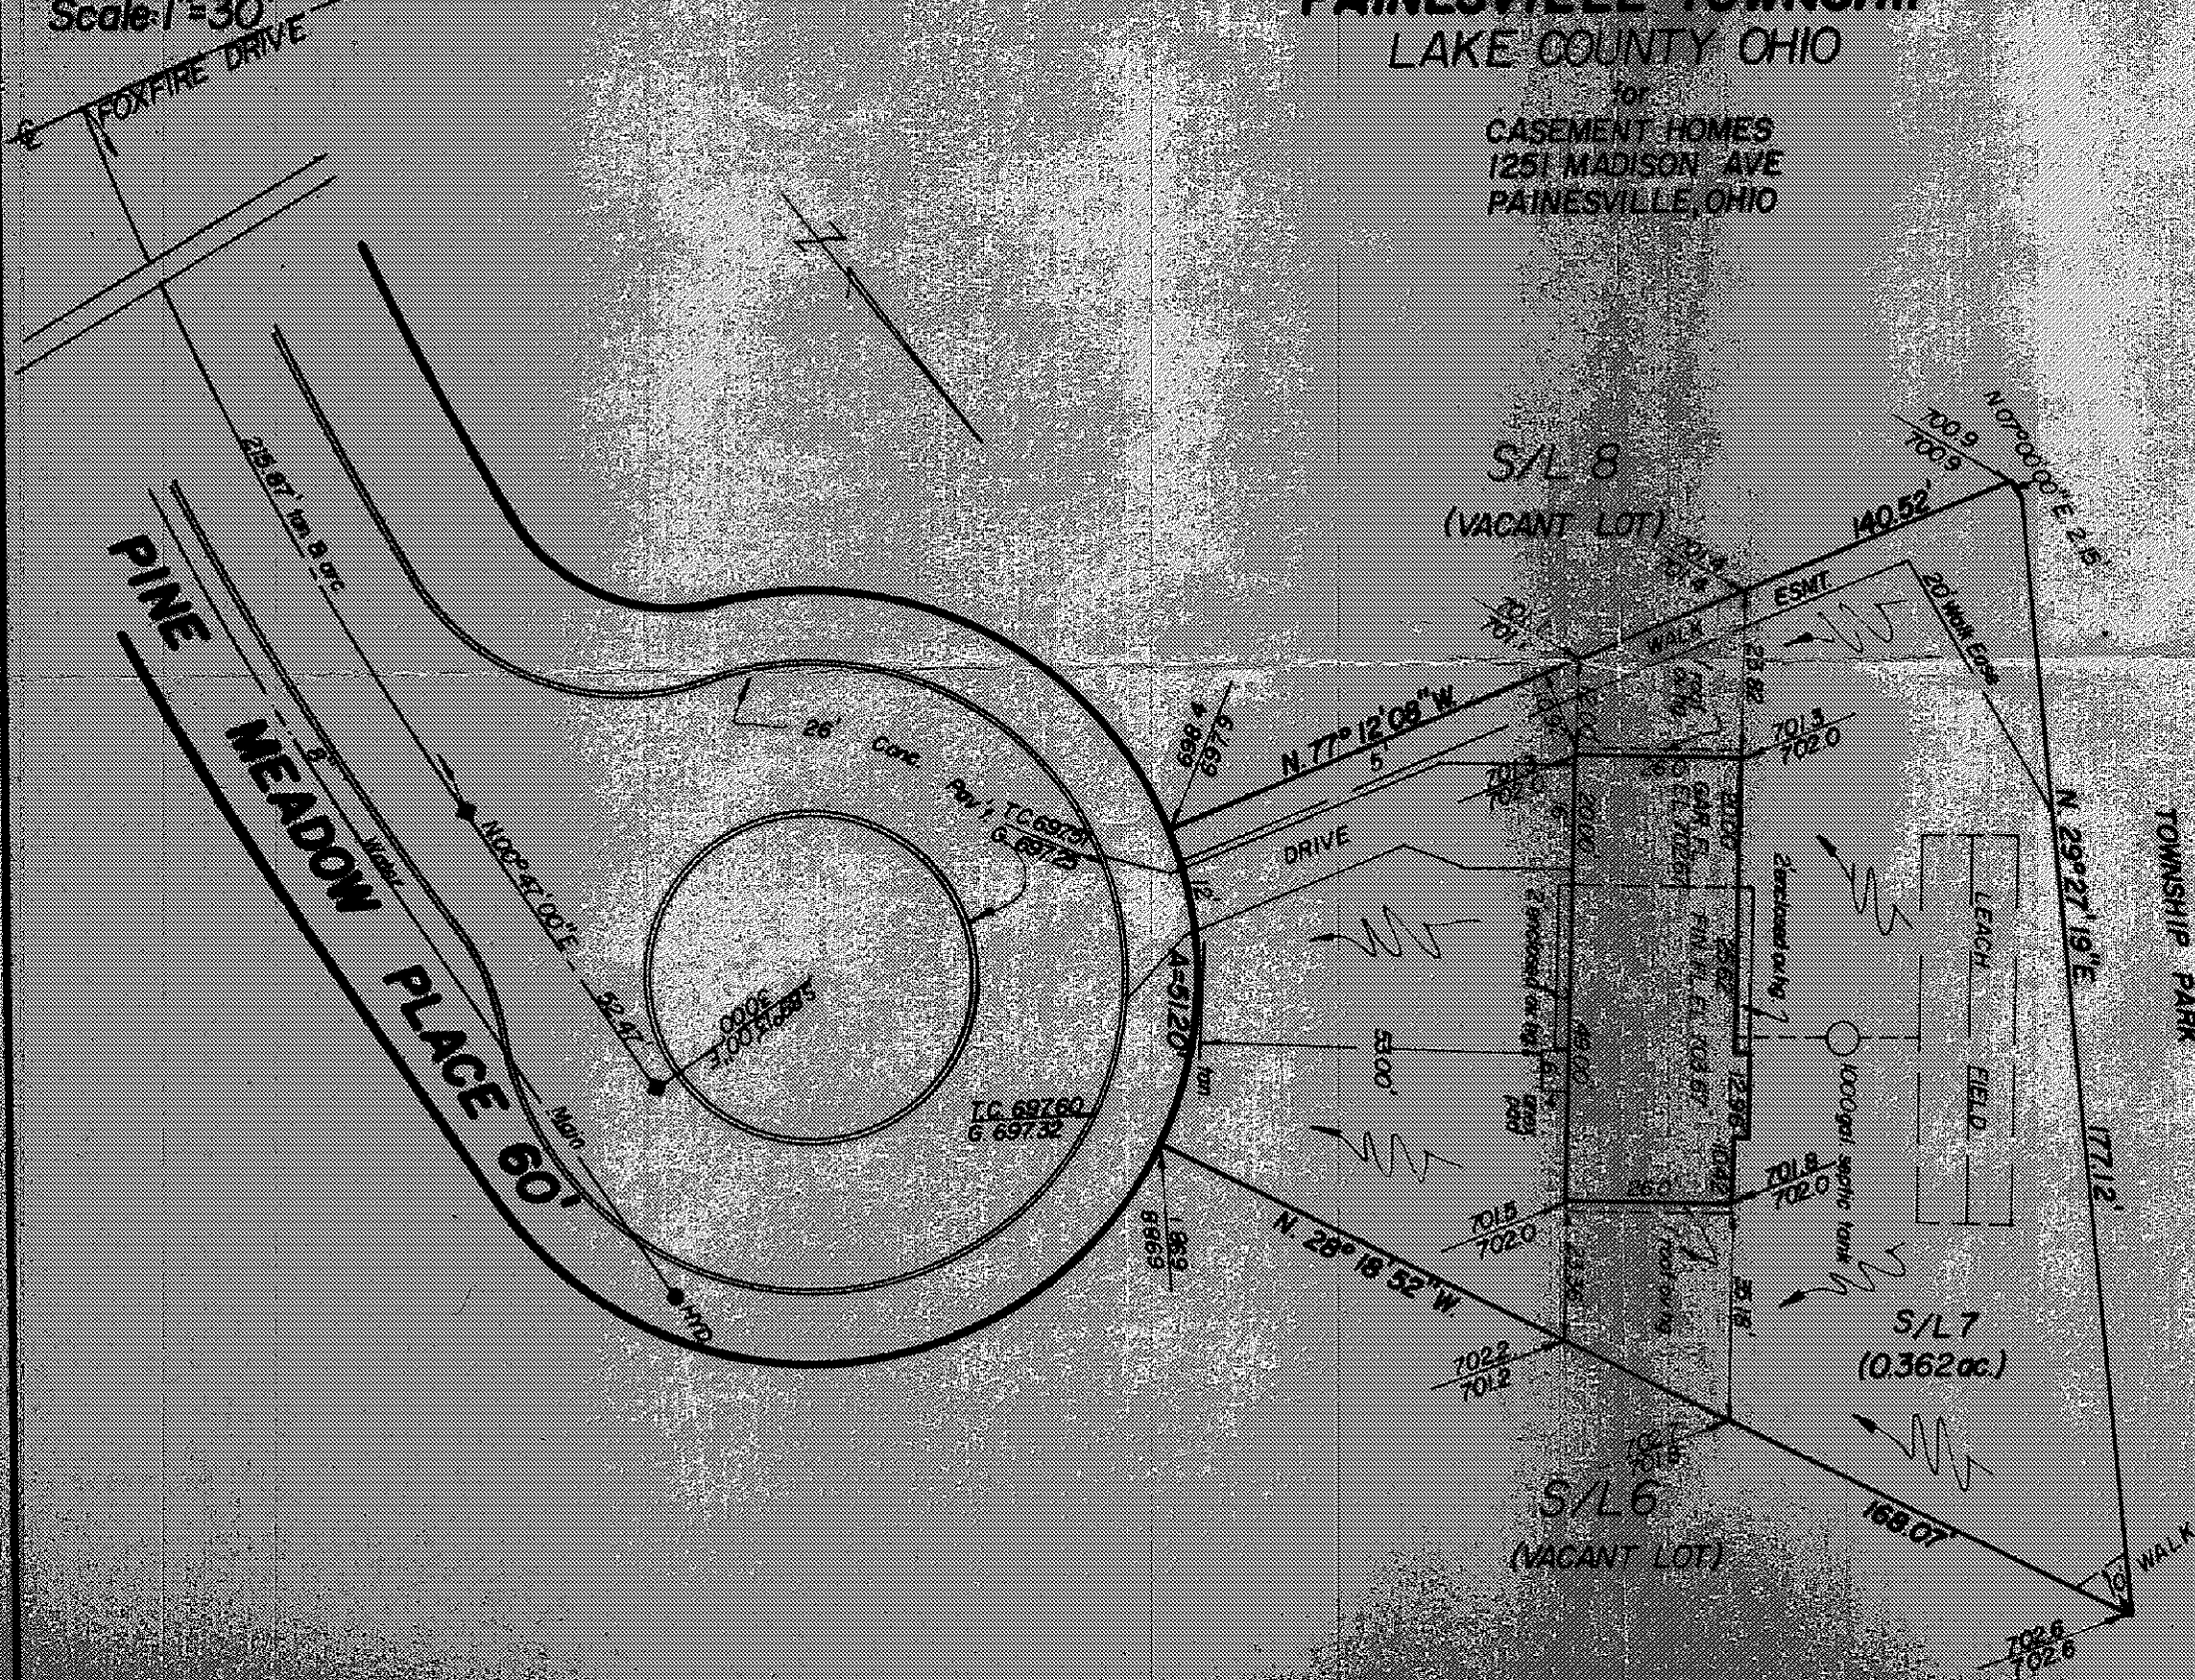

BENCH MARK MON BOX RIM AT INTERSECTION OF E'S
 OF PINE MEADOW PLACE AND FOXFIRE DRIVE
 ELEV. 696.12

EXIST. EL. 702.0
 PROPEL. 701.0

Grading Plan Approved
 as shown and/or noted
THOMAS E. GILLES, P.E.
 Lake County Engineer.

By *JWK* Date 3-14-74

PAINESVILLE TOWNSHIP
 ZONING APPROVED
 # 3412 3-14-74

Th. A. Anderson
 Zoning Inspector

