

PREPARED BY  
 Wilson and Associates  
 Registered Surveyors  
 11005 Wilson Mills Road  
 Chardon, Ohio 44024  
 Date: March 12, 1974  
 Scale: 1" = 30'

# SITE PLAN

FOXFIRE TRAILS SUBDIVISION

SUBLOT NO. 6

VOLUME 5 PAGE 7

**PAINESVILLE TOWNSHIP**

LAKE COUNTY OHIO

CASEMENT HOMES  
 1251 MADISON AVE  
 PAINESVILLE, OHIO

## CERTIFICATION

I certify that this plat was prepared by me,  
 and is correct to the best of my knowledge

By


*Lawrence Wilson*  
 Lawrence Wilson, Reg. Surveyor No. 5807

## "AS BUILT" CERTIFICATION

I certify that on \_\_\_\_\_ 1974,  
 the finished grades were checked in the  
 field, shown encircled, and are correct to  
 the best of my knowledge.

By

Lawrence Wilson, Reg. Surveyor No. 5807.

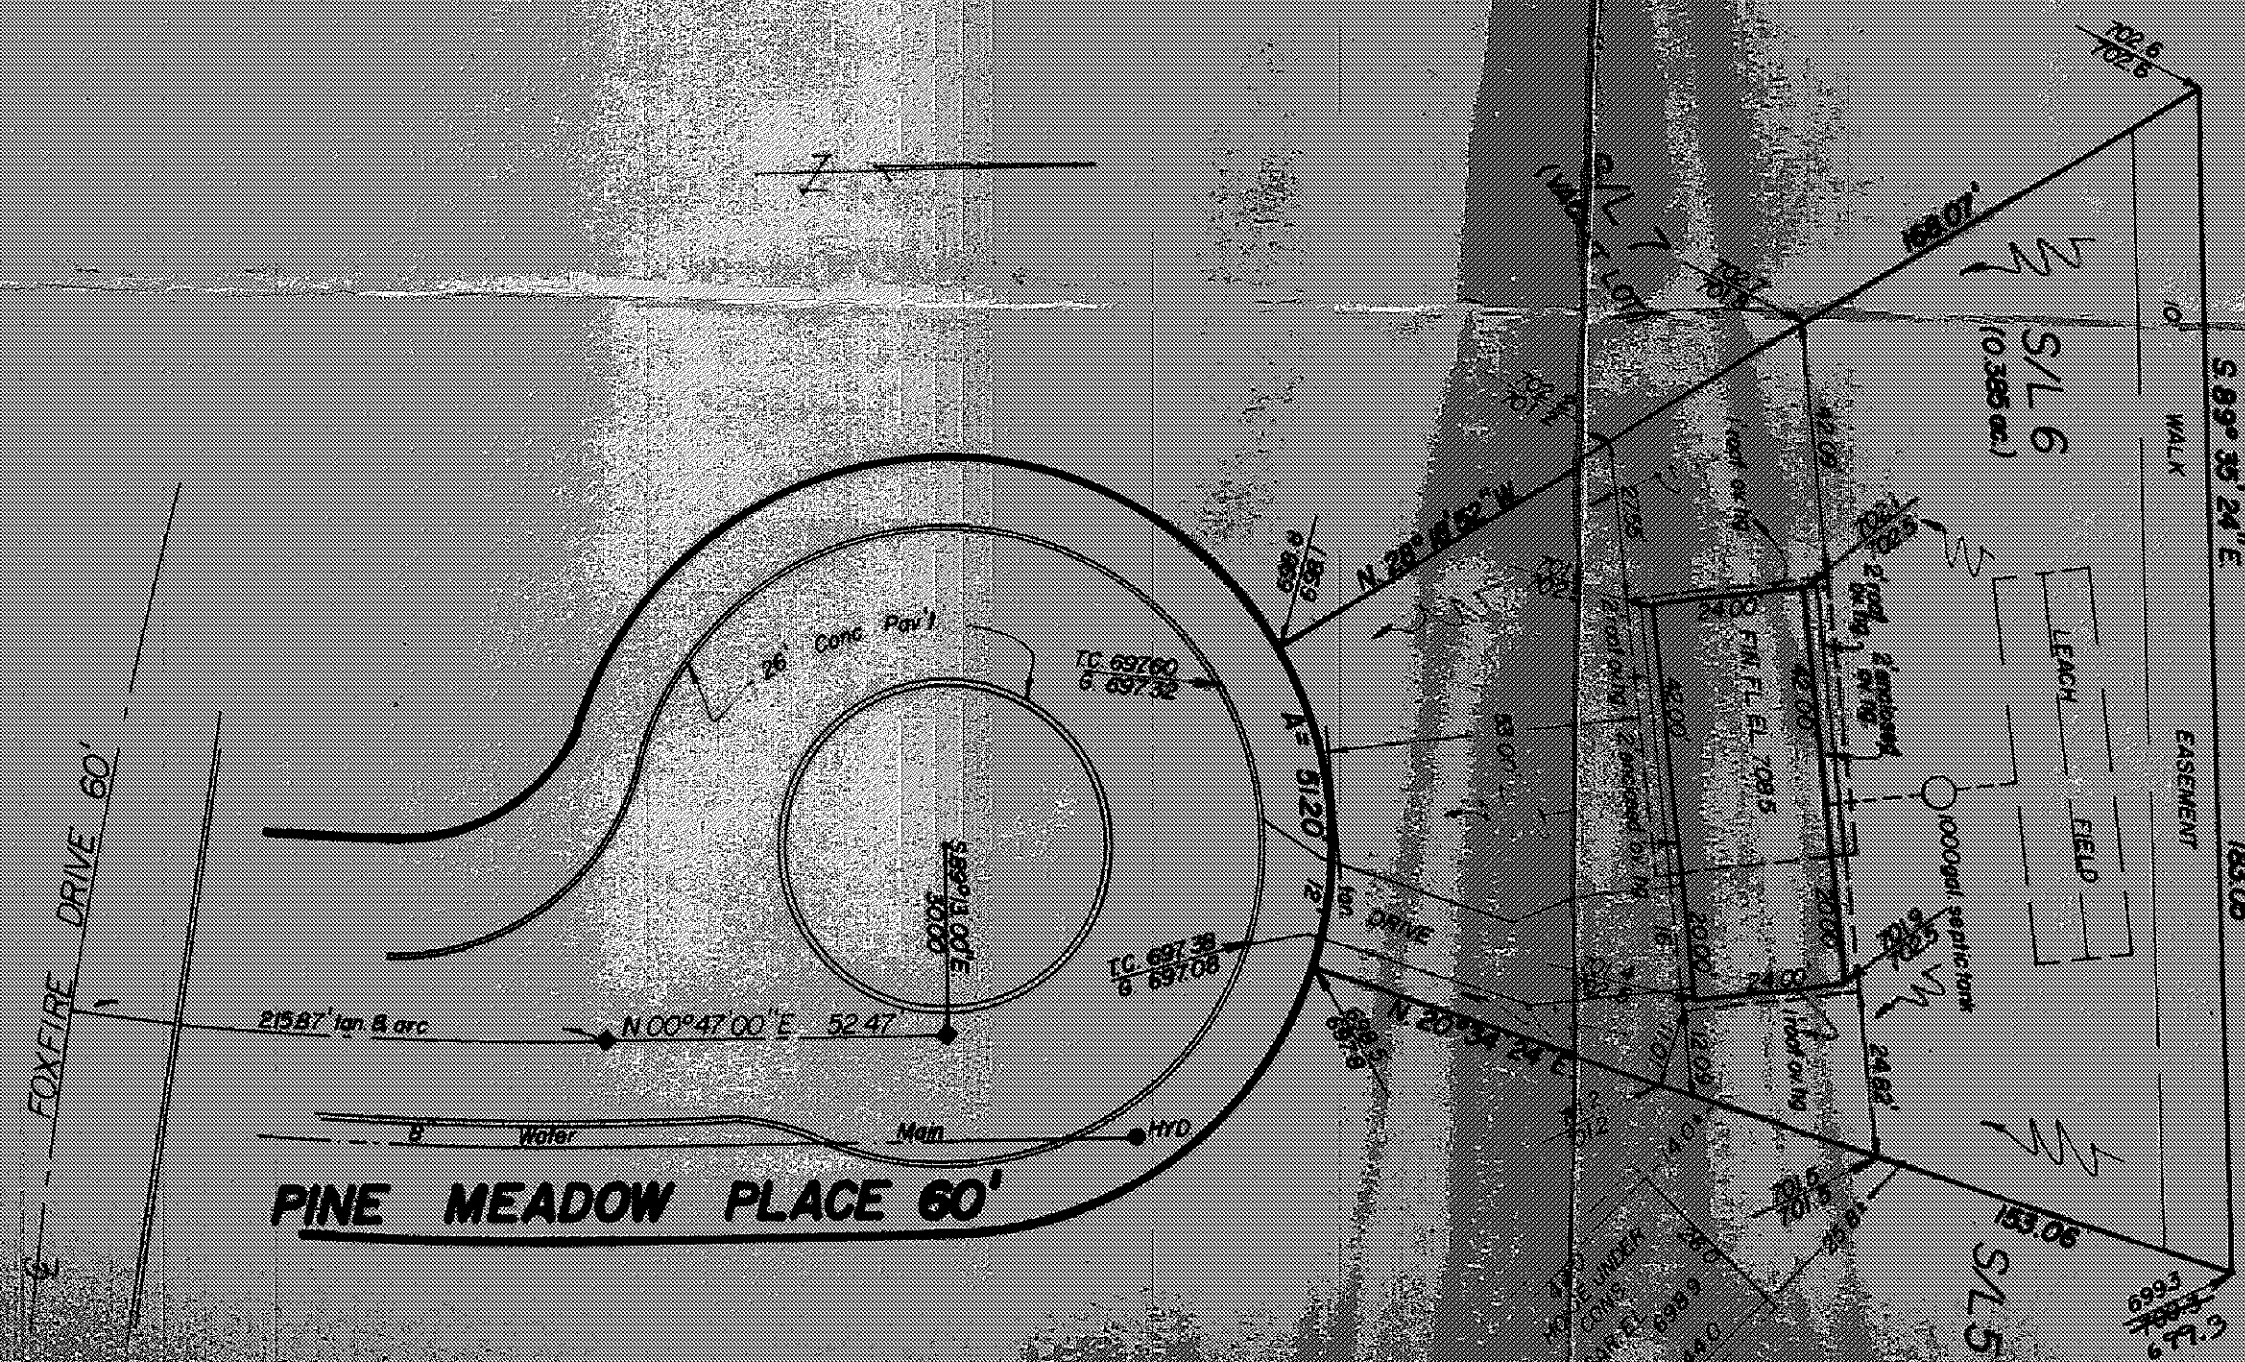

BENCH MARK: MON. BOX RIM AT INTERSECTION OF  
 PINE MEADOW PLACE AND FOXFIRE DRIVE  
 ELEV. 696.12

EXIST. EL. 702.0  
 PROP. EL. 701.0

H.G. J. & Nancy E. Dallen  
 101 574  
 Pg. 477

Grading Plan Approved  
 as shown and/or noted  
 THOMAS P. GILLES, P.E.  
 Lake County Engineer

By *JWK* Date 3-14-74

PAINESVILLE TOWNSHIP  
 ZONING APPROVED  
 #3415 3-14-74  
*W. A. Henderson*  
 Zoning Inspector

