


REVIEWED AND ACCEPTED
LAKE COUNTY GENERAL
HEALTH DISTRICT

Date 4/16/98 BY D. Gilles
Step 10' off property

SEWAGE DISPOSAL PERMIT MUST BE
OBTAINED BY A LAKE COUNTY LICENSED
INSTALLER BEFORE INSTALLATION IS
STARTED

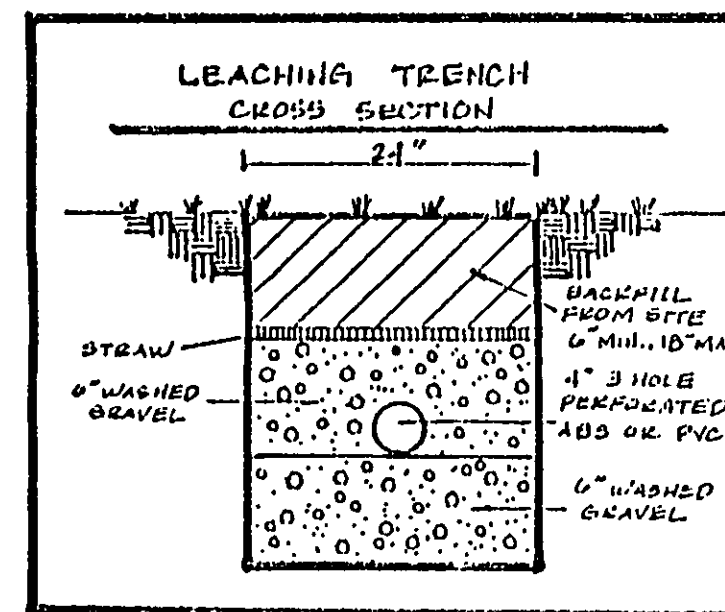

SITE PLAN

PAINESVILLE TOWNSHIP, LAKE COUNTY, OHIO

for: SELAN CONSTRUCTION

CLIENT OWNER

ADDRESS STREET CITY

| SUBDIVISION | NAME | LOT | TRACT |
|-------------|--------|------------------|--------|
| VOL.-Pg. | | VOLUME | PAGE |
| SUBLOT NO. | STREET | PERM. PARCEL NO. | STREET |

LEGEND

| | | | |
|----------------------|-------------|---------------------------|--------------------------|
| SANITARY MANHOLE | ---○--- | EXIST. ELEV. <u>100.0</u> | PROP. ELEV. <u>100.0</u> |
| STORM MANHOLE | ---●--- | AS BUILT ELEVATION | |
| INLET OR CATCH BASIN | ---○---○--- | INDICATES | |
| HYDRANT | ---●--- | DIRECTION OF | |
| EXISTING CONTOURS | ---○--- | SURFACE DRAINAGE | |
| PROPOSED CONTOURS | ---○--- | | |

REMARKS

ALL BOUNDARY DATA SHOWN WAS OBTAINED FROM (DEEDS, RECORDED
SUBDIVISION PLAT OR OTHER PUBLIC RECORDS)

LOCATIONS AS SHOWN OF ADJACENT WELLS AND SEPTIC TANKS OBTAINED FROM
LAKE COUNTY HEALTH DEPARTMENT

DESIGN CERTIFICATION

THIS PLAT WAS PREPARED BY ME, AND IS CORRECT
TO THE BEST OF MY KNOWLEDGE AND BELIEF.

NAME Harry S. Jones, Jr. SURVEYOR REGISTRATION NO. 6343

CHECK LIST

| | |
|-------------------------------|---|
| NO. OF BEDROOMS | WATER MAIN SIZE, LOCATION |
| DIMENSIONS | SAN. SEWER SIZE & GR. LOC. |
| BEARINGS | SAN. MH. CAST. ELEV. INV. ELEV. |
| TIE TO NEAREST STREET | SAN. CONN. SIZE, LOC. DEPTH |
| SUBLOT NO. PARCEL NO. | STORM SEWER SIZE & GR. LOC. |
| SURROUNDING OWNERS | STORM MH. CAST. ELEV. INV. ELEV. |
| BLDG. DIMENSIONS FIN GR. | PAVT TYPE GRADE CURBS |
| BLDG. TIES FL'R. GRADES | GAS LINE LOC. SIZE PRESSURE |
| APRON TYPE WIDTH THICKNESS | SEPTIC TANK LOCATION & DUPLICATION AREA |
| SIDEWALK TYPE WIDTH THICKNESS | WELL LOCATION |
| CULVERT TYPE DIA. LENGTH | ISOLATION RADIUS FROM WELL |
| ROCK OUTCROPPINGS | |

| REVISIONS | | | PLAN PREPARED BY: | |
|-----------|------|----|-------------------------------------|--------------|
| NO. | DATE | BY | Bj BABCOCK JONES & ASSOCIATES, INC. | |
| | | | PAINESVILLE, OHIO | |
| 1 | | | DRAWN BY T.R. | SCALE 1"=30' |
| 2 | | | CHR'D. H.J. | DATE 4/6/98 |
| 3 | | | CREW W.B. | APP'D H.J. |
| 4 | | | CHIEF | |
| 5 | | | | |

"AS BUILT" CERTIFICATION

I, HEREBY CERTIFY THAT THE CIRCLED GRADES ARE EXISTING
FINISH GRADES CHECKED IN THE FIELD ON _____, 19____
AND ARE CORRECT TO THE BEST OF MY KNOWLEDGE AND BELIEF.

REGISTERED SURVEYOR

REG. NO.

TBM-TOP HYDRANT
ELEV. 100.00

Plan Approved
and/or noted
P. GILLES, P.E.
County Engineer

63 H Date 4-28-98

APPROVED
PAINESVILLE TOWNSHIP
ZONING DEPARTMENT

19980091

"I, the undersigned hereby certify that
this topographic map was prepared by me or under my direct supervision and
that the elevations were taken at
appropriate intervals and that as of that
date they existed as indicated hereon."

Name Harry S. Jones, Jr. Reg. No. 6343

PARK ROAD - 60'