
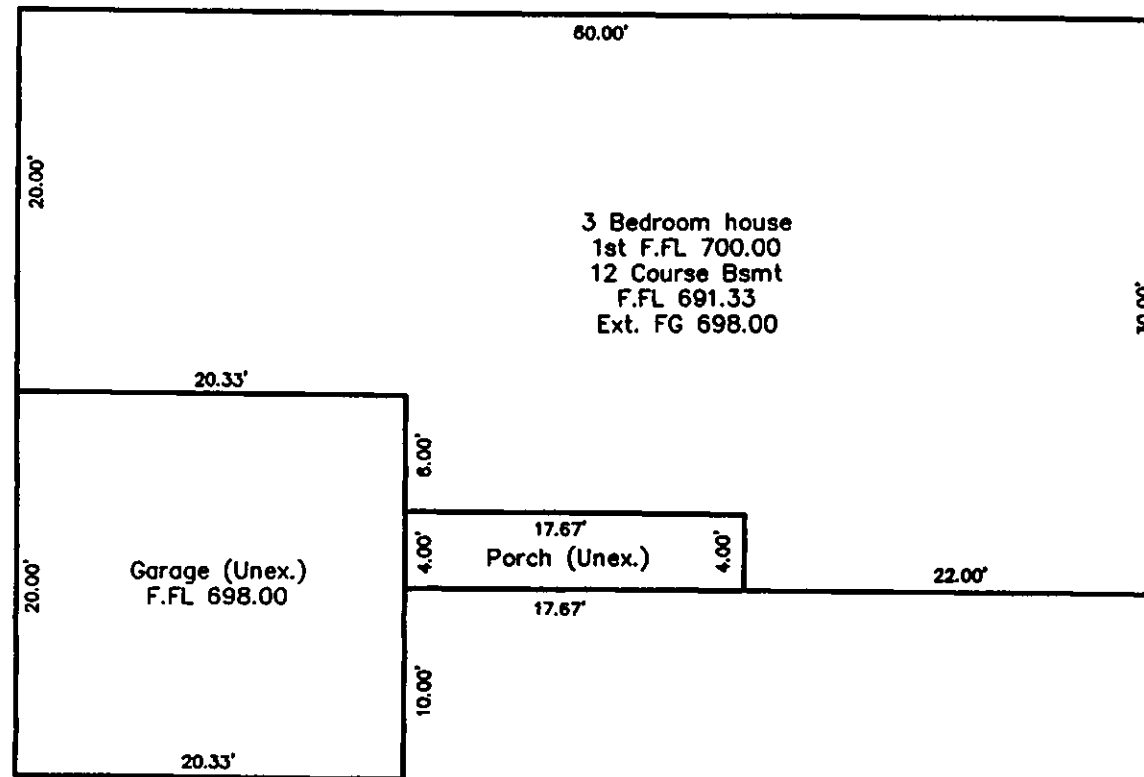
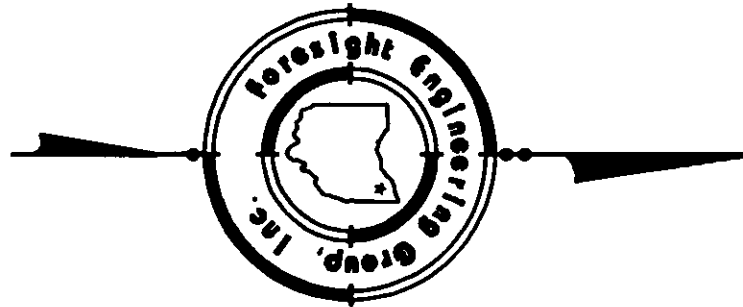



I:\saskpro\1998\19818\cad\SL59.dwg Tue Dec 15 07:56:13 1998 Copyright Foresight Engineering Group, Inc.

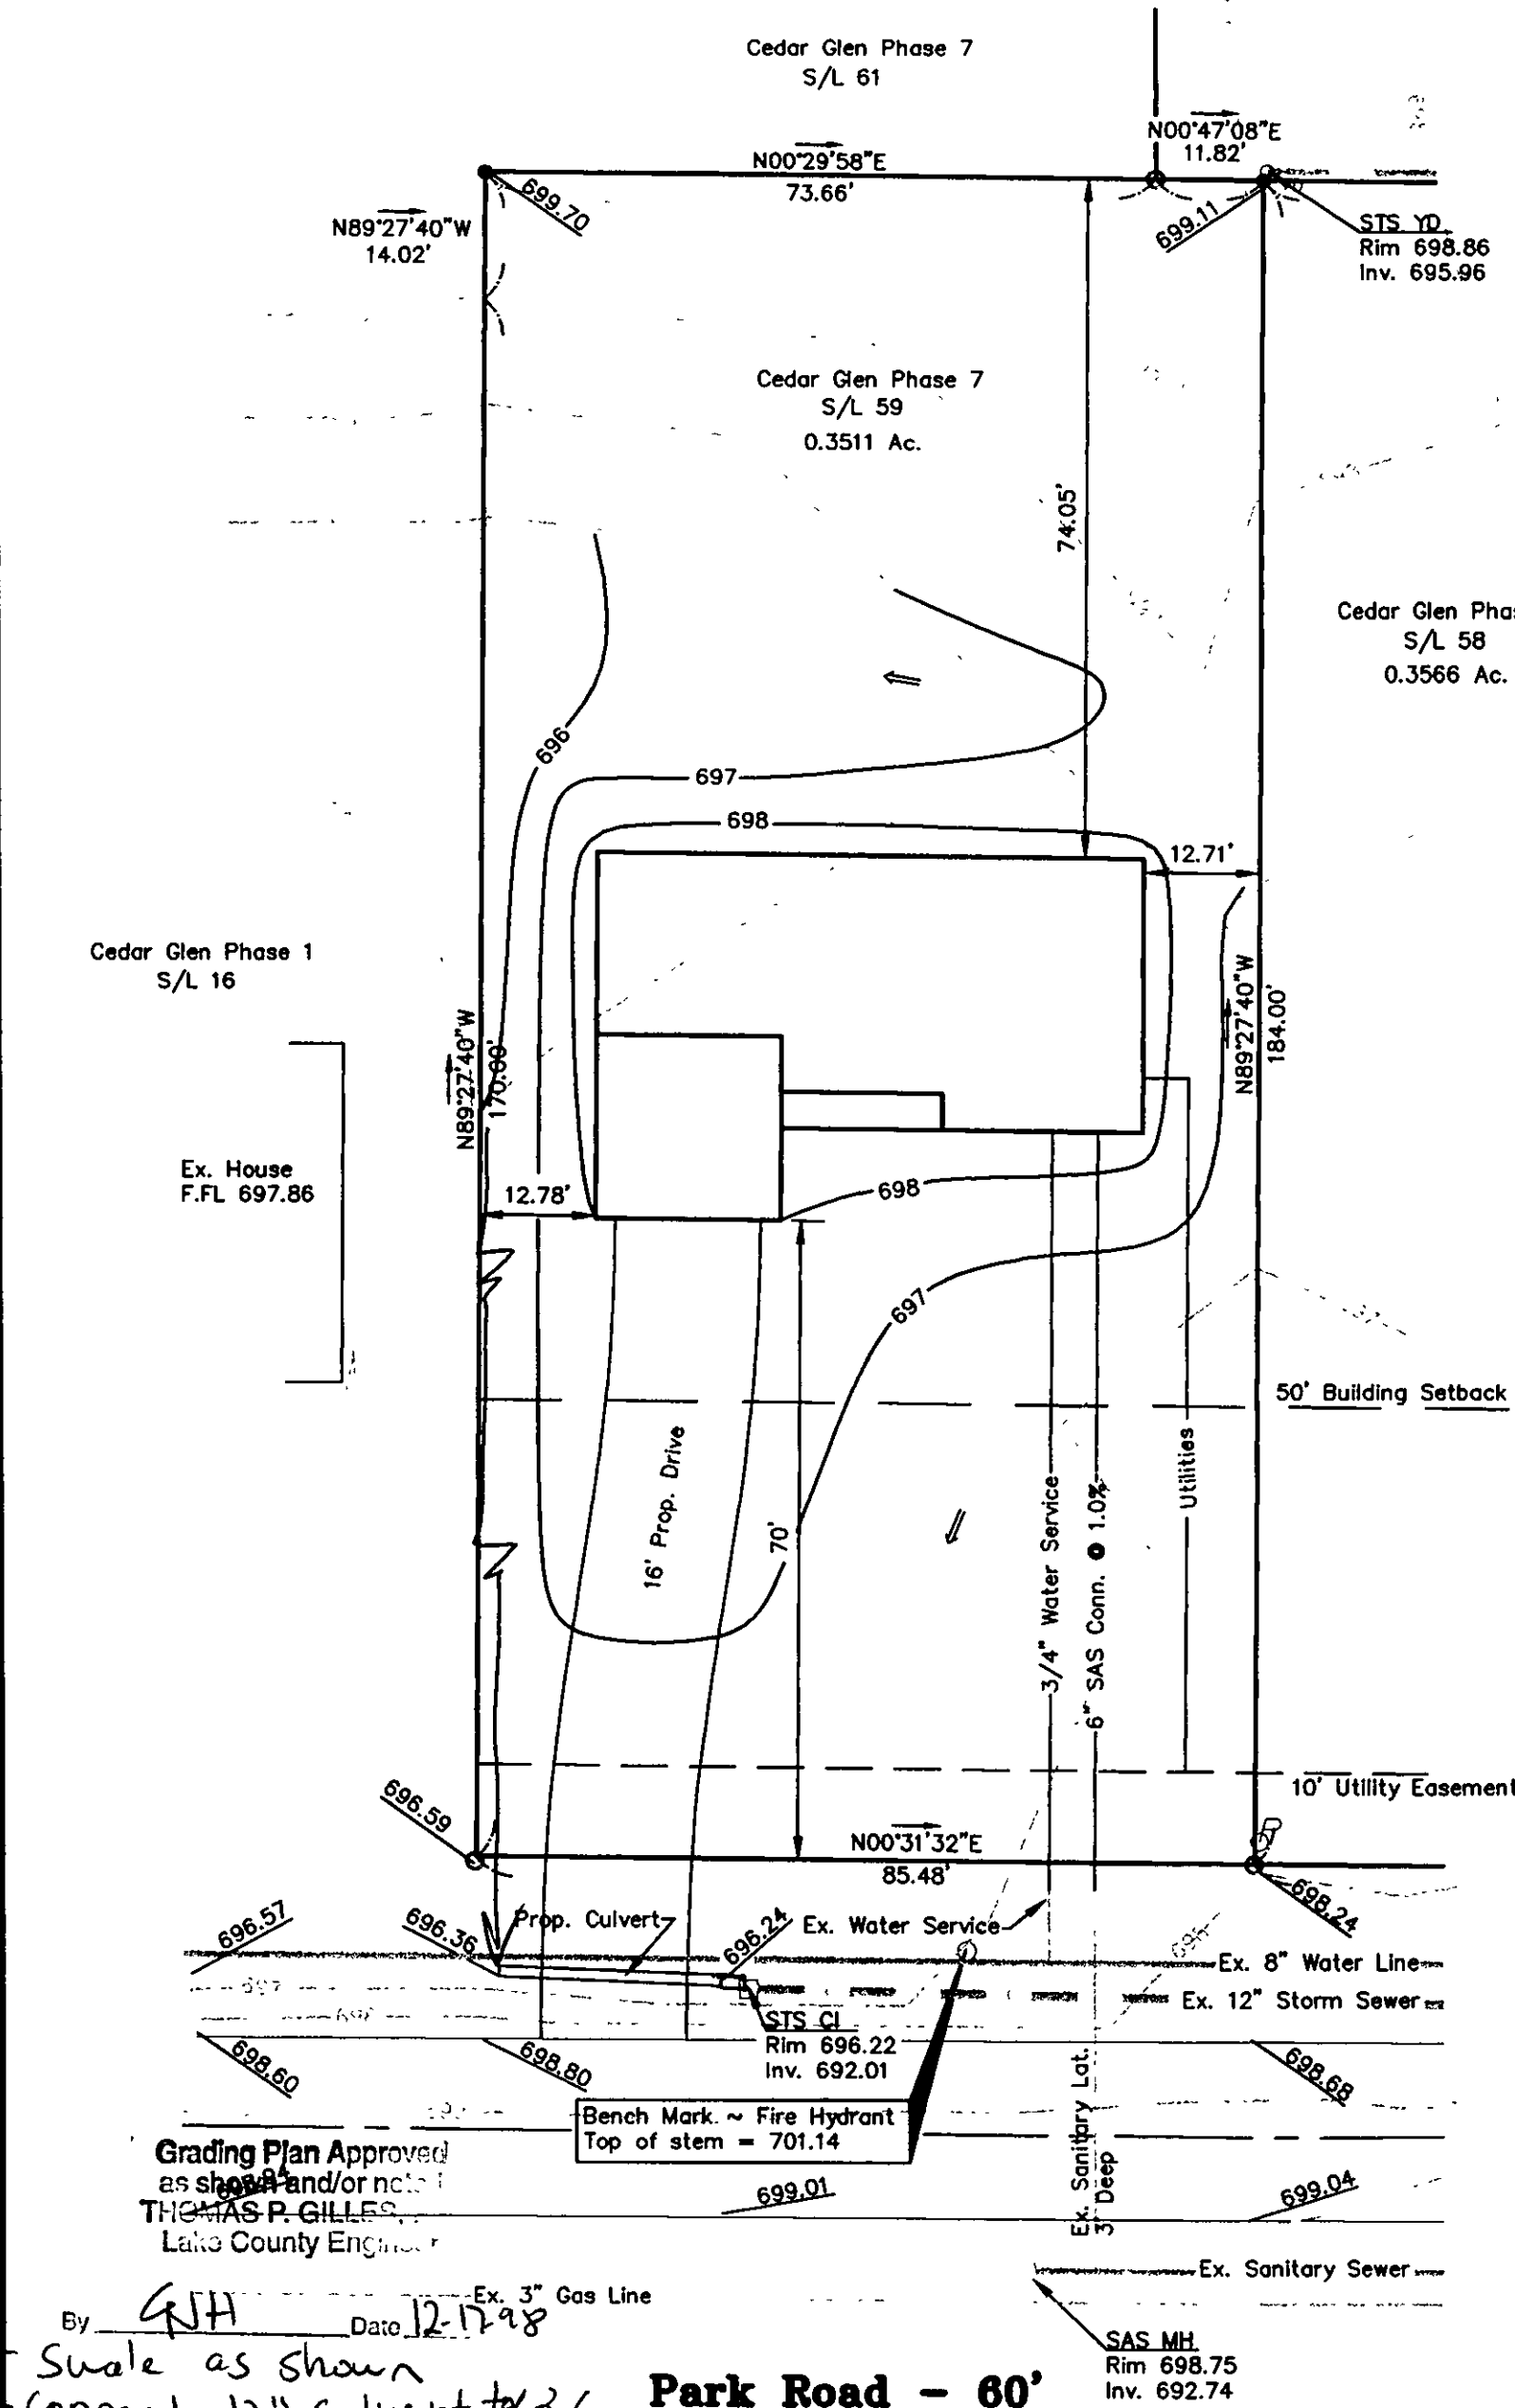

SYMBOL LEGEND	
	Iron Pin In Monument Found
	Iron Pin Found
	Fire Hydrant
	Sign
	Telephone SAC Box
	Cable TV Box
	Electrical Box
	Water Valve
	Street Sign
	Manhole
	Iron Pin Set

Zoning District R-1  
Front Setback 50'  
Side Setback 10'  
Rear Setback 25'

GRAPHIC SCALE

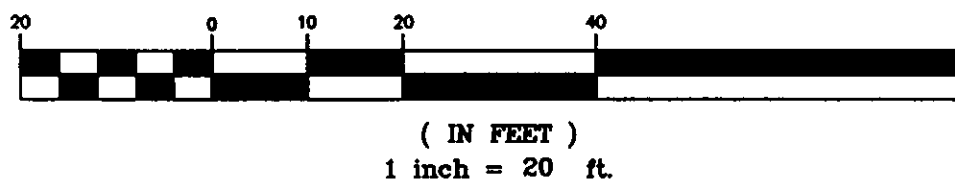

## SITE PLAN

for : R. L. Moore Homes, Inc.  
CLIENT  
7121 Revenna Road Concord, OH 44077  
ADDRESS CITY STATE ZIP

59 Ceder Glen Phase 7  
SUBLOT No. SUBDIVISION NAME VOL. PAGE  
Painesville Ohio  
LOT TRACT CITY STATE

**Foresight Engineering Group**  
Engineers & Surveyors  
440 286-1010  
440 286-1034 fax  
320 Center Street, Unit F  
Chardon, Ohio 44024

### DESIGN CERTIFICATION

This Site Plan was prepared by Foresight Engineering Group, Inc., and is correct to the best of my knowledge and belief.

Steve A. R...  
NAME

### CHECK LIST

LOT DIMENSIONS & BEARINGS  
TIE TO NEAREST STREET  
SUBLOT No. (PARCEL No.)  
SURROUNDING OWNERS  
BUILDING DIMENSIONS  
SETBACK, SIDEYARD, REARYARD  
FINISH GRADES  
DRIVE & APRON TYPE, WIDTH, THICKNESS  
SIDEWALK TYPE, WIDTH, THICKNESS  
CULVERT TYPE, DIAM., LENGTH  
WATER MAIN SIZE, LOCATION  
SAN. SEWER SIZE, % GRADE, LOC.  
SAN. MH. CAST. ELEV., INV. ELEV.  
SAN. CONN. SIZE, % GRADE, LOC.  
STORM SEWER SIZE, % GRADE, LOC.  
STORM MH. CAST. ELEV., INV. ELEV.  
PAVT TYPE, GRADE, CURBS  
GAS LINE LOC., SIZE  
SEPTIC SYSTEM & DUPLICATION  
WELL LOCATION & ISOLATION RADIUS



STATE SEAL

### "AS BUILT" CERTIFICATION

I hereby certify that the circled information is existing as obtained on the site \_\_\_\_\_ 19\_\_ and is correct to the best of my knowledge and belief.


NAME \_\_\_\_\_

SCALE : 1" = 20'	1
FILE NAME: I:\Rim19818\SL59.dwg	2
DATE : December 14, 1998	3

BENCHMARK: Fire Hydrant - Top of Stem = 701.14

"I, the undersigned hereby certify that this topography, indicated by 6", 1' or 2' contours, and the elevations shown hereon represent an actual field survey made by Foresight Engineering Group, Inc. on the 8 day of December 19 98 and that the elevations were taken at appropriate intervals and that as of that date they existed as indicated hereon."

Steve A. R...  
NAME

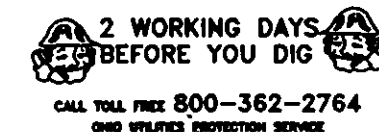

#### EXISTING UNDERGROUND UTILITIES NOTES:

The location both horizontal and vertical of the underground utilities shown hereon, have been obtained by a diligent and comprehensive search of available records. Verification by field observation, has been conducted where practical. However, Foresight Engineering Group, Inc. does not guarantee the completeness nor accuracy thereof.

Grading Plan Approved as shown and/or noted by THOMAS P. GILLER, Lake County Engineer.  
By GJH Date 12-17-98  
Swale as shown  
Connect 12" culvert to 3/1 Storm inlet  
3' minimum asphalt apron

APPROVED  
PAINESVILLE TOWNSHIP  
ZONING DEPARTMENT  
19980356 JP