

Grading Plan Approved
as shown on sheet (noted)
THOMAS P. GALLER, P.E.
Lake County Engineer
By *[Signature]* Date 7-10-86

SITE PLAN

PAINESVILLE TOWNSHIP LAKE COUNTY, OHIO

For: JAMES & SYLVIA FLORE
284 ROCKWOOD DRIVE PAINESVILLE, O. 44077
ADDRESS STREET CITY ZIP

SUBDIVISION	NAME	LOT	TRACT
VOL. - PL.		VOLUME OF	PAGE
SUBLOT NO.	STREET	10 - 35 - 34.5	ONE ROAD
		PERM. PARCEL NO.	STREET

LEGEND

SANITARY MANHOLE	WATER VALVE (GAS)
STORM MANHOLE	WATER METER (GAS)
INLET OR CATCH BASIN	AS BUILT ELEVATION
HYDRANT	INDICATES DIRECTION OF SURFACE DRAINAGE
EXISTING CONTOURS	
PROPOSED CONTOURS	
EXIST. ELEV.	PROF. ELEV.




REMARKS

ALL BOUNDARY DATA SHOWN WAS OBTAINED FROM IDEES, RECORDED SUBDIVISION PLAT OR OTHER PUBLIC RECORDS.
LOCATIONS AS SHOWN OF ADJACENT WELLS AND SEPTIC TANKS OBTAINED FROM LAKE COUNTY HEALTH DEPARTMENT

DESIGN CERTIFICATION

THIS PLAT WAS PREPARED BY ME, AND IS CORRECT TO THE BEST OF MY KNOWLEDGE AND BELIEF.

NAME SURVEYOR REGISTRATION NO.

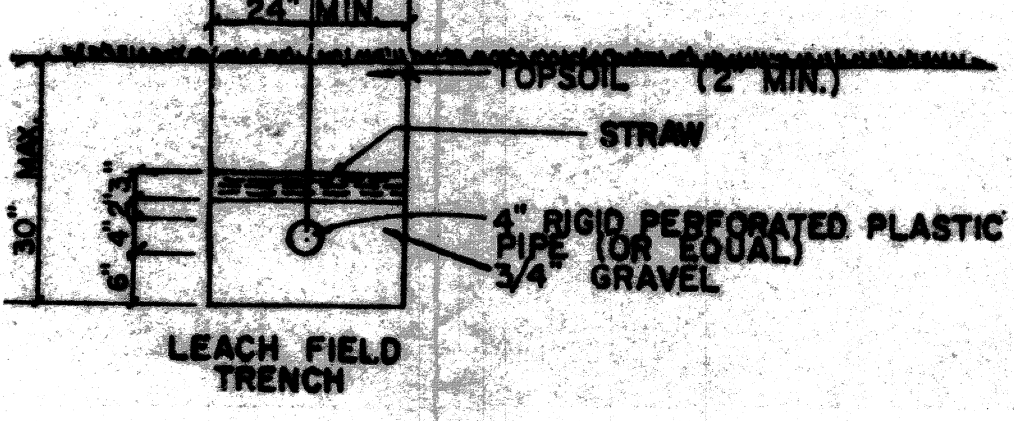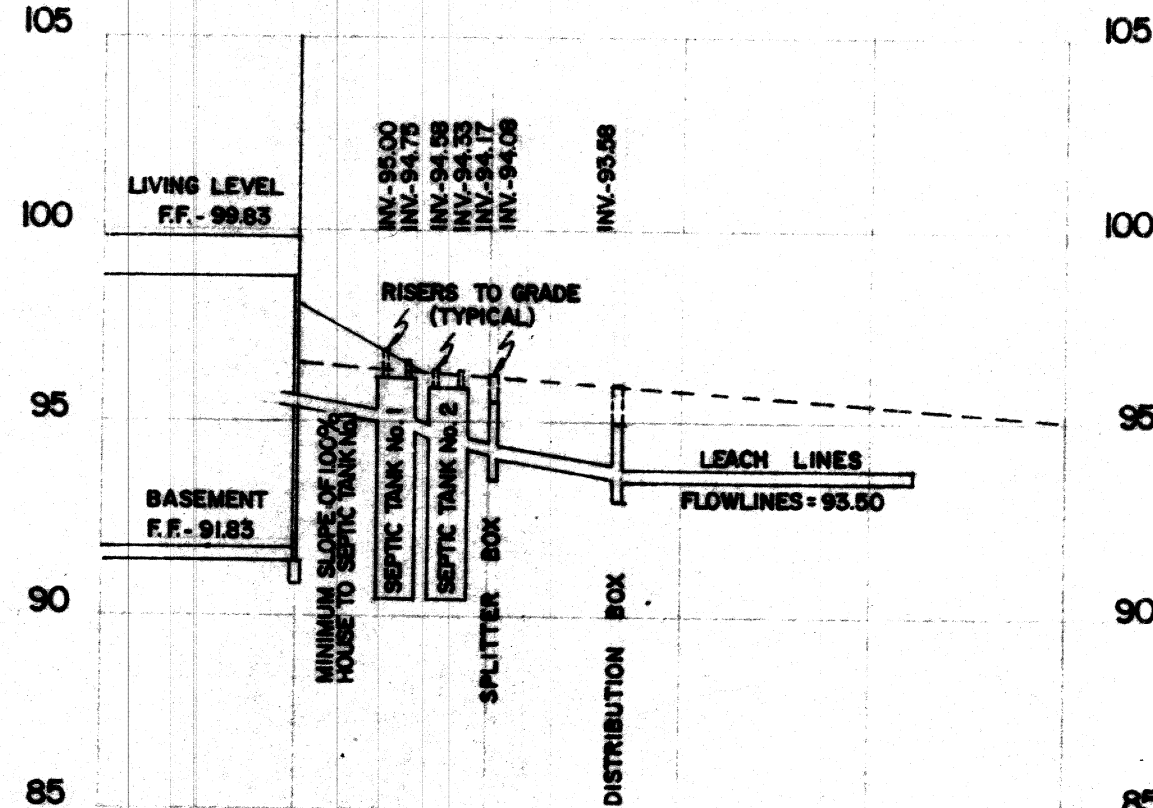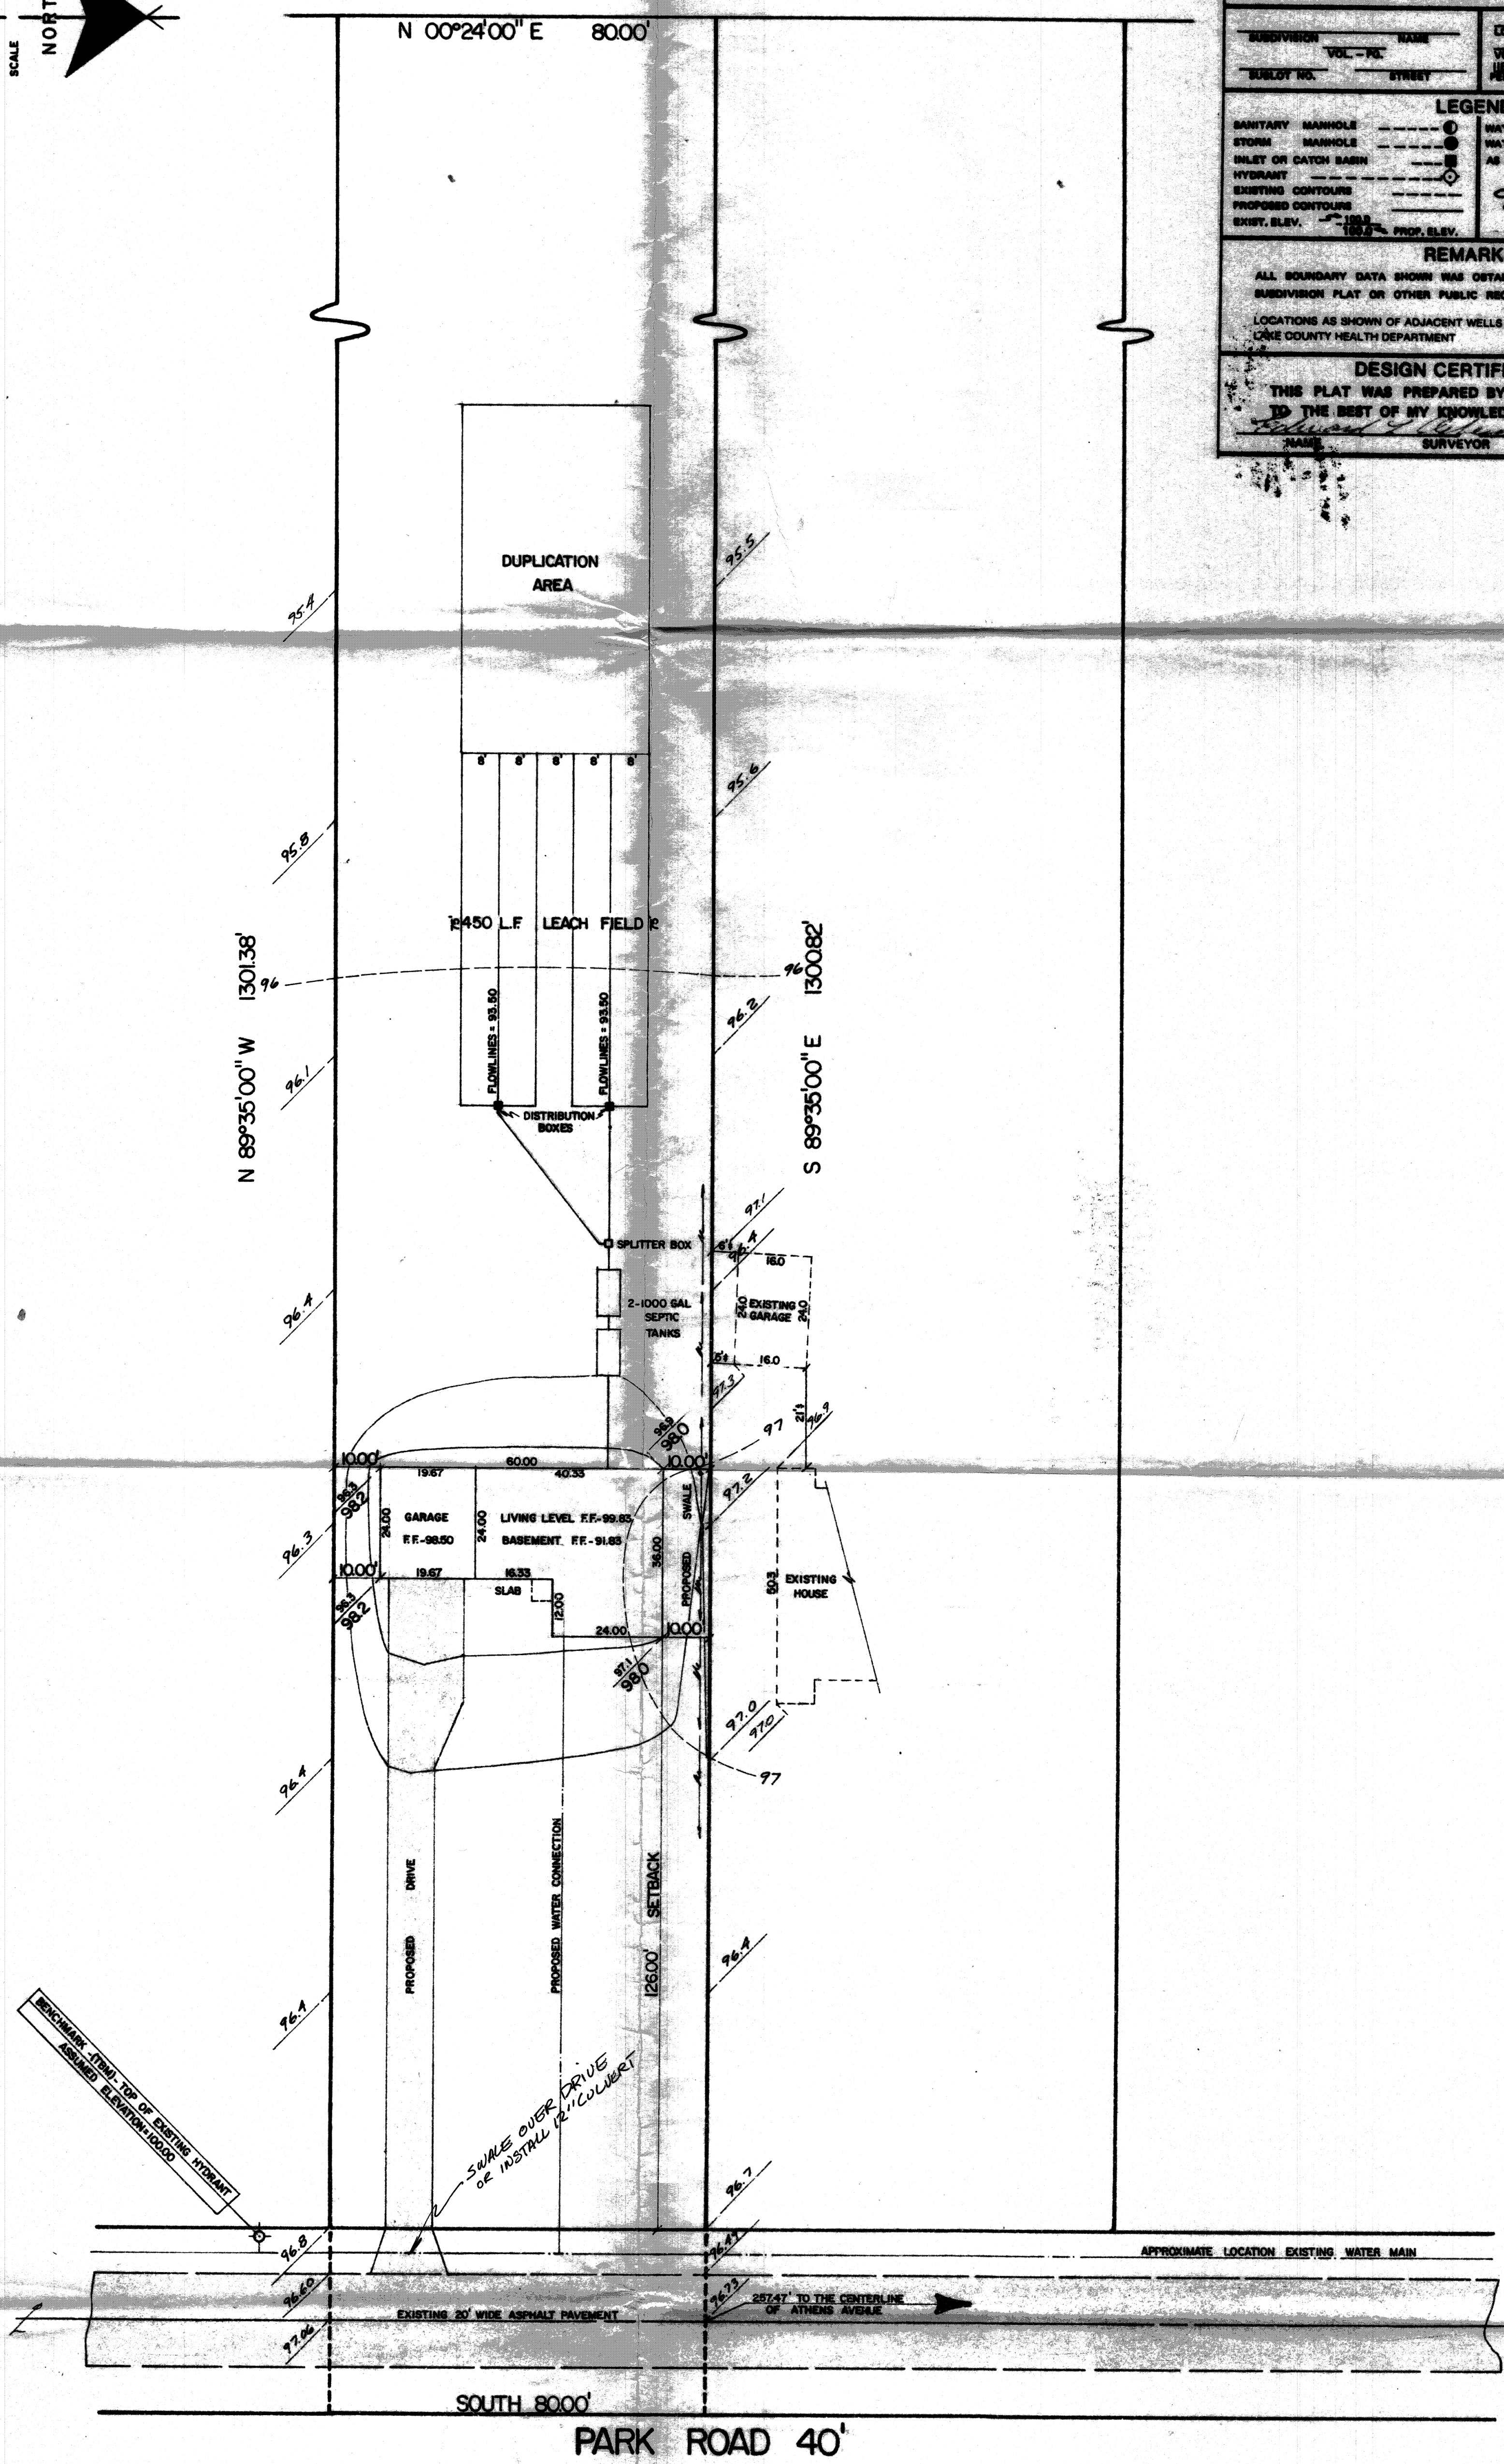

This Permit Expires
JUL 9 1987
PAINESVILLE TOWNSHIP
ZONING APPROVED
6459
R.M. Hall
Zoning Inspector 7/9/86

HYDRAULIC PROFILE
HORIZONTAL SCALE 1"=50'
VERTICAL SCALE 1"=5'
EXISTING GROUND
PROPOSED GROUND

REVISIONS			PLAN PREPARED BY:		
NO.	DATE	BY	DEBEVEC & SALO & ASSOCIATES, INC.		
1			172 NORTH ST. CLAIR STREET PAINESVILLE, OHIO		
2			DRAWN BY L.L. SCALE 1" = 20'		
3			CHECKED DATE JUNE 1986 PHONE NO. 352-9250		
4			DRAWN BY APPD. 6464		
5					