

Grading Plan Approved
 as shown under name
 THOMAS P. GALLER, P.E.
 Lake County Engineer

By *Tom* Date 7-10-86

SITE PLAN

PAINESVILLE LAKE COUNTY, OHIO
 For: JAMES & SYLVIA FLORE
 284 ROCKWOOD DRIVE PAINESVILLE, O. 44077

SUBDIVISION	NAME	IS & M	TRACT
VOL - PL			
SUBDY NO.	STREET	VOLUME OF 1/4 - 3/4 - 1/2 - 1/4	PAGE PAGE ROAD STREET

LEGEND





SANITARY MANHOLE --- (Symbol) ---
 STORM MANHOLE --- (Symbol) ---
 INLET OR CATCH BASIN --- (Symbol) ---
 HYDRANT --- (Symbol) ---
 EXISTING CONTOURS --- (Symbol) ---
 PROPOSED CONTOURS --- (Symbol) ---
 EXIST. ELEV. --- (Symbol) ---
 PROP. ELEV. --- (Symbol) ---

WATER VALVE (GAS) --- (Symbol) ---
 WATER METER (GAS) --- (Symbol) ---
 AS BUILT ELEVATION --- (Symbol) ---
 INDICATES DIRECTION OF SURFACE DRAINAGE --- (Symbol) ---

REMARKS

ALL BOUNDARY DATA SHOWN WAS OBTAINED FROM IDEEDS, RECORDED SUBDIVISION PLAT OR OTHER PUBLIC RECORDS
 LOCATIONS AS SHOWN OF ADJACENT WELLS AND SEPTIC TANKS OBTAINED FROM LAKE COUNTY HEALTH DEPARTMENT

DESIGN CERTIFICATION
 THIS PLAT WAS PREPARED BY ME, AND IS CORRECT TO THE BEST OF MY KNOWLEDGE AND BELIEF.
 Thomas P. Galler, P.E.
 SURVEYOR REGISTRATION NO. 1514

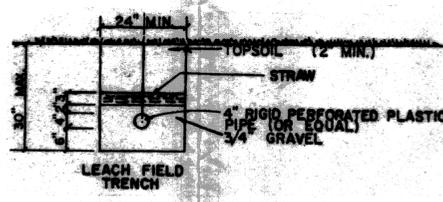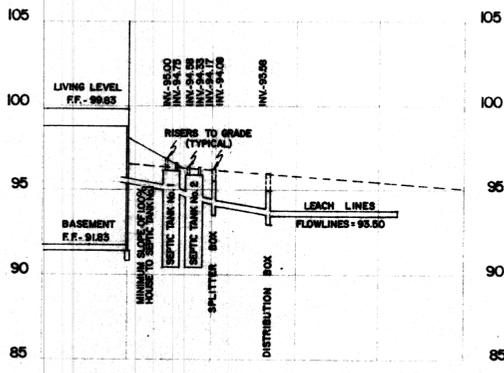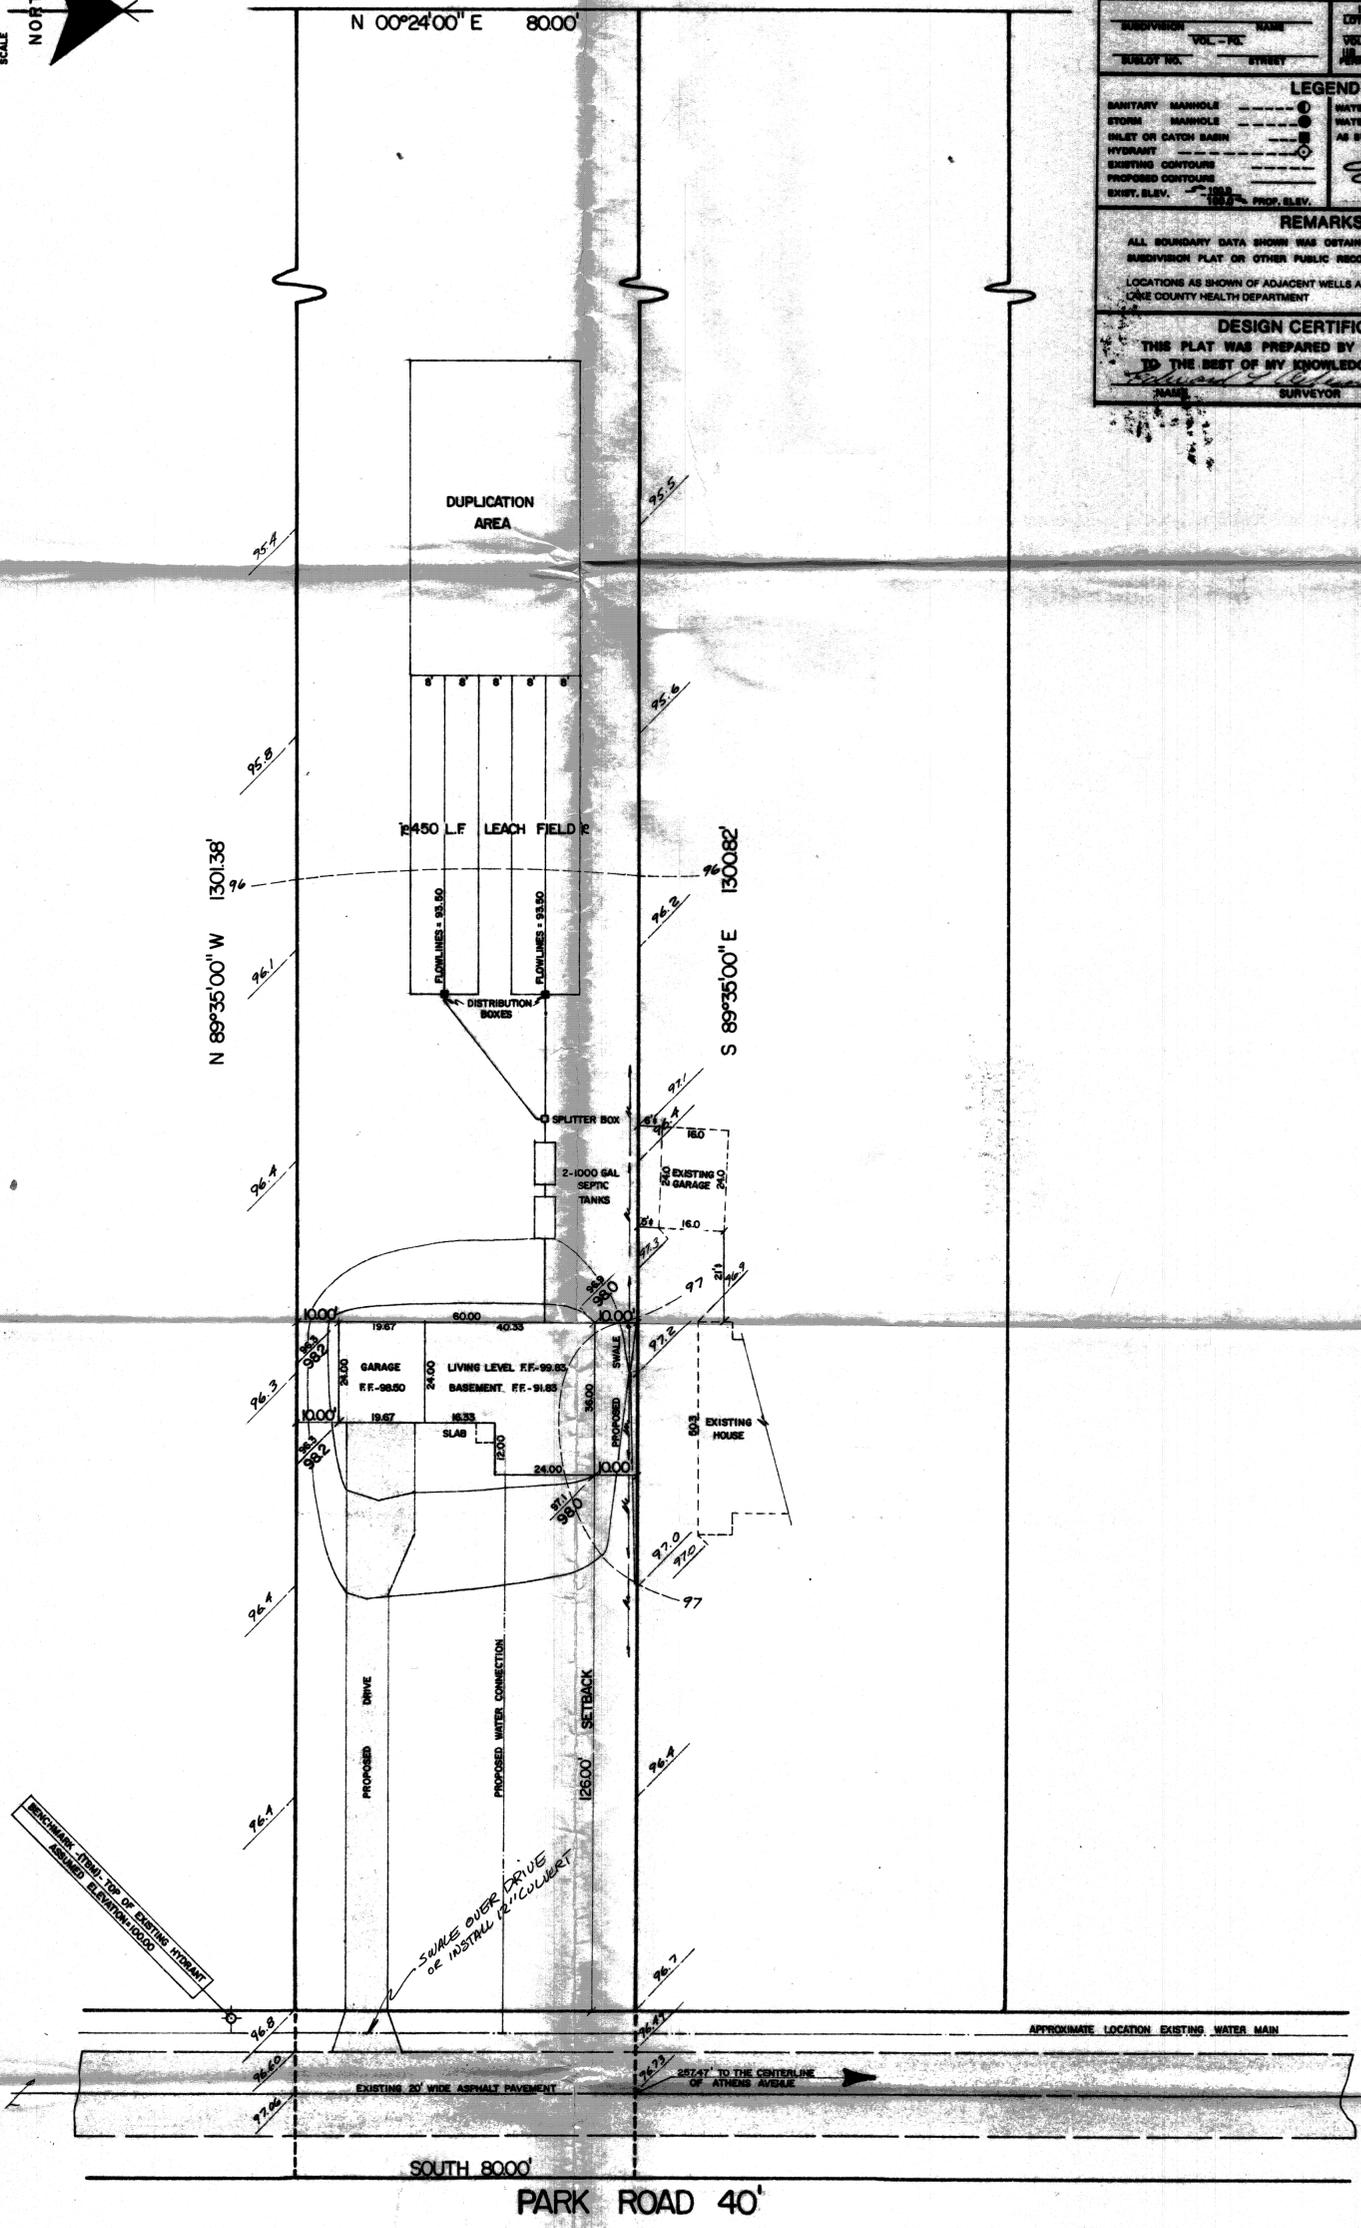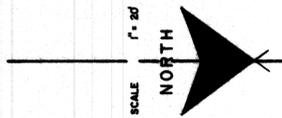

HYDRAULIC PROFILE
 HORIZONTAL SCALE 1" = 50' EXISTING GROUND ---
 VERTICAL SCALE 1" = 5' PROPOSED GROUND ---

This Permit Expires
JUL 9 1987
 PAINESVILLE TOWNSHIP
 ZONING APPROVED
 # 12459
R.M. Stark
 Zoning Inspector 7/9/86

REVISIONS			PLAN PREPARED BY:		
NO.	DATE	BY	DEBEVEC & SALO & ASSOCIATES, INC.		
1			172 NORTH ST. CLAIR STREET PAINESVILLE, OHIO		
2			DRAWN BY	SCALE 1" = 20'	PROJECT NO. 332-9250
3			CHK'D.	DATE JUNE 1986	DRAWING NO.
4			DATE	APPR.	6464
5			DATE		