

HARRIET M. NICHOLS
VOL. 172, PG. 952

S 02°15'00" W
94.00'

S/L 1
0.696 AC.

S/L 2
0.696 AC.

S/L 3
0.696 AC.

322.34'

322.34'

DUPLICATION
AREA

SPLITTER BOX
DISTRIBUTION BOX


2, 1,000 GAL. SEPTIC TANKS

EXISTING HOUSE
FIN. FLR. ELEV. =
593.30


EXISTING FIRE HYDRANT
BENCHMARK TOP STEM OF FIRE HYDRANT
ELEV. = 692.30

N 02°15'00" E


PARK ROAD 40'

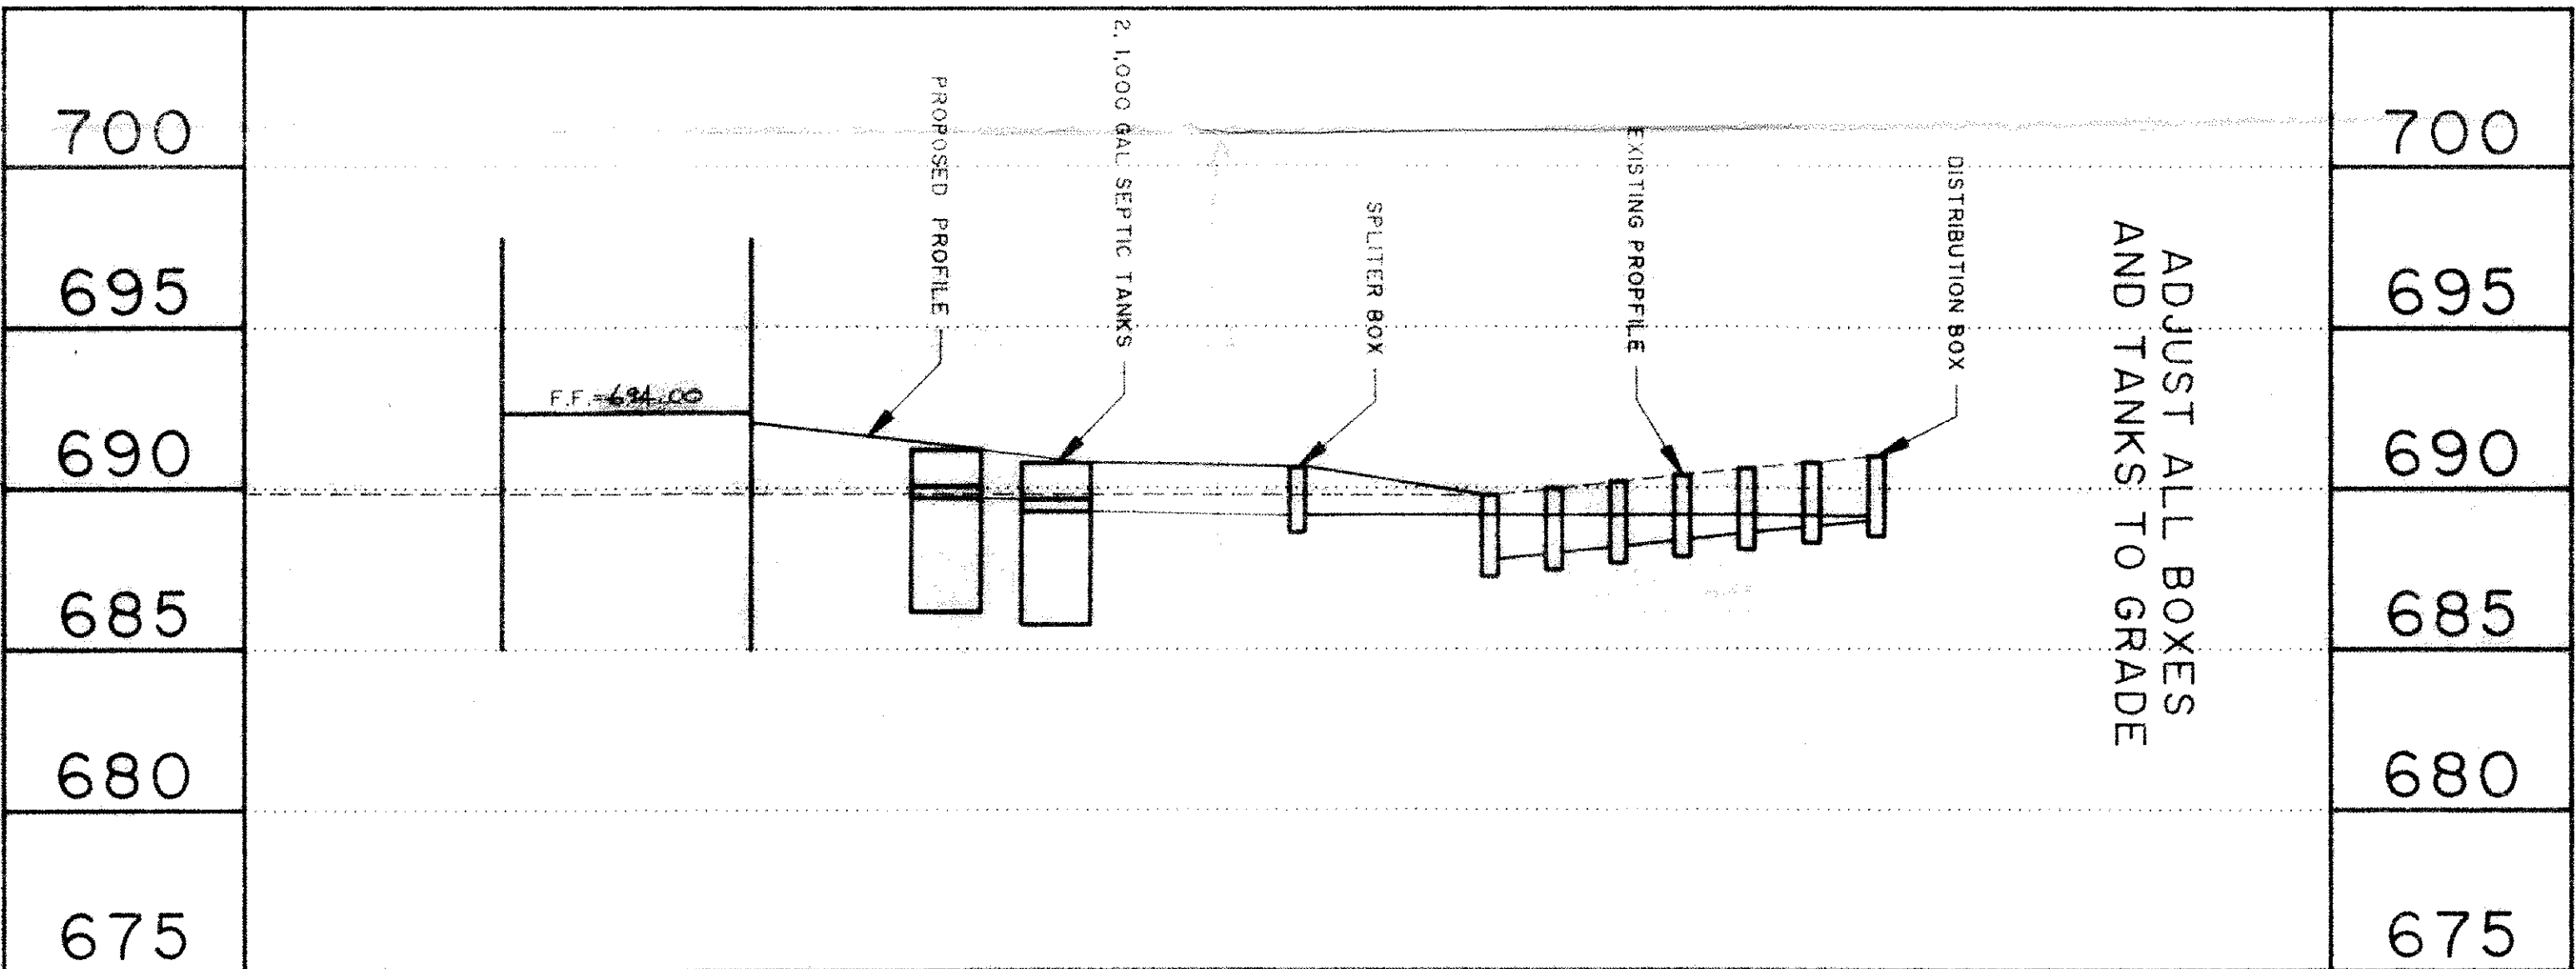


* THE STANDARD ET TRENCH IS 24 INCHES
HOWEVER THE TRENCH CAN VARY BETWEEN
18 INCHES TO 30 INCHES DEEP IF NECESSARY.
WHEN TRENCH DEPTH VARIES THE SAND AT
THE TOP OF THE TRENCH WILL VARY FROM 10
TO 18 INCHES DEEP.

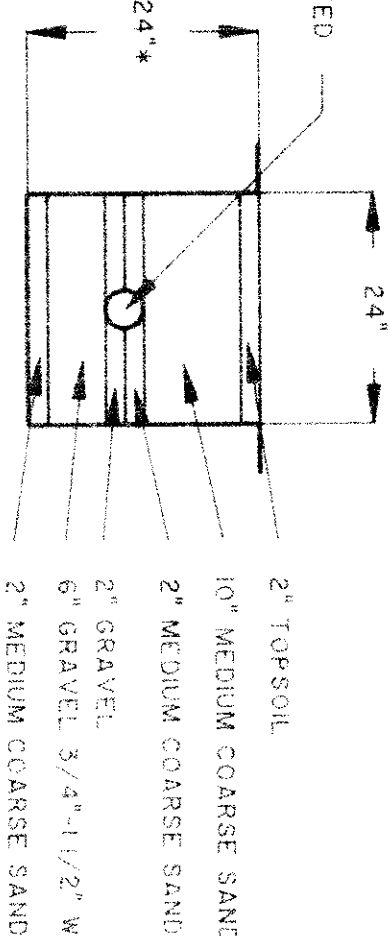

TYPICAL EVAPOTRANSPIRATION TRENCH CROSS SECTION

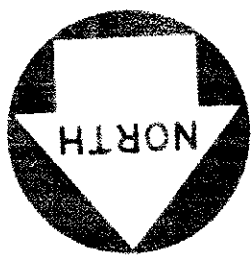

GRAPHIC SCALE

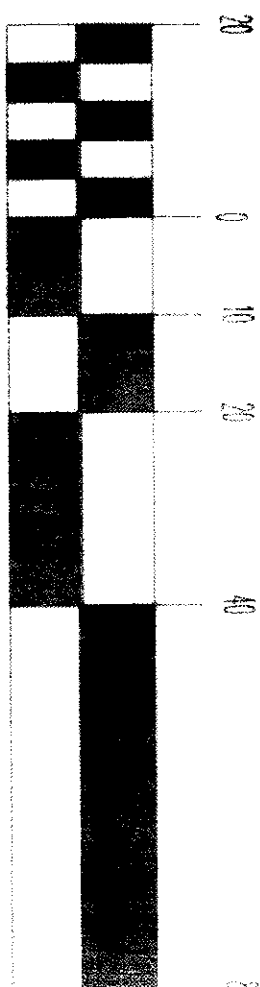

(IN FEET)
1 inch = 20 ft

GENERAL NOTES:

1. DRIVEWAY APRON TO BE 6" THICK
2. BENCHMARK - TOP STEM OF FIRE HYDRANT LOCATED
IN FRONT OF SUBLLOT NO. 1, ELEV. = 692.30

LEGEND

- EXISTING CONTOUR
- PROPOSED CONTOUR
- EXISTING ELEVATION
- PROPOSED ELEVATION

CERTIFICATION

"I, THE UNDERSIGNED HEREBY CERTIFY THAT THIS TOPOGRAPHY
INDICATED BY 'I' CONTOURS AND ELEVATIONS SHOWN HEREON
REPRESENTS AN ACTUAL SURVEY MADE BY ME ON THE 28TH
DAY OF OCT., 1995 AND THE ELEVATIONS WERE TAKEN AT
APPROPRIATE INTERVALS AND AS OF THAT DAY THEY EXISTED
AS INDICATED HEREON.

"I HEREBY CERTIFY THAT THIS PLAN WAS PREPARED BY ME
AND IS CORRECT TO THE BEST OF MY KNOWLEDGE"

DAVID W. NOVAK, P.S. No. 7597

APPROVED
PAINEVILLE SANITARY
ENGINEERING DEPARTMENT
10/10/1991

Grading Plan Approved
as shown and/or noted
THOMAS F. GILLES, P.E.
Lake County Engineer

REVISED AND ACCEPTED
LAKE COUNTY GENERAL
HEALTH DISTRICT
Date 9/21/97 by David L. L...
L... of Leach line not
ET L...
SEWAGE DIVISION PERMIT MUST BE
OBTAINED BY 4/1/98. COUNTY LICENSED
ENGINEER OR BEFORE INSTALLATION IS
STARTED

By L.H. D... 122-97


Himebaugh and Novak
Surveyors and Site Consultants
8663 Tyler Boulevard
Mentor, Ohio 44060-4346
(216) 974-7670, (216) 255-5900 FAX.

SCHONIGER BROS. CONST., INC.
501 GREENSIDE DRIVE, PAINEVILLE, OH 44077

SITE PLAN
SUBLLOT NO. 2

DATE: JULY 16, 1997
DRAWN BY: C.R. KRAFT
CHECKED BY: DWN
APPROVED BY:

SHEET NO. 95101-2
OF

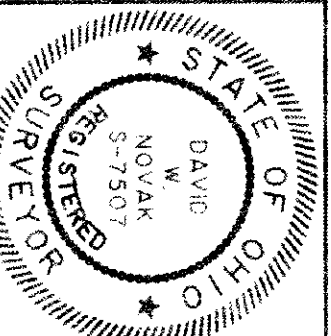

REV.	DESCRIPTION	DATE	BY	CHK'D
1	SEKONIGER BROS.			