


"I, the undersigned hereby certify that this topography indicated by 6", 1', or 2' contours, and elevations shown hereon represent an actual field survey made by me on the 19th day of Dec, 2003 and that the elevations were taken at appropriate intervals and that as of that date they existed as indicated hereon."

Harry S. Jones, Jr.
Name: Reg. No. #6343

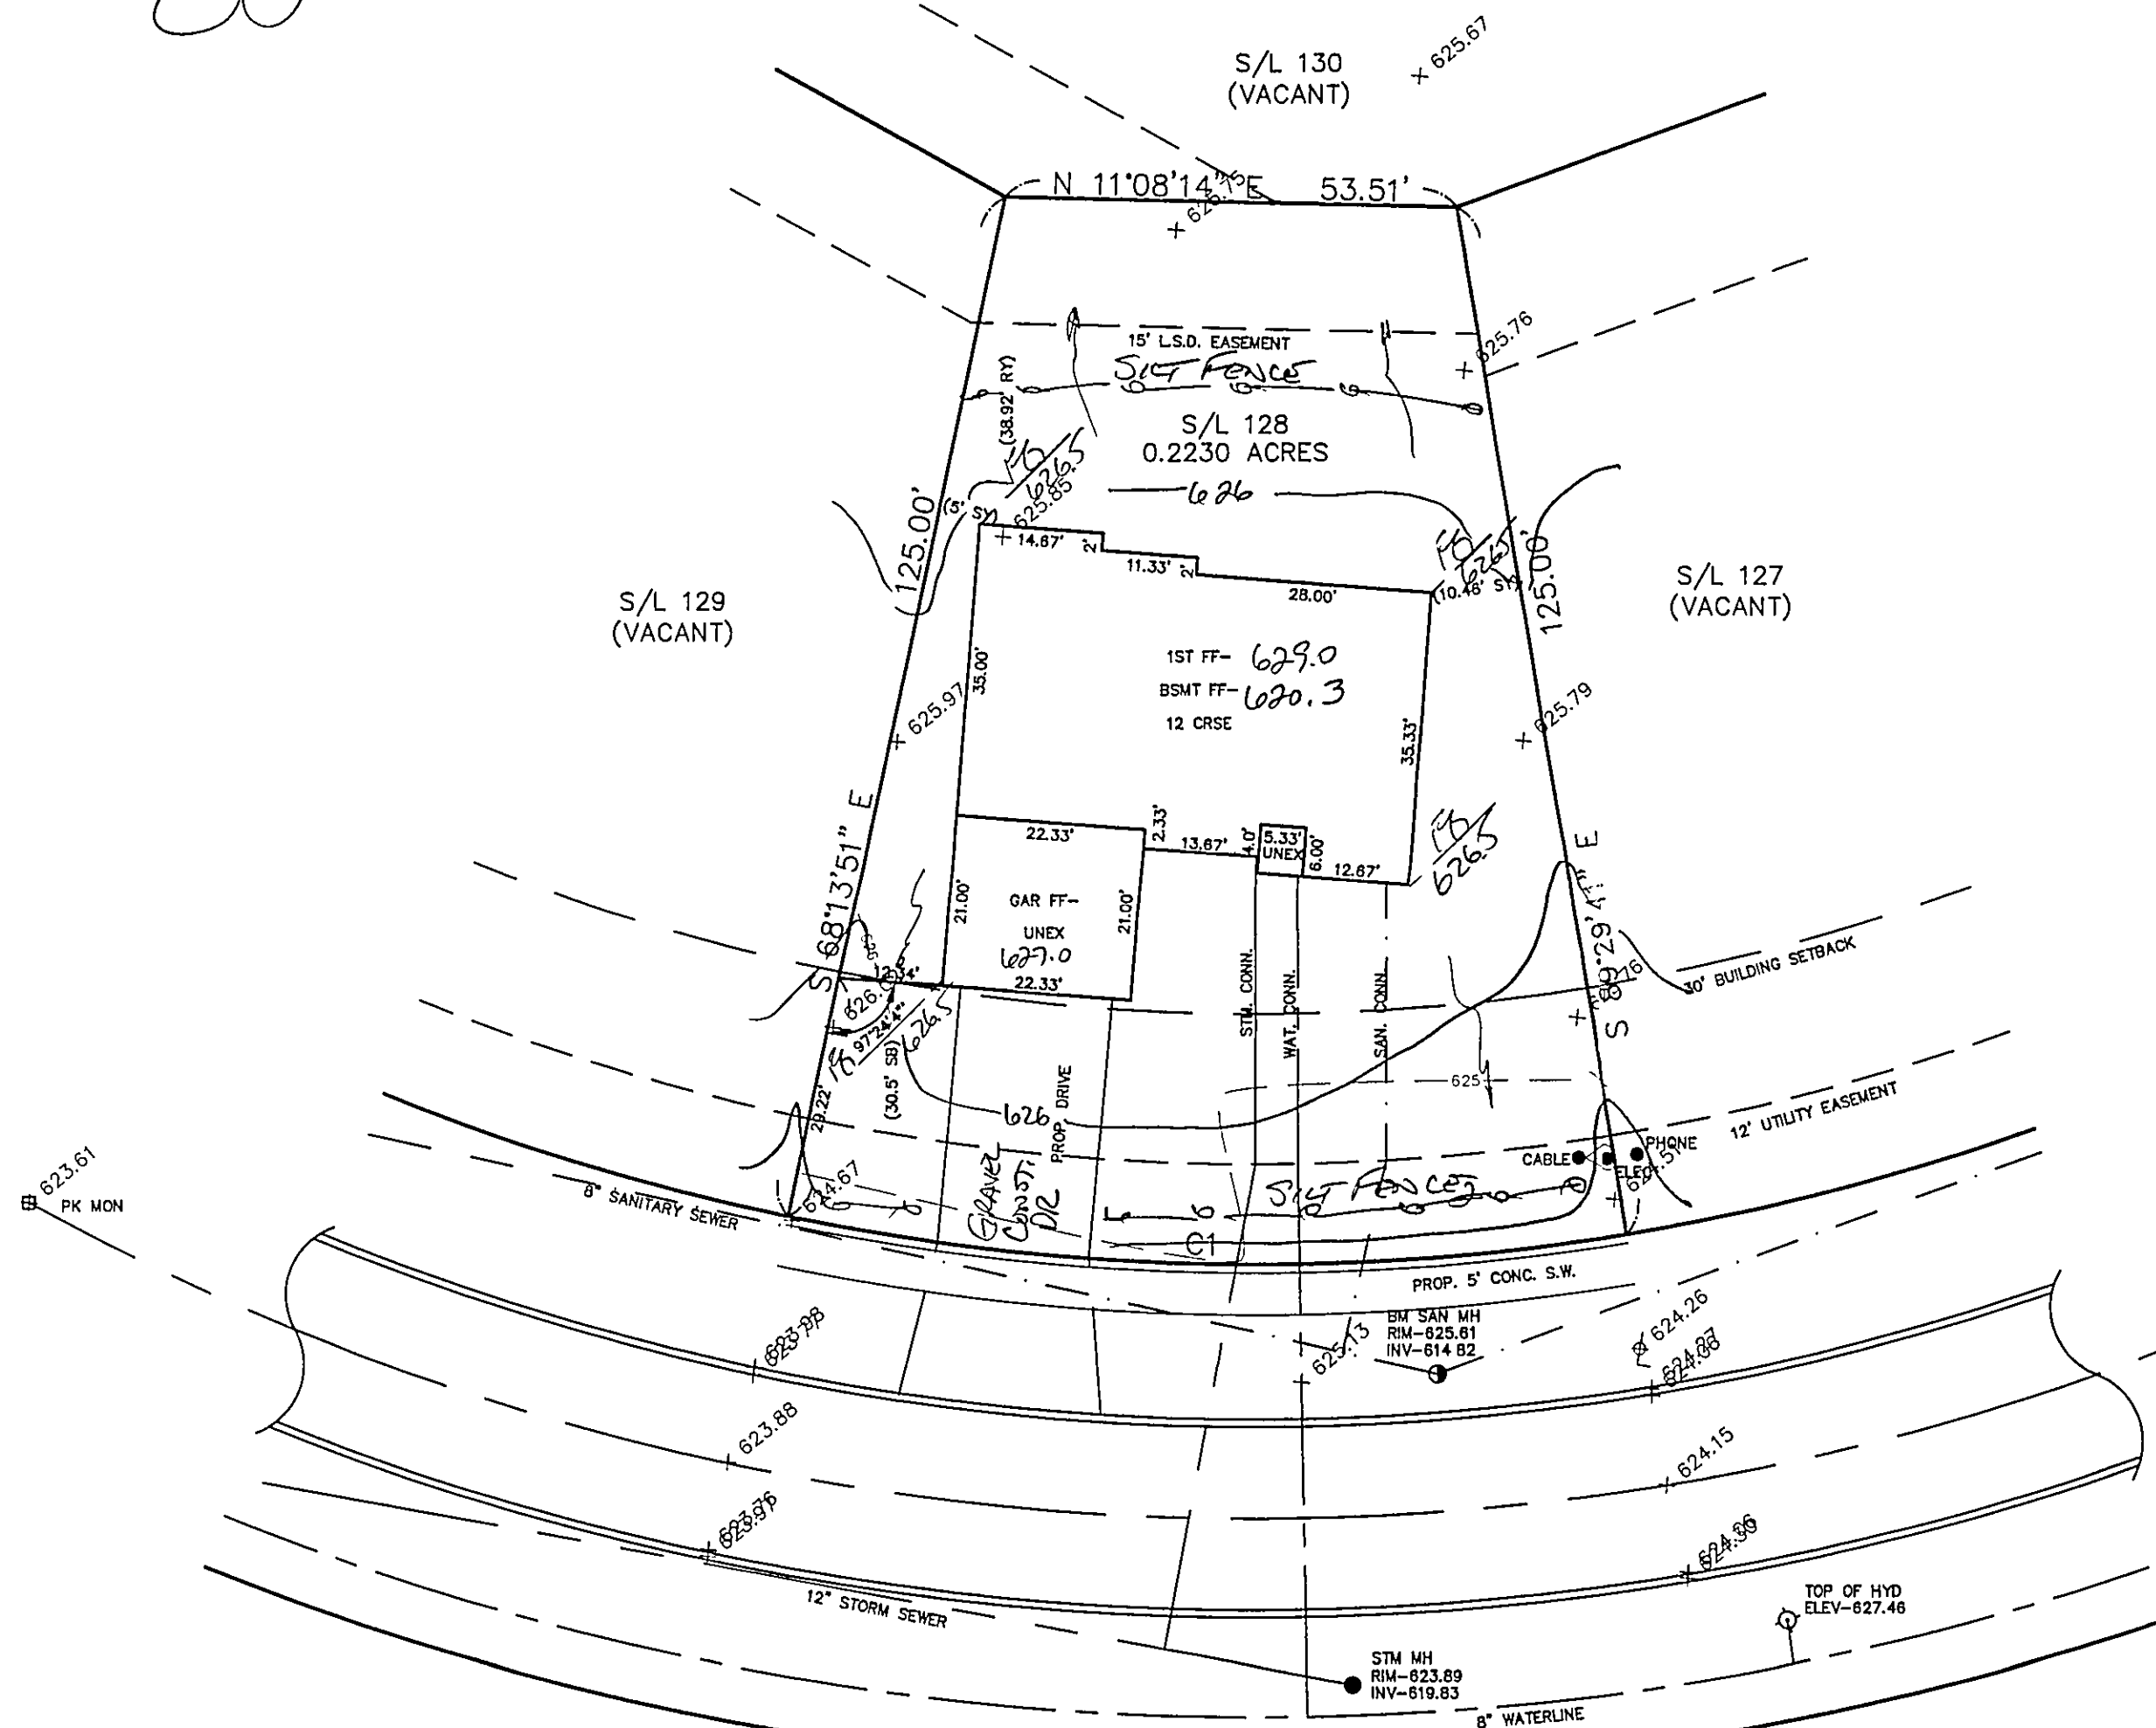

PEBBLE BEACH COVE - 60'

SITE PLAN

PAINESVILLE TWP., LAKE COUNTY, OHIO

for: WILSHIRE HOMES

CLIENT		OWNER	
ADDRESS	STREET	CITY	ZIP
LAKE ERIE SHORES #2			
SUBDIVISION	NAME	TRACT	STREET
128	45-30	LOT	
SUBLOT NO.	PEBBLE BEACH COVE	VOL.-PG.	PERM. PARCEL NO.

LEGEND

SANITARY MANHOLE	---●---	EXIST. ELEV. ---100.0	PROF. ELEV. ---100.0
STORM MANHOLE	---●---		
INLET OR CATCH BASIN	---●---		
HYDRANT	---●---		
EXISTING CONTOURS	---●---		
PROPOSED CONTOURS	---●---		
AS BUILT ELEVATION		INDICATES DIRECTION OF SURFACE DRAINAGE	

REMARKS

ALL BOUNDARY DATA SHOWN WAS OBTAINED FROM (DEEDS, RECORDED SUBDIVISION PLAT OR OTHER PUBLIC RECORDS)

LOCATIONS AS SHOWN OF ADJACENT WELLS AND SEPTIC TANKS OBTAINED FROM LAKE COUNTY HEALTH DEPARTMENT

DESIGN CERTIFICATION

THIS PLAT WAS PREPARED BY ME, AND IS CORRECT TO THE BEST OF MY KNOWLEDGE AND BELIEF.

NAME: Harry S. Jones, Jr. SURVEYOR REGISTRATION NO. #6343

CHECK LIST

NO. OF BEDROOMS	WATER MAIN SIZE, LOCATION
DIMENSIONS	SAN. SEWER SIZE & GR. LOC.
BEARINGS	SAN. MH. CAST. ELEV. INV. ELEV.
TIE TO NEAREST STREET	SAN. CONN. SIZE, LOC. DEPTH
SUBLOT NO., PARCEL NO.	STORM SEWER SIZE & GR. LOC.
SURROUNDING OWNERS	STORM MH. CAST. ELEV. INV. ELEV.
BLDG. DIMENSIONS FIN GR.	PAV'T TYPE GRADE CURBS
BLDG. TIES FL'R. GRADES	GAS LINE LOC. SIZE PRESSURE
APRON TYPE WIDTH THICKNESS	SEPTIC TANK LOCATION & DUPLICATION AREA
SIDEWALK TYPE WIDTH THICKNESS	WELL LOCATION
CULVERT TYPE DIA., LENGTH	ISOLATION RADIUS FROM WELL
ROCK OUTCROPPINGS	

REVISIONS			PLAN PREPARED BY:		
NO.	DATE	BY	Bj BABCOCK · JONES & ASSOCIATES, INC		
1			PAINESVILLE, OHIO		
2			DRAWN BY	N.S.	SCALE 1"=20'
3			CHK'D.	H.J.	DATE 12/23/03
4			CREW CHIEF	R.B.	APP'D H.J.
5			PHONE NO. 440-357-181		
			DRAWING NO. 03-234-12		

"AS BUILT" CERTIFICATION
I, HEREBY CERTIFY THAT THE CIRCLED GRADES ARE EXISTING
FINISH GRADES CHECKED IN THE FIELD ON 12/23/03, 2003
AND ARE CORRECT TO THE BEST OF MY KNOWLEDGE AND BELIEF

REGISTERED SURVEYOR

REG. NO.

BM SANITARY MANHOLE
ELEV-624.51

CURVE	LENGTH	RADIUS	CHORD	BEARING	DELTA
C1	100.20	270.00	99.63	N11°08'14"E	21°15'50"

EXISTING UTILITIES NOTE:
THE SIZE AND LOCATION, BOTH HORIZONTAL AND VERTICAL
OF THE UNDERGROUND UTILITIES SHOWN HEREON, HAVE BEEN
OBTAINED BY A SEARCH OF AVAILABLE RECORDS.
VERIFICATION BY FIELD OBSERVATION HAS BEEN CONDUCTED
WHERE PRACTICAL, HOWEVER, BABCOCK, JONES AND ASSOCIATES
INC. DOES NOT GUARANTEE THE COMPLETENESS NOR ACCURACY
THEREOF.

