


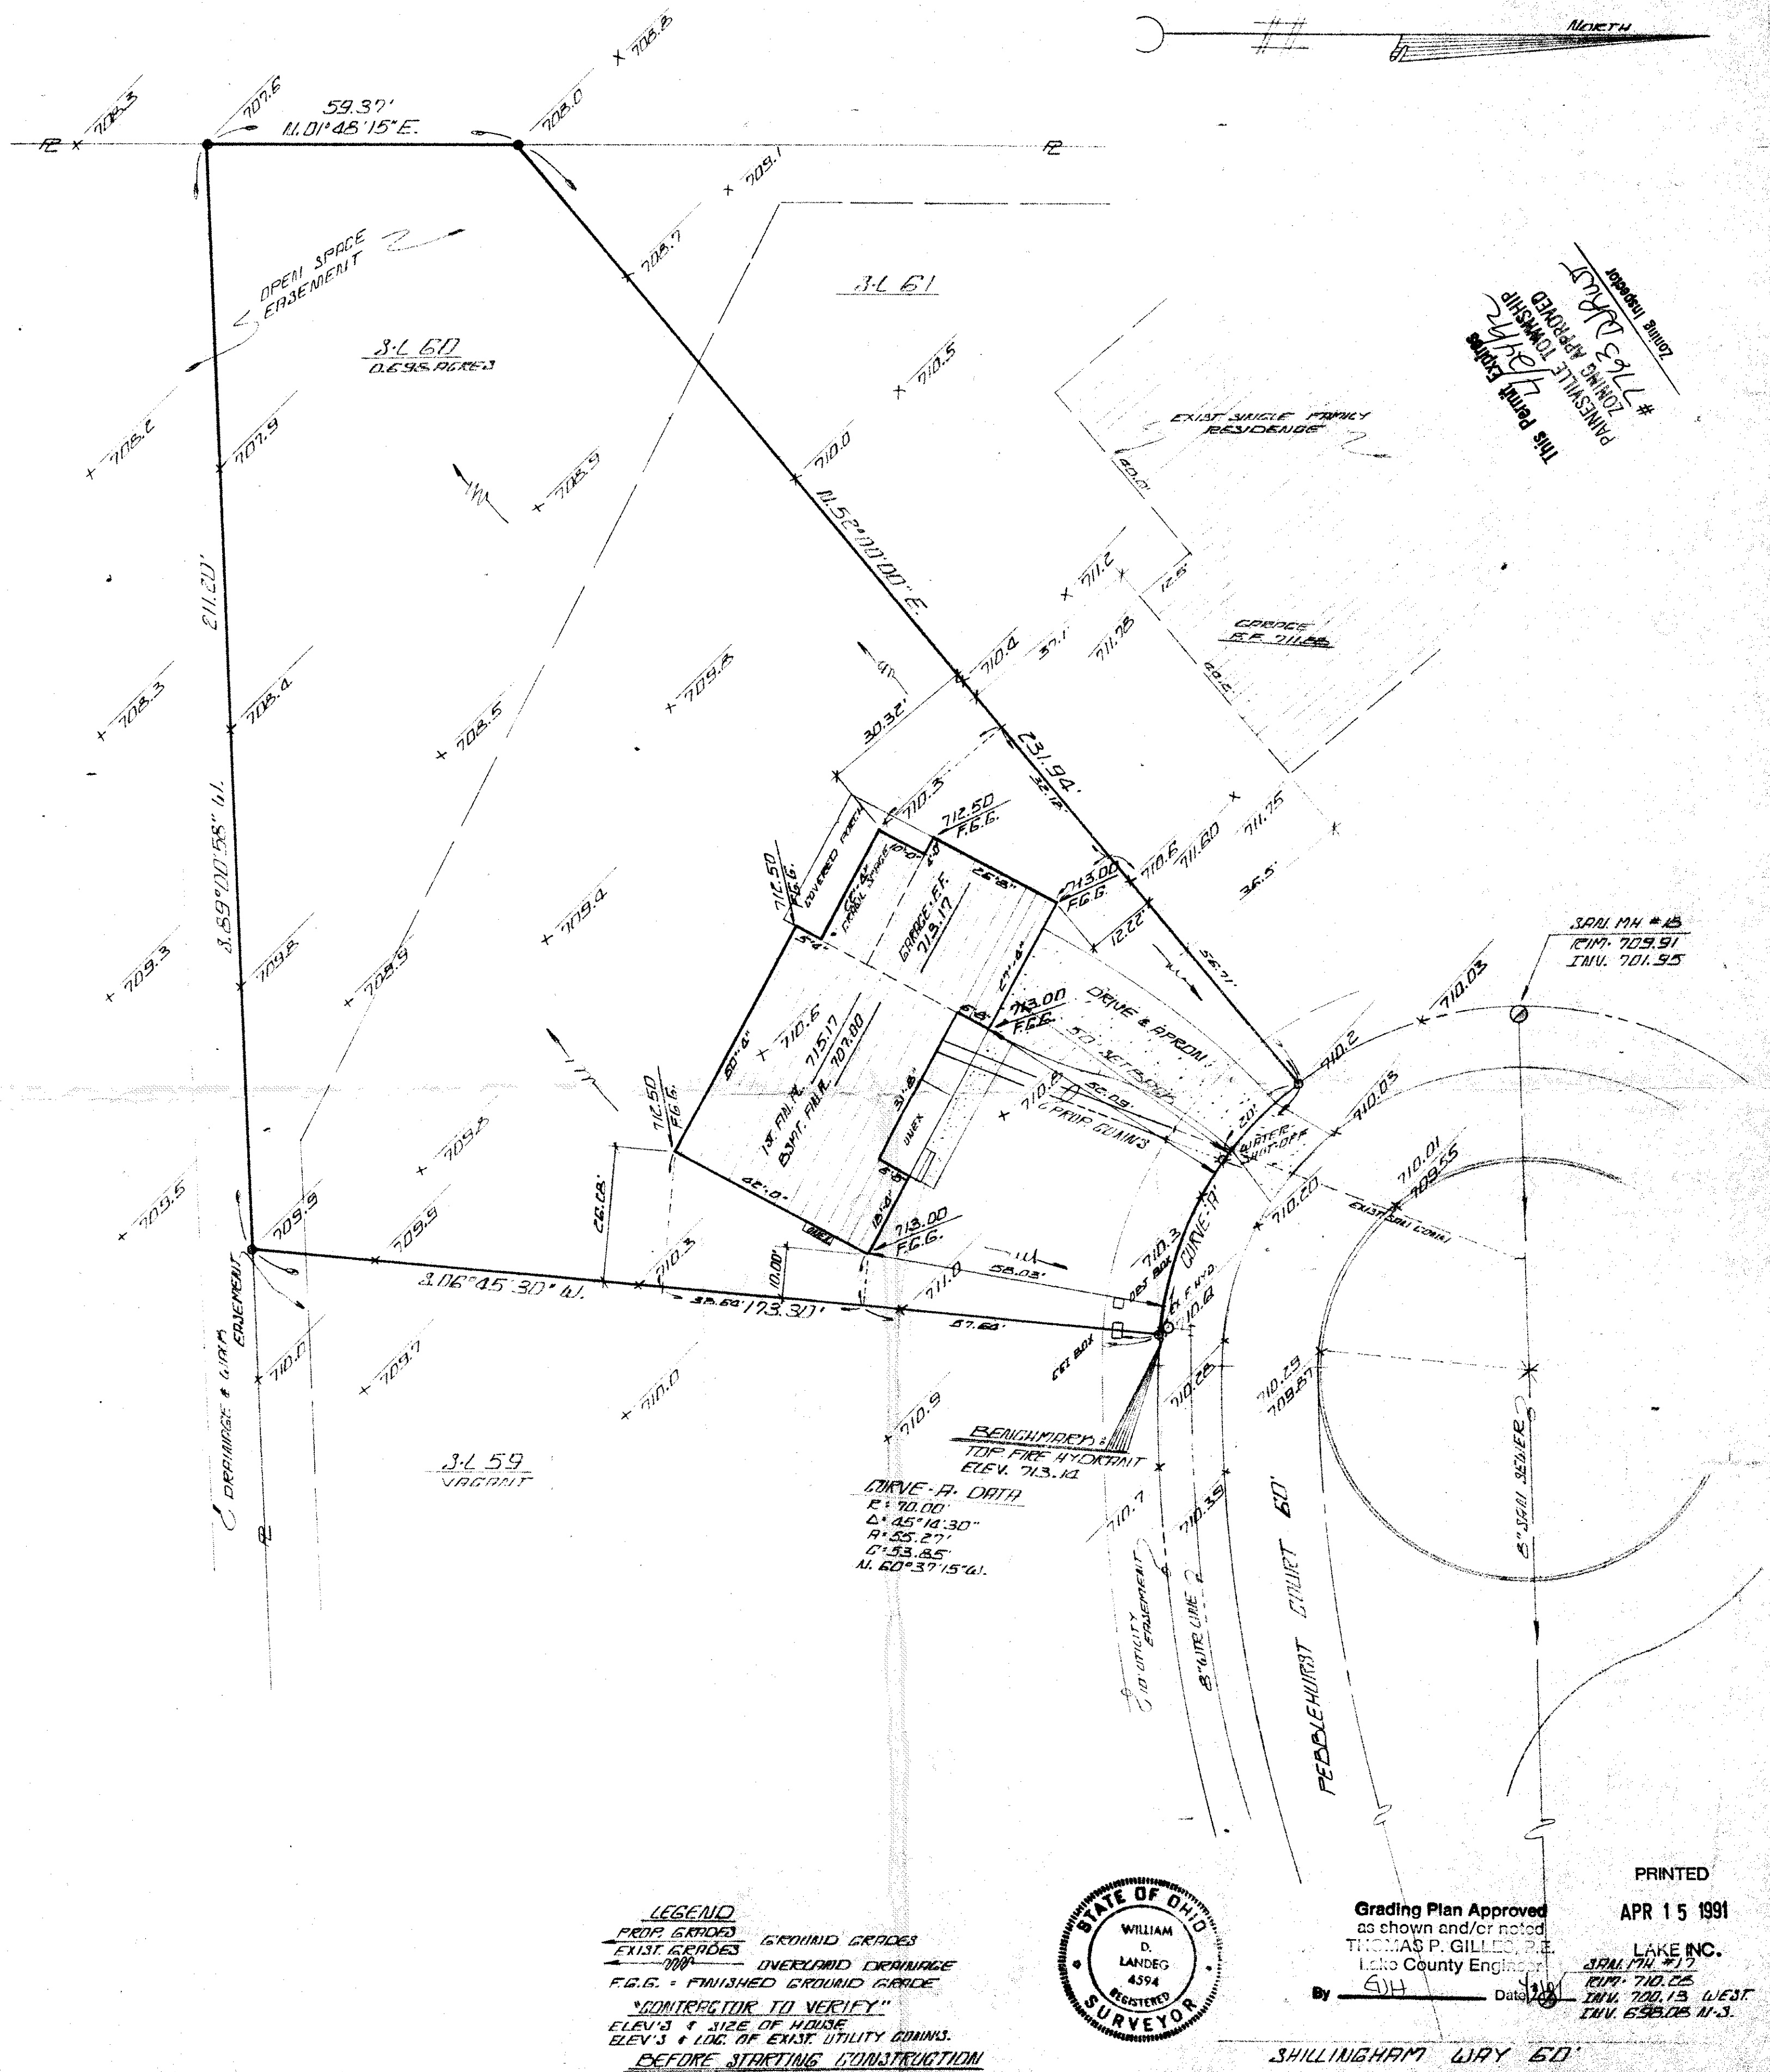

PRINTED
APR 15 1991

Grading Plan Approved
as shown and/or noted
THOMAS P. GILLES, P.E.
Lake County Engineer

LAKE INC.
JRM/MH #17
RIM 710.28
- INV. 700.13 WEST
INV. 698.08 N-S.

SHILLINGHAM WAY 60'

SITE PLAN for
SIGNATURE HOMES, Inc.
NINESBOROUGH SUBD. - PRAIRIEVILLE TOWNSHIP

SCALE: 1"=20'	APPROVED BY	DRAWN BY
DATE: MARCH 18-91		D. Abbott

BEING SUBLOT N460 IN THE KINGSBOROUGH
SUBDIVISION N42 AS REFLECTED IN VOLUME 3
PAGE 16 LAKE COUNTY PLAT RECORDS

LAME INC.
30601 FRIED AVENUE
WILLOW, OHIO.

DRAWING NUMBER
91-31