


PERRY PARK RD. - 60'



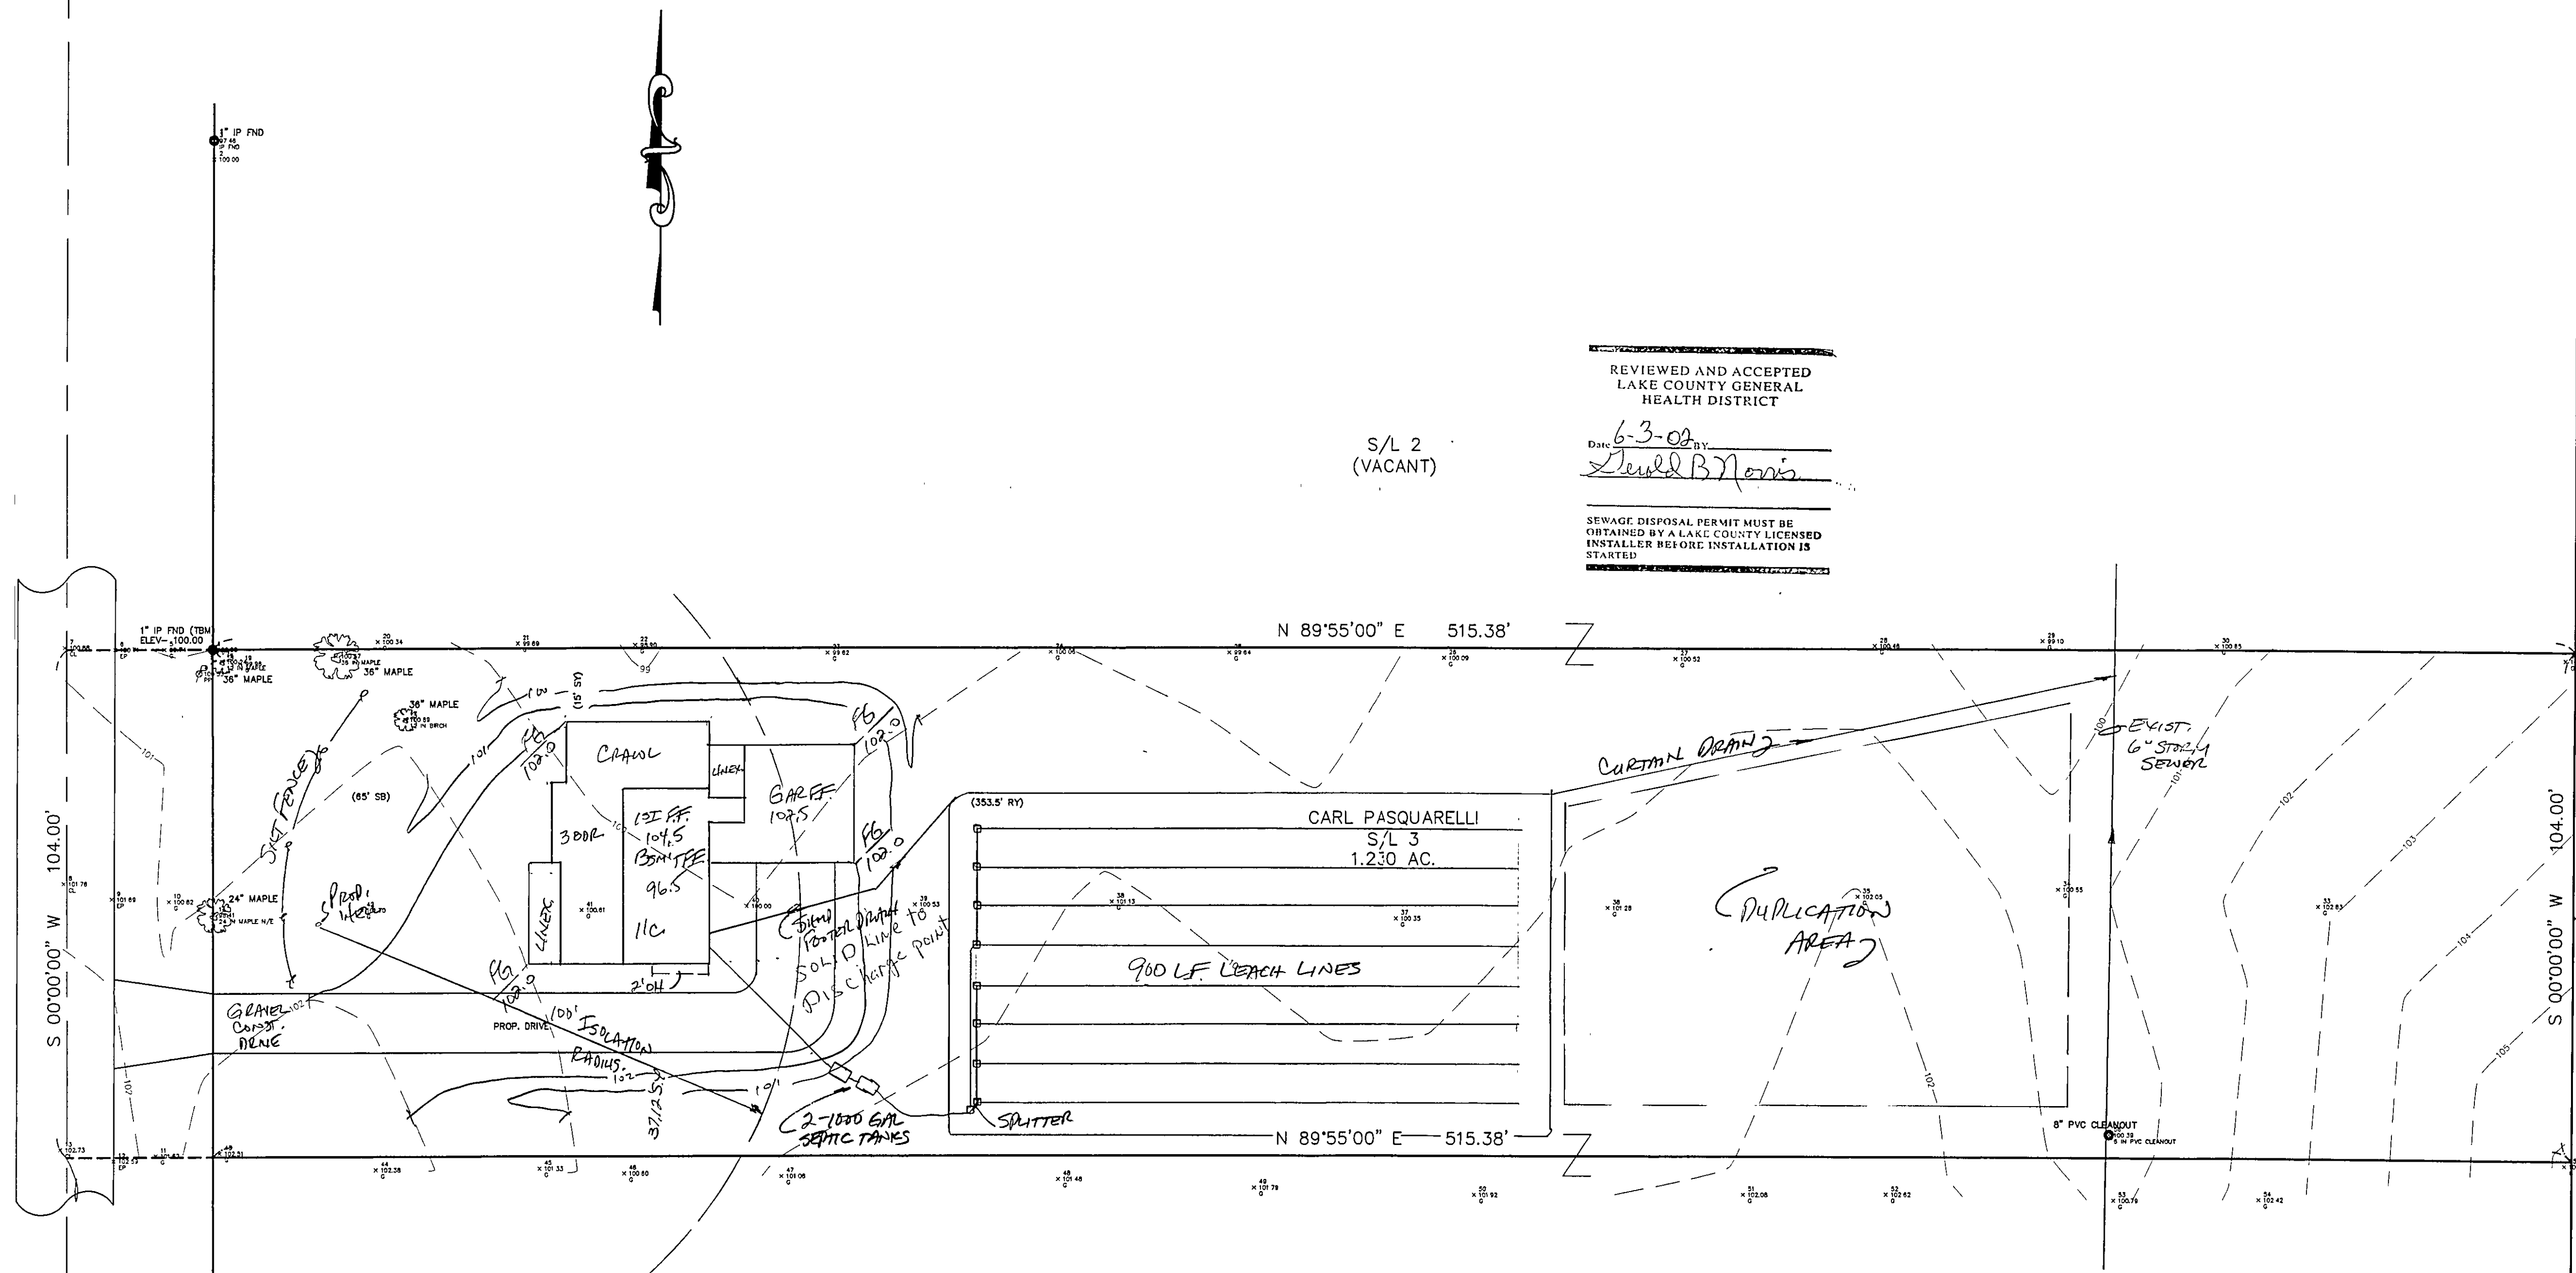


REVIEWED AND ACCEPTED
LAKE COUNTY GENERAL
HEALTH DISTRICT
Date: 6-3-02 BY: David B. Norris
SEWAGE DISPOSAL PERMIT MUST BE
OBTAINED BY A LAKE COUNTY LICENSED
INSTALLER BEFORE INSTALLATION IS
STARTED

ROBERT R. CLARK
VOL 388- PG 923
3A-30A-8


APPROVED
LINE LINES & SET BACK
PERRY TOWNSHIP ZONING
PERMIT NO. 2223
ZONING INSPECTOR

Grading Plan Approved
as shown and/or noted
JAMES R. GILLS, P.E.
L.C. County Engineer
By: [Signature] Date: 6/12/02

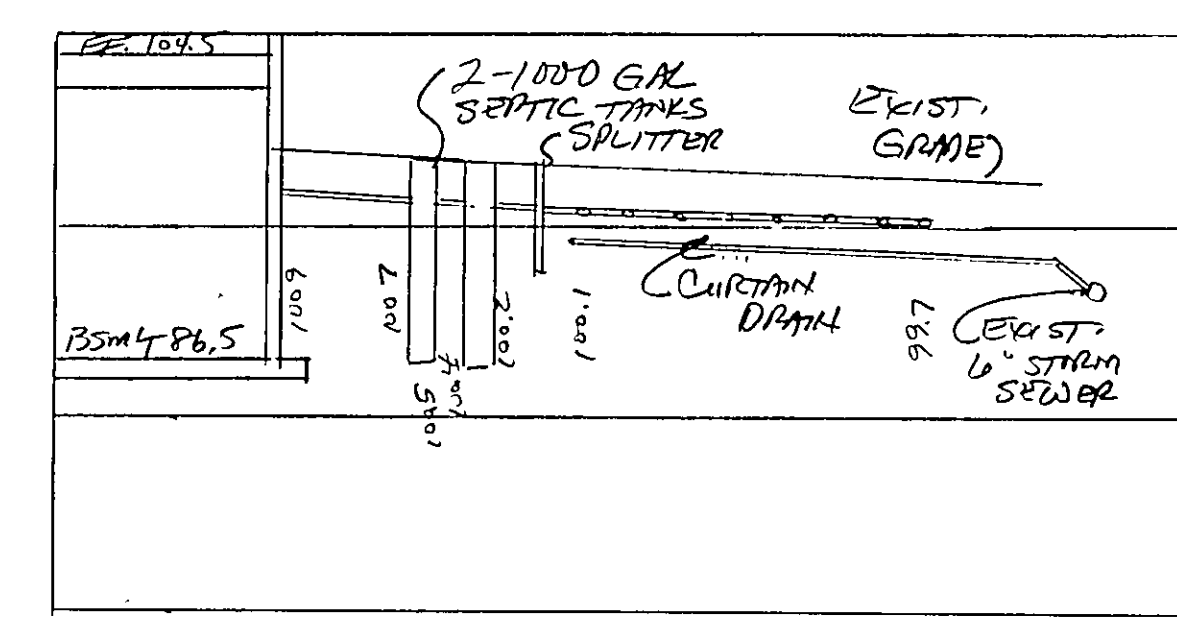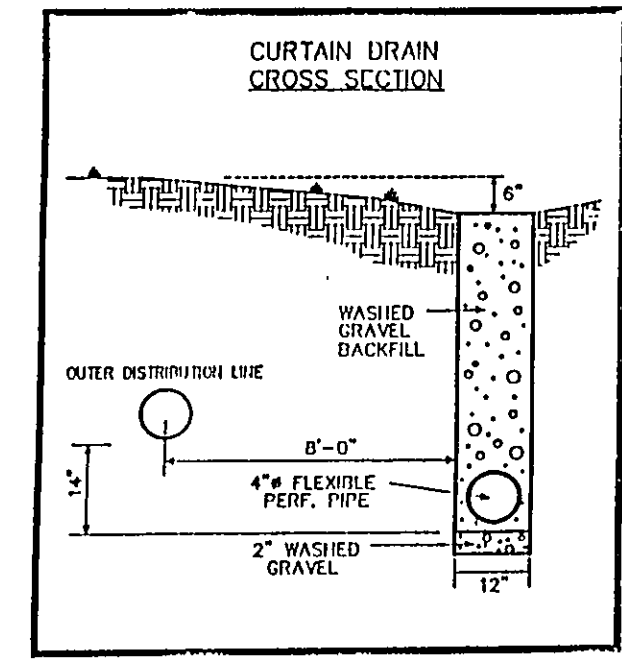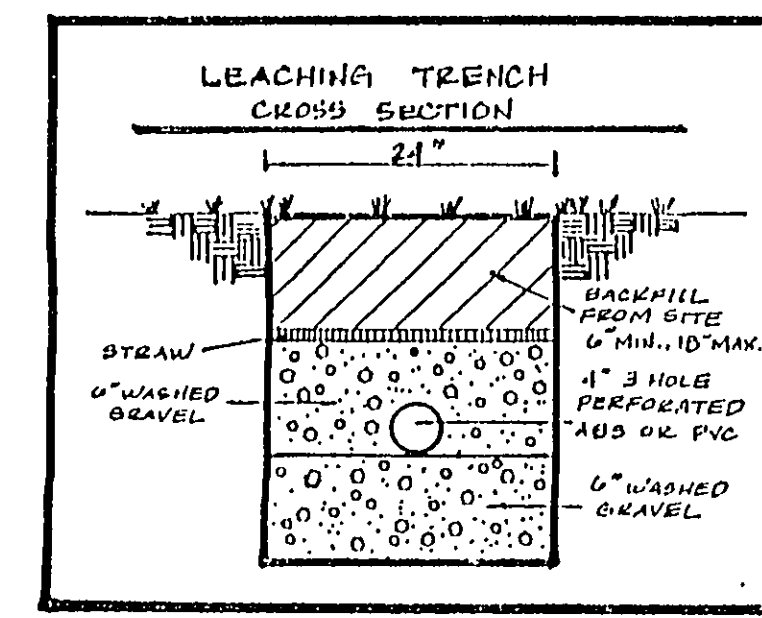

"I, the undersigned, do hereby certify that
this topography and survey by 6\", 1' or 2'
contours, and elevations shown hereon
represent an actual field survey made by
me on the 23 day of May, 2002,
and that the elevations were taken at
appropriate intervals and that as of that
date they existed as indicated hereon."
Name: [Signature] Reg. No. 6343

EXISTING UTILITIES NOTE:
THE SIZE AND LOCATION, BOTH HORIZONTAL AND VERTICAL
OF THE UNDERGROUND UTILITIES SHOWN HEREON, HAVE BEEN
OBTAINED BY A SEARCH OF AVAILABLE RECORDS.
WHERE PRACTICAL, HOWEVER, BABCOCK, JONES AND ASSOCIATES
INC. DOES NOT GUARANTEE THE COMPLETENESS NOR ACCURACY
THEREOF.

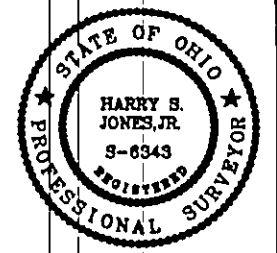

REV. NO.	DESCRIPTION	DATE	BY	CHK'D

bj BABCOCK, JONES AND ASSOCIATES, INC
CIVIL ENGINEERS - SURVEYORS - LAND PLANNERS
PAINESVILLE OHIO 44077

DATE 5/24/02
DESIGN BY H.J.
DRAWN BY M.M.
APPROVED BY H.J.

SITE PLAN
FOR
CARL PASQUARELLI
PERRY TOWNSHIP
LAKE COUNTY, OHIO

SCALE: 1"=20'
JOB NO. 02-115
SHEET 1 OF 1