


"I, the undersigned hereby certify that this topography indicated by 6", 1", or 2" contours, and elevations shown hereon represent an actual field survey made by me on the 21st day of April, 2003 and that the elevations were taken at appropriate intervals and that as of that date they existed as indicated hereon."

Name Harry Jones #16343 Reg. No.

NOTE: ALL IRON PINS SET ARE 5/8" X 30" AND ARE CAPPED BABCOCK JONES & ASSOC

| CURVE TABLE | | | | | |
|-------------|--------|--------|---------|-------|-------------|
| CURVE | LENGTH | RADIUS | TANGENT | CHORD | BEARING |
| C1 | 40.98 | 60.00 | 21.33 | 40.19 | N63°33'36"E |

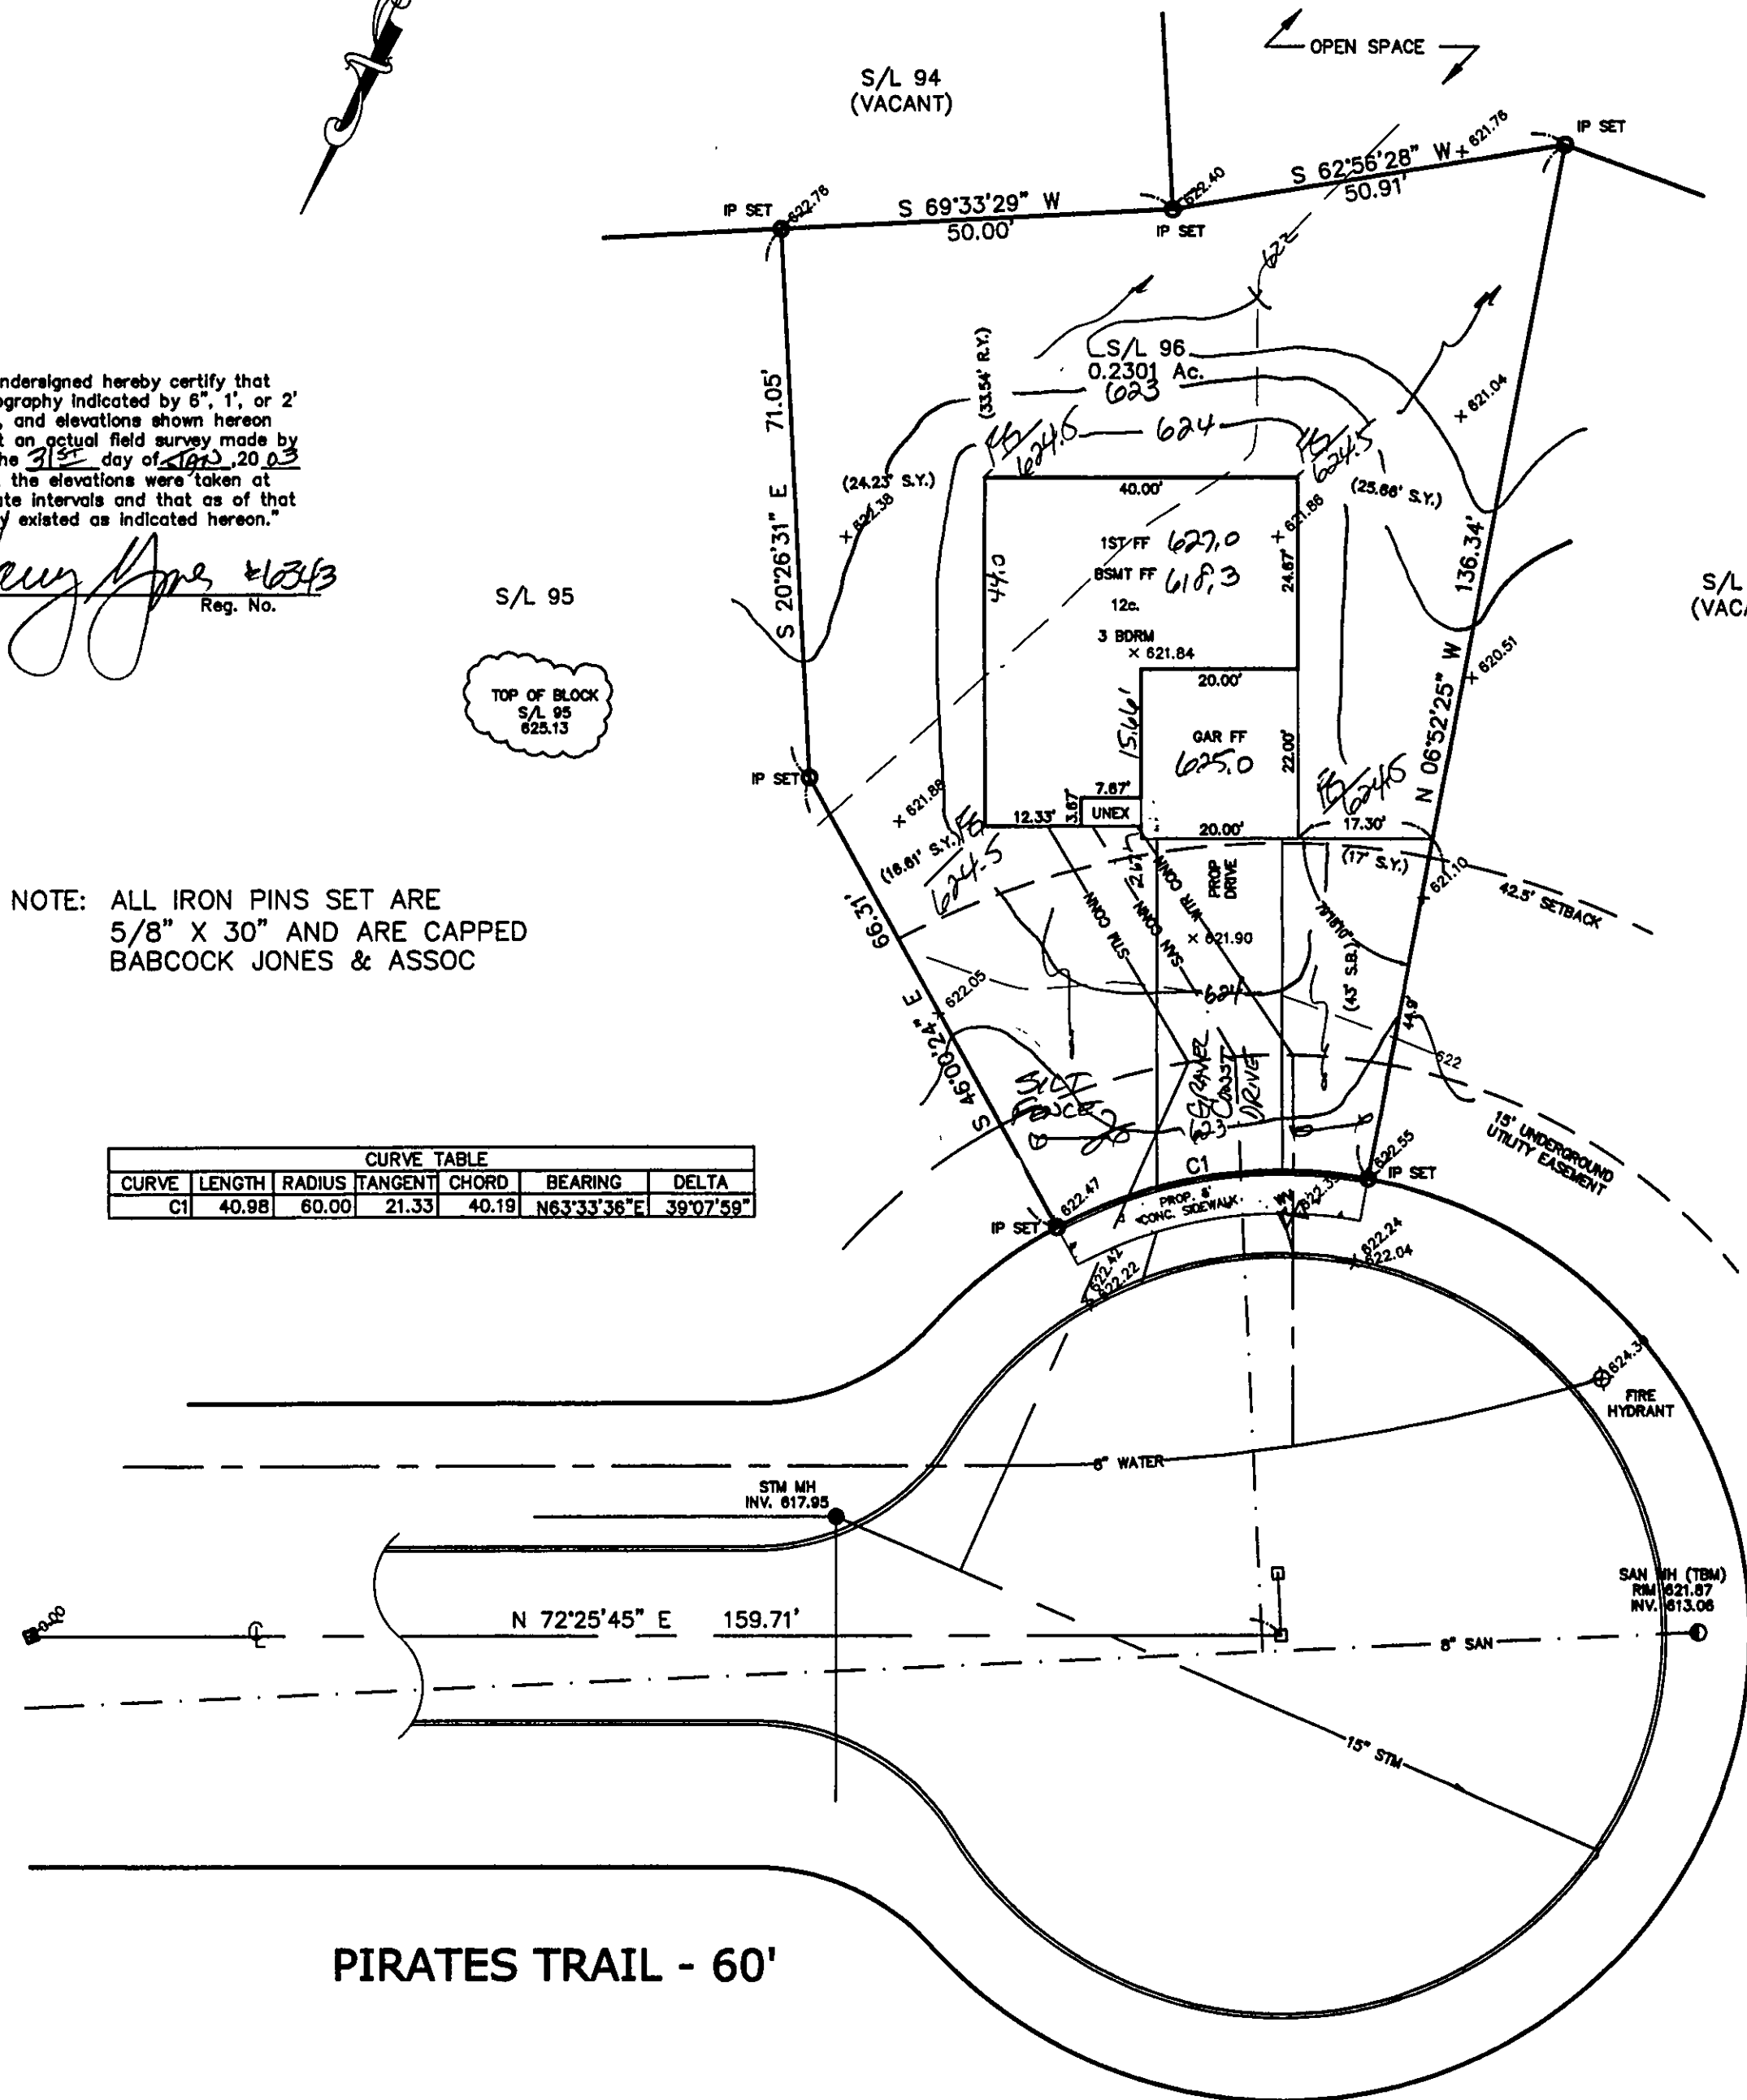

SITE PLAN

PAINESVILLE TWP., LAKE COUNTY, OHIO

for: KNEZ CONSTRUCTION

| | | | |
|------------------|-------------|---------|------------------|
| CLIENT | | OWNER | |
| ADDRESS | STREET | CITY | ZIP |
| LAKE ERIE SHORES | | | |
| SUBDIVISION | NAME | TRACT | STREET |
| 42-25 | PAINESVILLE | | |
| 96 | VOL-PG. | LOT | |
| SUBLOT NO. | STREET | VOL-PG. | PERM. PARCEL NO. |

LEGEND

| | | | |
|----------------------|---------|---|-------------------|
| SANITARY MANHOLE | ---○--- | EXIST. ELEV. 100.0 | PROP. ELEV. 100.0 |
| STORM MANHOLE | ---●--- | AS BUILT ELEVATION | |
| INLET OR CATCH BASIN | ---□--- | INDICATES DIRECTION OF SURFACE DRAINAGE | |
| HYDRANT | ---○--- | | |
| EXISTING CONTOURS | ---○--- | | |
| PROPOSED CONTOURS | ---○--- | | |

REMARKS

ALL BOUNDARY DATA SHOWN WAS OBTAINED FROM (DEEDS, RECORDED SUBDIVISION PLAT OR OTHER PUBLIC RECORDS)

LOCATIONS AS SHOWN OF ADJACENT WELLS AND SEPTIC TANKS OBTAINED FROM LAKE COUNTY HEALTH DEPARTMENT

DESIGN CERTIFICATION

THIS PLAT WAS PREPARED BY ME, AND IS CORRECT TO THE BEST OF MY KNOWLEDGE AND BELIEF.

Name Harry Jones #16343 Surveyor Registration No.

CHECK LIST

| | |
|----------------------------|---|
| NO. OF BEDROOMS | WATER MAIN SIZE, LOCATION |
| DIMENSIONS | SAN. SEWER SIZE & GR. LOC. |
| BEARINGS | SAN. MH. CAST. ELEV. INV. ELEV. |
| TIE TO NEAREST STREET | SAN. CONN. SIZE, LOC. DEPTH |
| SUBLOT NO. PARCEL NO. | STORM SEWER SIZE & GR. LOC. |
| SURROUNDING OWNERS | STORM MH. CAST. ELEV. INV. ELEV. |
| BLDG. DIMENSIONS FIN GR. | PAV'T TYPE GRADE CURBS |
| BLDG. TIES FL'T. GRADES | GAS LINE LOC. SIZE PRESSURE |
| APRON TYPE WIDTH THICKNESS | SEPTIC TANK LOCATION & DUPLICATION AREA |
| SEWER TYPE WIDTH THICKNESS | WELL LOCATION |
| CULVERT TYPE DIA., LENGTH | ISOLATION RADIUS FROM WELL |
| ROCK OUTCROPPINGS | |

| REVISIONS | | | PLAN PREPARED BY: | |
|-----------|------|----|----------------------------------|------------------------|
| NO. | DATE | BY | BABCOCK JONES & ASSOCIATES, INC. | |
| 1 | | | PAINESVILLE, OHIO | |
| 2 | | | DRAWN BY B.P. | SCALE 1"=20' |
| 3 | | | CHK'D. H.J. | DATE 2/3/03 |
| 4 | | | APP'D. W.B. | PHONE NO. 440-357-1811 |
| 5 | | | | DRAWING NO. 02-008-96 |

"AS BUILT" CERTIFICATION

I, HEREBY CERTIFY THAT THE CIRCLED GRADES ARE EXISTING FINISH GRADES CHECKED IN THE FIELD ON 2/3/03, 2003 AND ARE CORRECT TO THE BEST OF MY KNOWLEDGE AND BELIEF.

REGISTERED SURVEYOR REG. NO.

BM - SANITARY MANHOLE #31
ELEV - 621.87

RECEIVED
PAINESVILLE TOWNSHIP
Engineering Department
2003 02 24
D. Jones

Grading Plan Approved
as shown and/or noted
JAMES R. GILLS, P.E.
Lake County Engineer

By D. Jones Date 2/2/03

EXISTING UTILITIES NOTE:
THE SIZE AND LOCATION, BOTH HORIZONTAL AND VERTICAL OF THE UNDERGROUND UTILITIES SHOWN HEREON, HAVE BEEN OBTAINED BY A SEARCH OF AVAILABLE RECORDS. VERIFICATION BY FIELD OBSERVATION HAS BEEN CONDUCTED WHERE PRACTICAL. HOWEVER, BABCOCK, JONES AND ASSOCIATES INC. DOES NOT GUARANTEE THE COMPLETENESS NOR ACCURACY THEREOF.

