

Loreto Lafelice Landscaping Inc.
Vol 702. Pg 352

**Grading Plan Approved
as shown and/or noted
THOMAS P. GILLES, P.E.
Lake County Engineer**

By TAM Date 5/18/2000
Lower F.G. as shown
Swale as shown

ROOF DRAINS
SHALL DISCHARGE
TO SPLASH BLOCKS.
REF. perry village zoning 086

S/L 16

S/L 18

Exist. Adj. Hse
Ftn. Ftr. 808.08
Gar. Ftr. 697.10

1. THE UNDERSIGNED, HEREBY CERTIFY THAT THIS TOPOGRAPHY, INDICATED BY 6", 1" OR 2" CONTOURS, AND ELEVATIONS SHOWN HEREON, REPRESENT AN ACTUAL FIELD SURVEY MADE BY ME ON THE 18th DAY OF MAY, 1898, AND THAT THE ELEVATIONS WERE TAKEN AT APPROPRIATE INTERVALS, AND THAT AS OF THAT DATE THEY EXISTED AS INDICATED HEREON.

Richard A. Thompson


S/L 17 Crv.Data

- A** $R=30.00$
 $A=38.83$
 $C=34.64$
 $N.32^{\circ}25'19''W.$
- B** $R=60.00$
 $A=78.81$
 $C=73.26$
 $N.30^{\circ}03'33''W.$

Red Mill Cove 60'

Moist. Sum. =
3/15 L.P.P.

Portsmouth Cove 60'

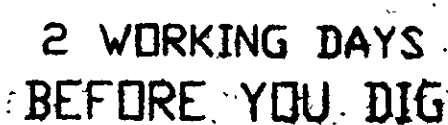

CALL TOLL FREE 800-362-2764

OHIO UTILITIES PROTECTION SERVICE




EXISTING UNDERGROUND UTILITIES NOTE:
THE SIZE & LOCATION BOTH HORIZONTAL AND VERTICAL
OF THE UNDERGROUND UTILITIES SHOWN HEREON, HAVE BEEN
OBTAINED BY A SEARCH OF AVAILABLE RECORDS.
VERIFICATION BY FIELD OBSERVATION HAS BEEN CONDUCTED
WHERE PRACTICAL, HOWEVER, LDC INC. DOES NOT
GUARANTEE THE COMPLETENESS NOR ACCURACY THEREOF.



for : Steve & Kelly Golar
CLIENT

24271	Alberton	Euclid
ADDRESS	STREET	CITY

17	Portsmouth Colony 2	22	30
SUBLOT No.	SUBDIVISION NAME	VOL.	PAGE
65	Perry Village		OHIO
LOT	TRACT	TOWNSHIP	

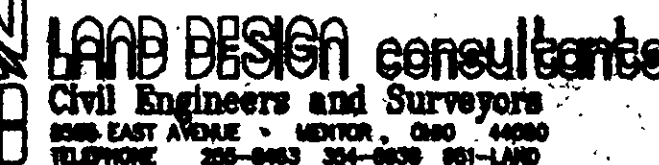

DESIGN CERTIFICATION

THIS PLAN WAS PREPARED BY ME, AND IS CORRECT TO THE BEST OF MY KNOWLEDGE AND BELIEF.

Robert A. Chagnon 5/8/00

CHECK LIST

[illegible]

"AS BUILT" CERTIFICATION

I HEREBY CERTIFY THAT THE CIRCLED INFORMATION IS
EXISTING AS OBTAINED ON THE SITE
2000 AND IS CORRECT TO THE BEST OF MY KNOWLEDGE
AND BELIEF.

NAMU

LEGEND

**STORM MANHOLE
SANITARY MANHOLE
ENGINE CONTAINS
PROPOSED CONTENT**

EXIST ELEV. 100.0
F.G. 100.0 = PROP. ELEV.

**DIRECTION OF
SURFACE DRAINAGE**

ACCEPTED

DRAWN BY **SCALE**

M.G.P.

CHK'D BY

R.A.T.

1	
---	--

1

1

BENCHMARK: B.M. - T.M. Set On Top Of Hydrant Located In Front Of S/L 17. Elev. 498.70