


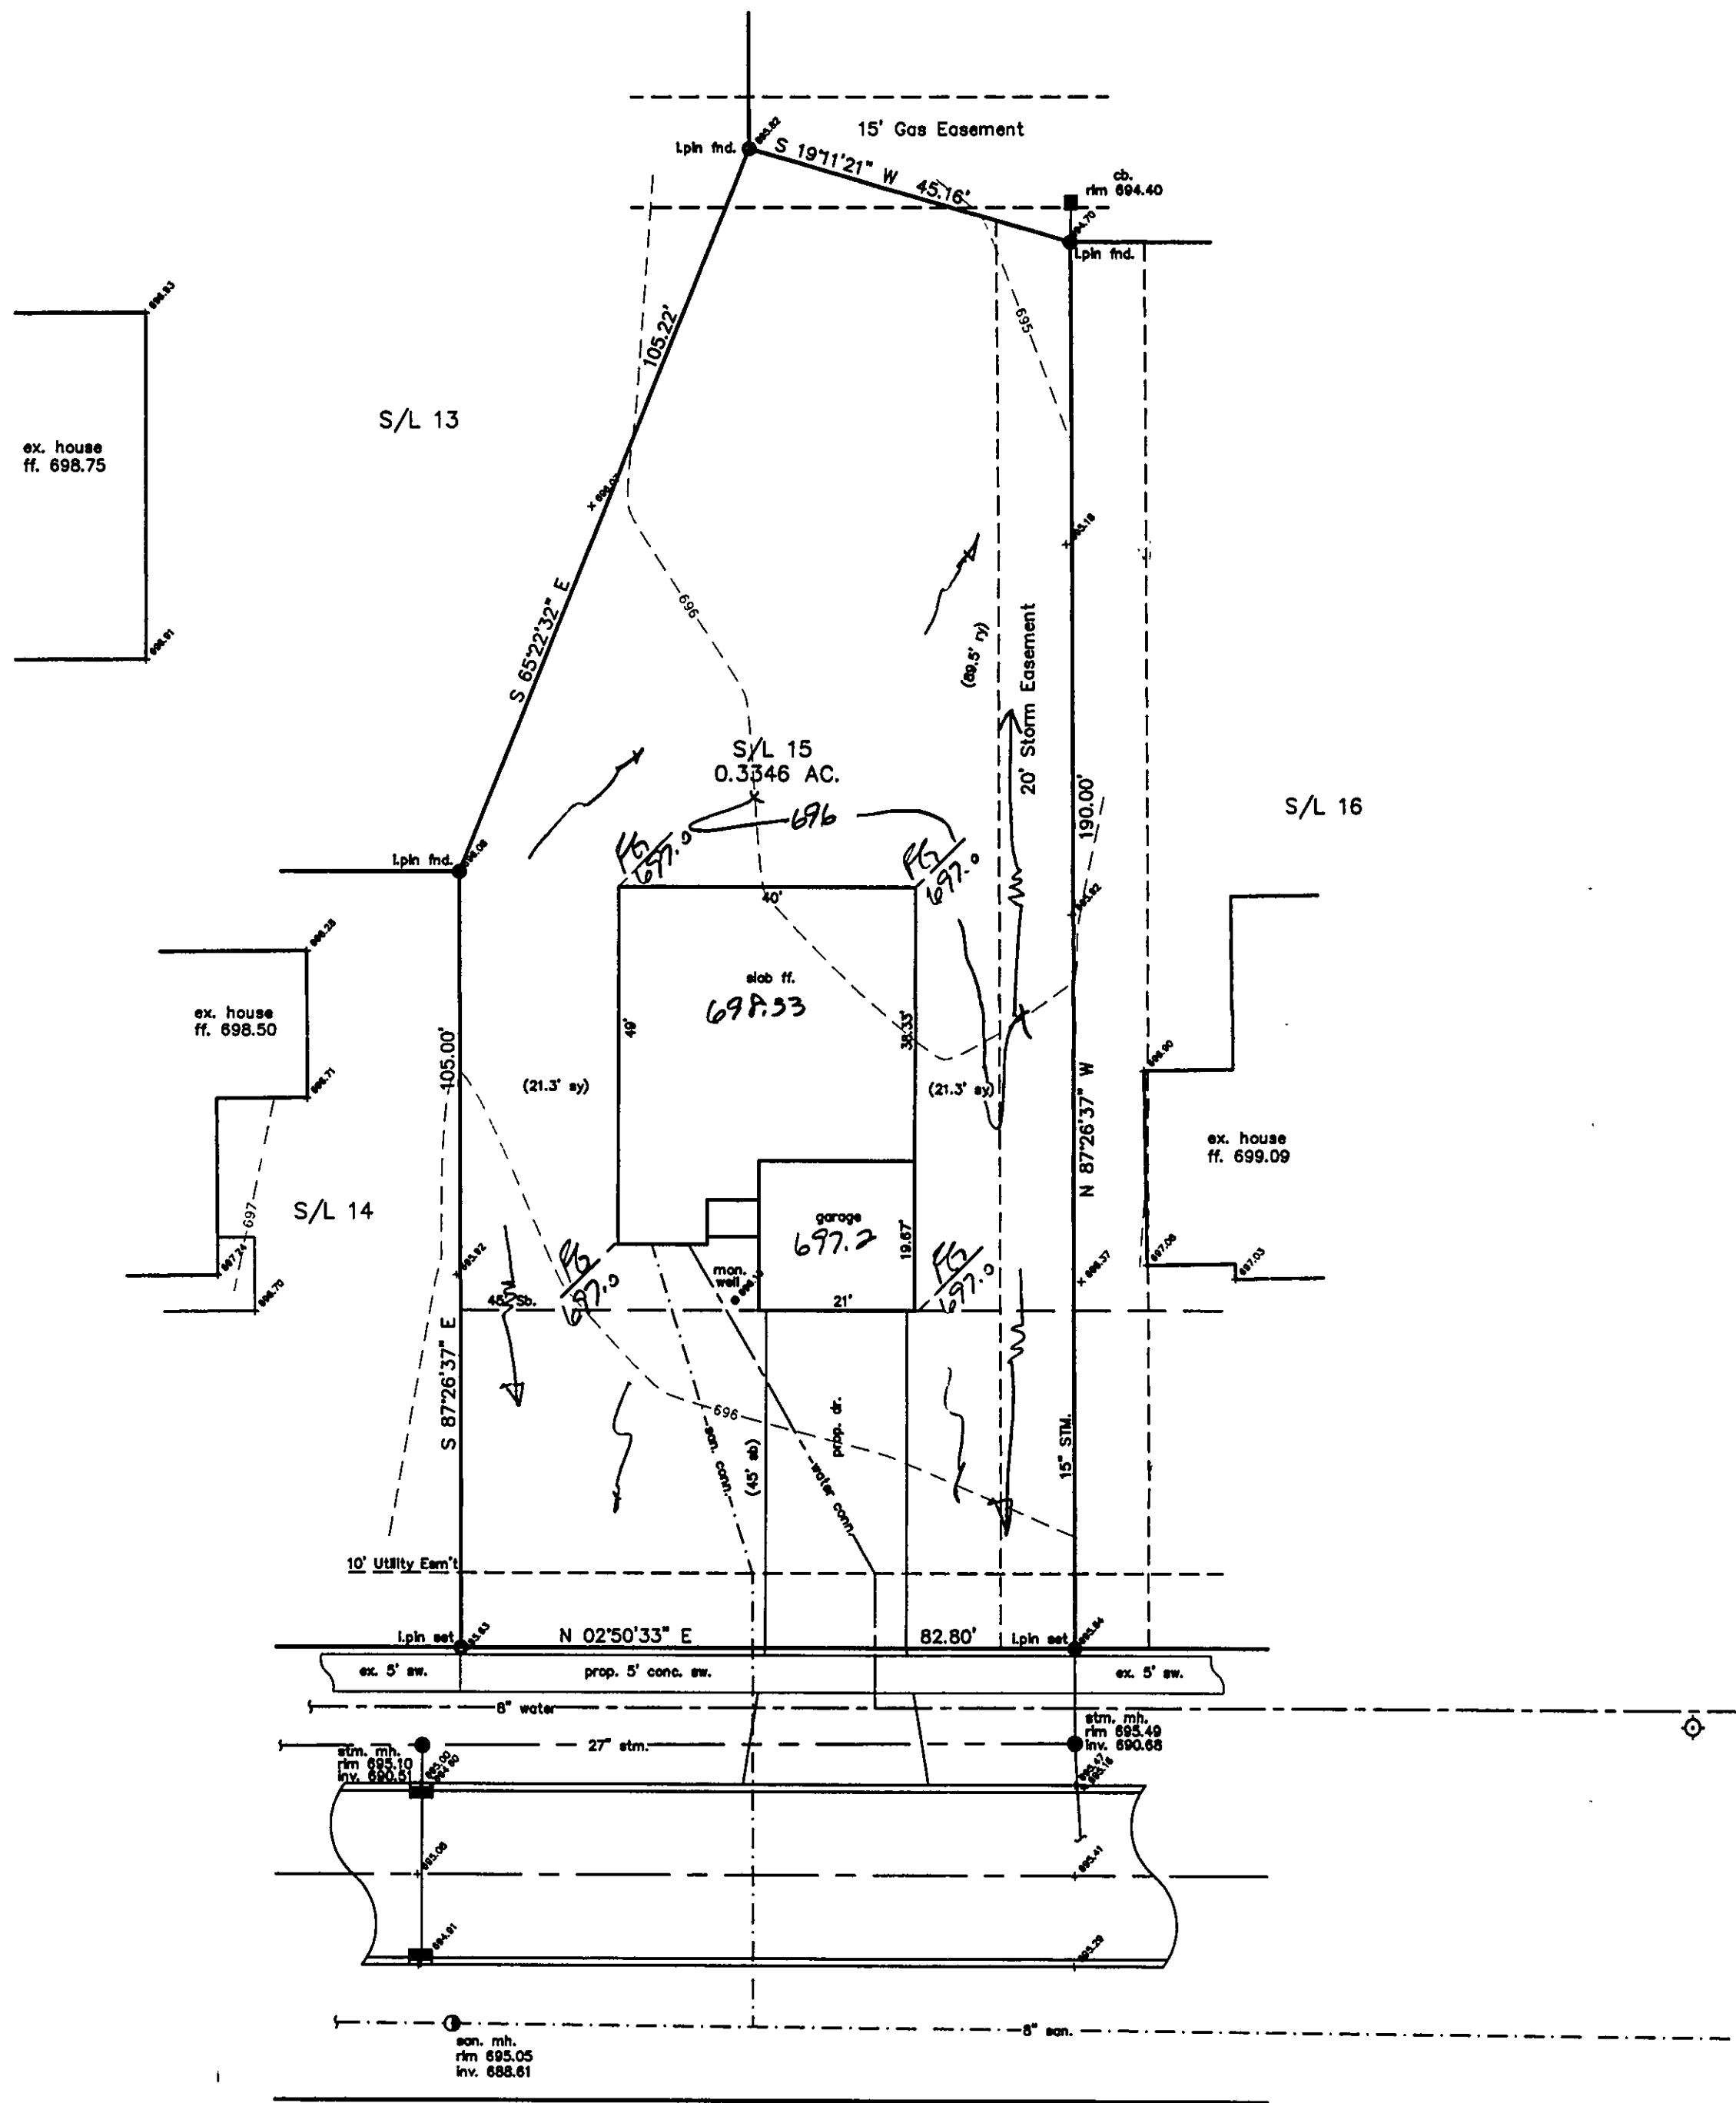

VILLAGE OF PERRY, LAKE COUNTY, OHIO

for: BANKER

CLIENT OWNER
ADDRESS STREET CITY ZIP

PORTSMOUTH COLONY No. 2
SUBDIVISION 22-30 NAME TRACT STREET
VOL-Pg. PORTSMOUTH COVE LOT
15 SUBLOT NO. STREET VOL-Pg. PERM. PARCEL NO.

LEGEND

SANITARY MANHOLE --- ○ --- EXIST. ELEV. --- 100.0
STORM MANHOLE --- ● --- 100.0 --- PROP. ELEV.
INLET OR CATCH BASIN --- ■ --- AS BUILT ELEVATION
HYDRANT --- ◇ --- INDICATES
EXISTING CONTOURS --- --- DIRECTION OF
PROPOSED CONTOURS --- --- SURFACE DRAINAGE

REMARKS

ALL BOUNDARY DATA SHOWN WAS OBTAINED FROM (DEEDS, RECORDED
SUBDIVISION PLAT OR OTHER PUBLIC RECORDS)
LOCATIONS AS SHOWN OF ADJACENT WELLS AND SEPTIC TANKS OBTAINED FROM
LAKE COUNTY HEALTH DEPARTMENT

DESIGN CERTIFICATION

THIS PLAT WAS PREPARED BY ME, AND IS CORRECT
TO THE BEST OF MY KNOWLEDGE AND BELIEF.

NAME SURVEYOR REGISTRATION NO.

CHECK LIST

NO. OF BEDROOMS
DIMENSIONS
BEARINGS
TIE TO NEAREST STREET
SUBLOT NO. PARCEL NO.
SURROUNDING OWNERS
BLDG. DIMENSIONS FIN GR.
BLDG. TIES FL'R. GRADES
APRON TYPE WIDTH THICKNESS
SIDEWALK TYPE WIDTH THICKNESS
CULVERT TYPE DIA. LENGTH
ROCK OUTCROPPINGS

WATER MAIN SIZE, LOCATION
SAN. SEWER SIZE & OR. LOC.
SAN. MH. CAST. ELEV. INV. ELEV.
SAN. CONN. SIZE, LOC. DEPTH
STORM SEWER SIZE & OR. LOC.
STORM MH. CAST ELEV. INV. ELEV.
P/W/T TYPE GRADE CURBS
GAS LINE LOC. SIZE PRESSURE
SEPTIC TANK LOCATION & DUPLICATION AREA
WELL LOCATION
ISOLATION RADIUS FROM WELL

REVISIONS

NO.	DATE	BY	PLAN PREPARED BY:
1			BABCOCK JONES & ASSOCIATES, INC.
2			PAINESVILLE, OHIO
3			DRAWN BY T.R. SCALE 1"=20' PHONE NO. 440-357-1811
4			CHK'D. H.J. DATE 12/21/99 DRAWING NO.
5			CREW K.J. APP'D H.J. 95-103-15

"AS BUILT" CERTIFICATION
I, HEREBY CERTIFY THAT THE CIRCLED GRADES ARE EXISTING
FINISH GRADES CHECKED IN THE FIELD ON 19
AND ARE CORRECT TO THE BEST OF MY KNOWLEDGE AND BELIEF.

REGISTERED SURVEYOR

REG. NO.

TBM-SANITARY MH.
RIM=696.54

Grading Plan Approved
as shown and/or noted
THOMAS P. GILLES, P.E.
Lake County Engineer

By TAM Date 1-7-2000
SWALE AS SHOWN
REFERENCE PERRY VILLAGE Zoning point # 0851

