
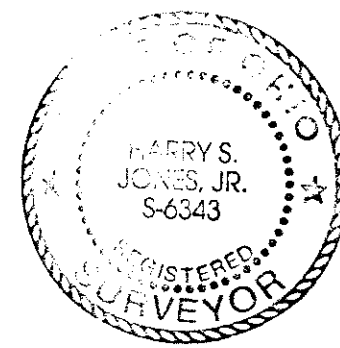


APPROVED
PAINESVILLE TOWNSHIP
PLANNING DEPARTMENT
2/27/77

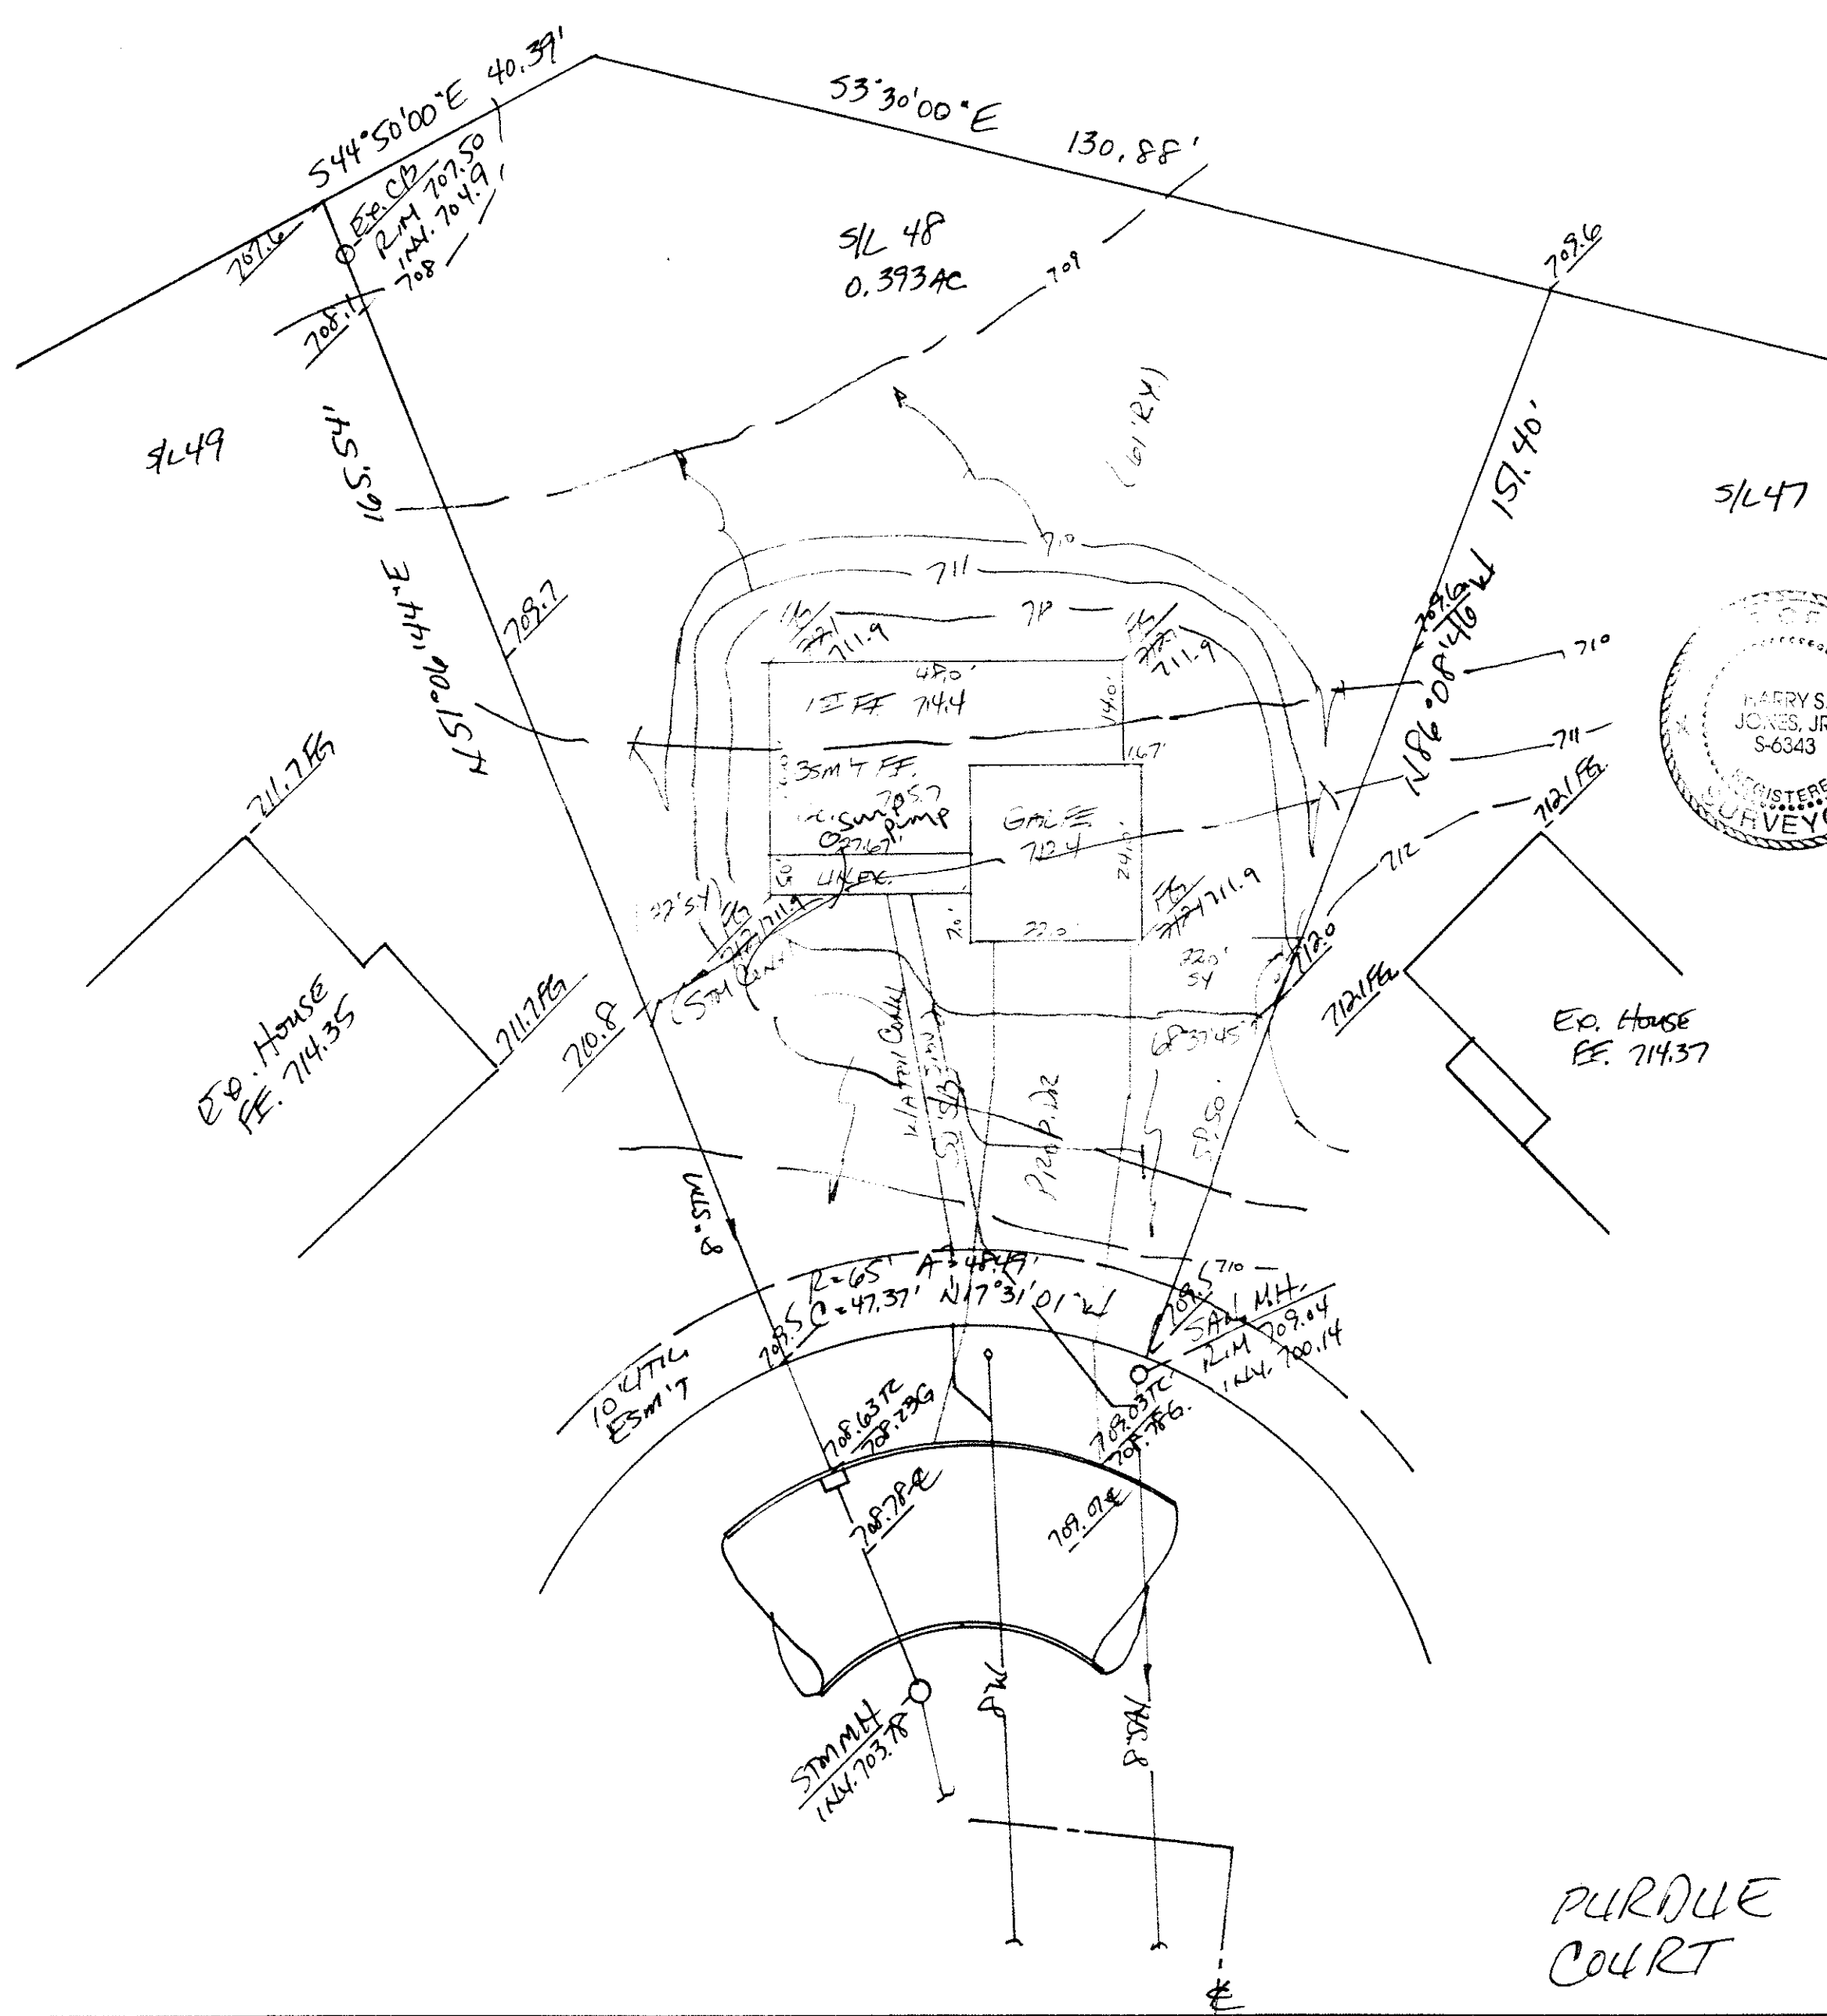

SITE PLAN

PAINESVILLE TOWNSHIP, LAKE COUNTY, OHIO

for: MALKAMALI BUILDERS
CLIENT OWNER

ADDRESS STREET CITY ZIP

HEATHERSTONE VILLAGE #2	LOT	TRACT
SUBDIVISION 25-1 NAME	VOLUME	PAGE
48 VOL. PG. PURDUE COURT	PERM. PARCEL NO.	STREET
SUBLOT NO.		

LEGEND

SANITARY MANHOLE	---○---	WATER VALVE (GAS)	---+---
STORM MANHOLE	---●---	WATER METER (GAS)	---+---
INLET OR CATCH BASIN	---■---	AS BUILT ELEVATION	100.0
HYDRANT	---○---	INDICATES DIRECTION OF SURFACE DRAINAGE	100.0
EXISTING CONTOURS	---		
PROPOSED CONTOURS	---		
EXIST. ELEV.	100.0	PROP. ELEV.	100.0

REMARKS

ALL BOUNDARY DATA SHOWN WAS OBTAINED FROM (DEEDS, RECORDED SUBDIVISION PLAT OR OTHER PUBLIC RECORDS)
LOCATIONS AS SHOWN OF ADJACENT WELLS AND SEPTIC TANKS OBTAINED FROM LAKE COUNTY HEALTH DEPARTMENT

DESIGN CERTIFICATION

THIS PLAT WAS PREPARED BY ME, AND IS CORRECT TO THE BEST OF MY KNOWLEDGE AND BELIEF.

NAME Harry S. Jones, Jr. SURVEYOR REGISTRATION NO. 6343

CHECK LIST

NO. OF BEDROOMS	WATER MAIN SIZE, LOCATION
DIMENSIONS	SAN. SEWER SIZE % GR. LOC.
BEARINGS	SAN. MH. CAST. ELEV. INV. ELEV.
TIE TO NEAREST STREET	SAN. CONN. SIZE, LOC. DEPTH
SUBLOT NO. PARCEL NO.	STORM SEWER SIZE % GR. LOC.
SURROUNDING OWNERS	STORM MH. CAST. ELEV. INV. ELEV.
BLDG. DIMENSIONS FIN. GR.	PAVT TYPE GRADE CURBS
BLDG. TIES FL'R. GRADES	GAS LINE LOC. SIZE PRESSURE
APRON TYPE WIDTH THICKNESS	SEPTIC TANK LOCATION & DUPLICATION AREA
SIDEWALK TYPE WIDTH THICKNESS	WELL LOCATION
CULVERT TYPE DIA. LENGTH	ISOLATION RADIUS FROM WELL
ROCK OUTCROPPINGS	

REVISIONS			PLAN PREPARED BY:	
NO.	DATE	BY	BABCOCK • JONES & ASSOCIATES, INC.	
1			PAINESVILLE, OHIO	
2			DRAWN BY <u>HJ</u>	SCALE <u>1" = 20'</u>
3			CHK'D. <u>HJ</u>	DATE <u>2/20/76</u>
4			CREW CHIEF <u>KJ</u>	APP'D. <u>HJ</u>
5				PHONE NO. 357-1811
				DRAWING NO. 92-186-48

"AS BUILT" CERTIFICATION

I, HEREBY CERTIFY THAT THE CIRCLED GRADES ARE EXISTING FINISH GRADES CHECKED IN THE FIELD ON _____, 19____, AND ARE CORRECT TO THE BEST OF MY KNOWLEDGE AND BELIEF.

REGISTERED SURVEYOR REG. NO.

TBM - RIM SAN. M.H. 7647, 5/48
elev. = 709.04

- GIH 3-796
- DISCHARGE Sump pump to STM - GWN
- Lower F6 to 24.9

ROOF DRAINS
SHALL DISCHARGE
TO SPLASH BLOCKS.

PURDUE
COURT