


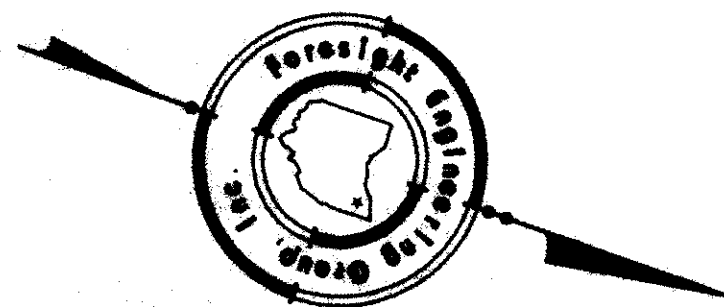

Foresight Engineering Group
Engineers & Surveyors
216 286-1010
216 286-1034 fax
320 Center Street, Unit F
Gordon, Ohio 44024

SCALE : Horz. 1" = 20'
Vert. NONE
FILE NAME:
I:\DEC19620\sl-72
DATE :
Dec. 11, 1996


REVISIONS:	

DECO HOMES
Heatherstone Vill. No 2, Ph 3 - S/L 72
Painesville Twp. - Lake County - Ohio
Site Plan

SYMBOL LEGEND	
	Monument Box w/ Pin
	Iron Pin Set
	Cable TV
	Manhole
	Water Shut Off Valve
	Telephone Soc Box
	Electrical Box
	Fire Hydrant
	Catch Basin
	Iron Pin Found
	Curb Inlet


NOTE:
Heatherstone Village Subdivision No. 2, Phase
recorded in Volume 25, Page 1, Lake County Plats.
By TSK Date 1-10-97
Scale as Shown

Grading Plan Approved
as shown and/or noted
THOMAS P. GILLES, P.E.
Lake County Engineer

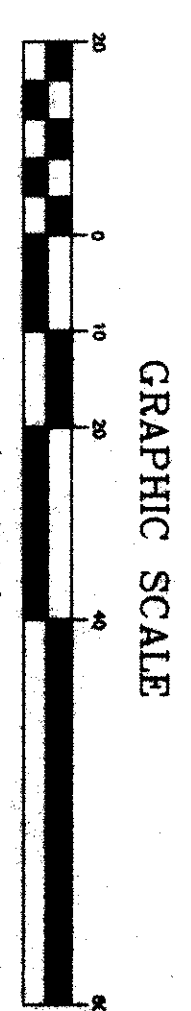

A = 1301.16'
T = 330.00'
L = 37.66'
L = 73.00'
L = 74.92'
74.92'

Radley Drive - 60'

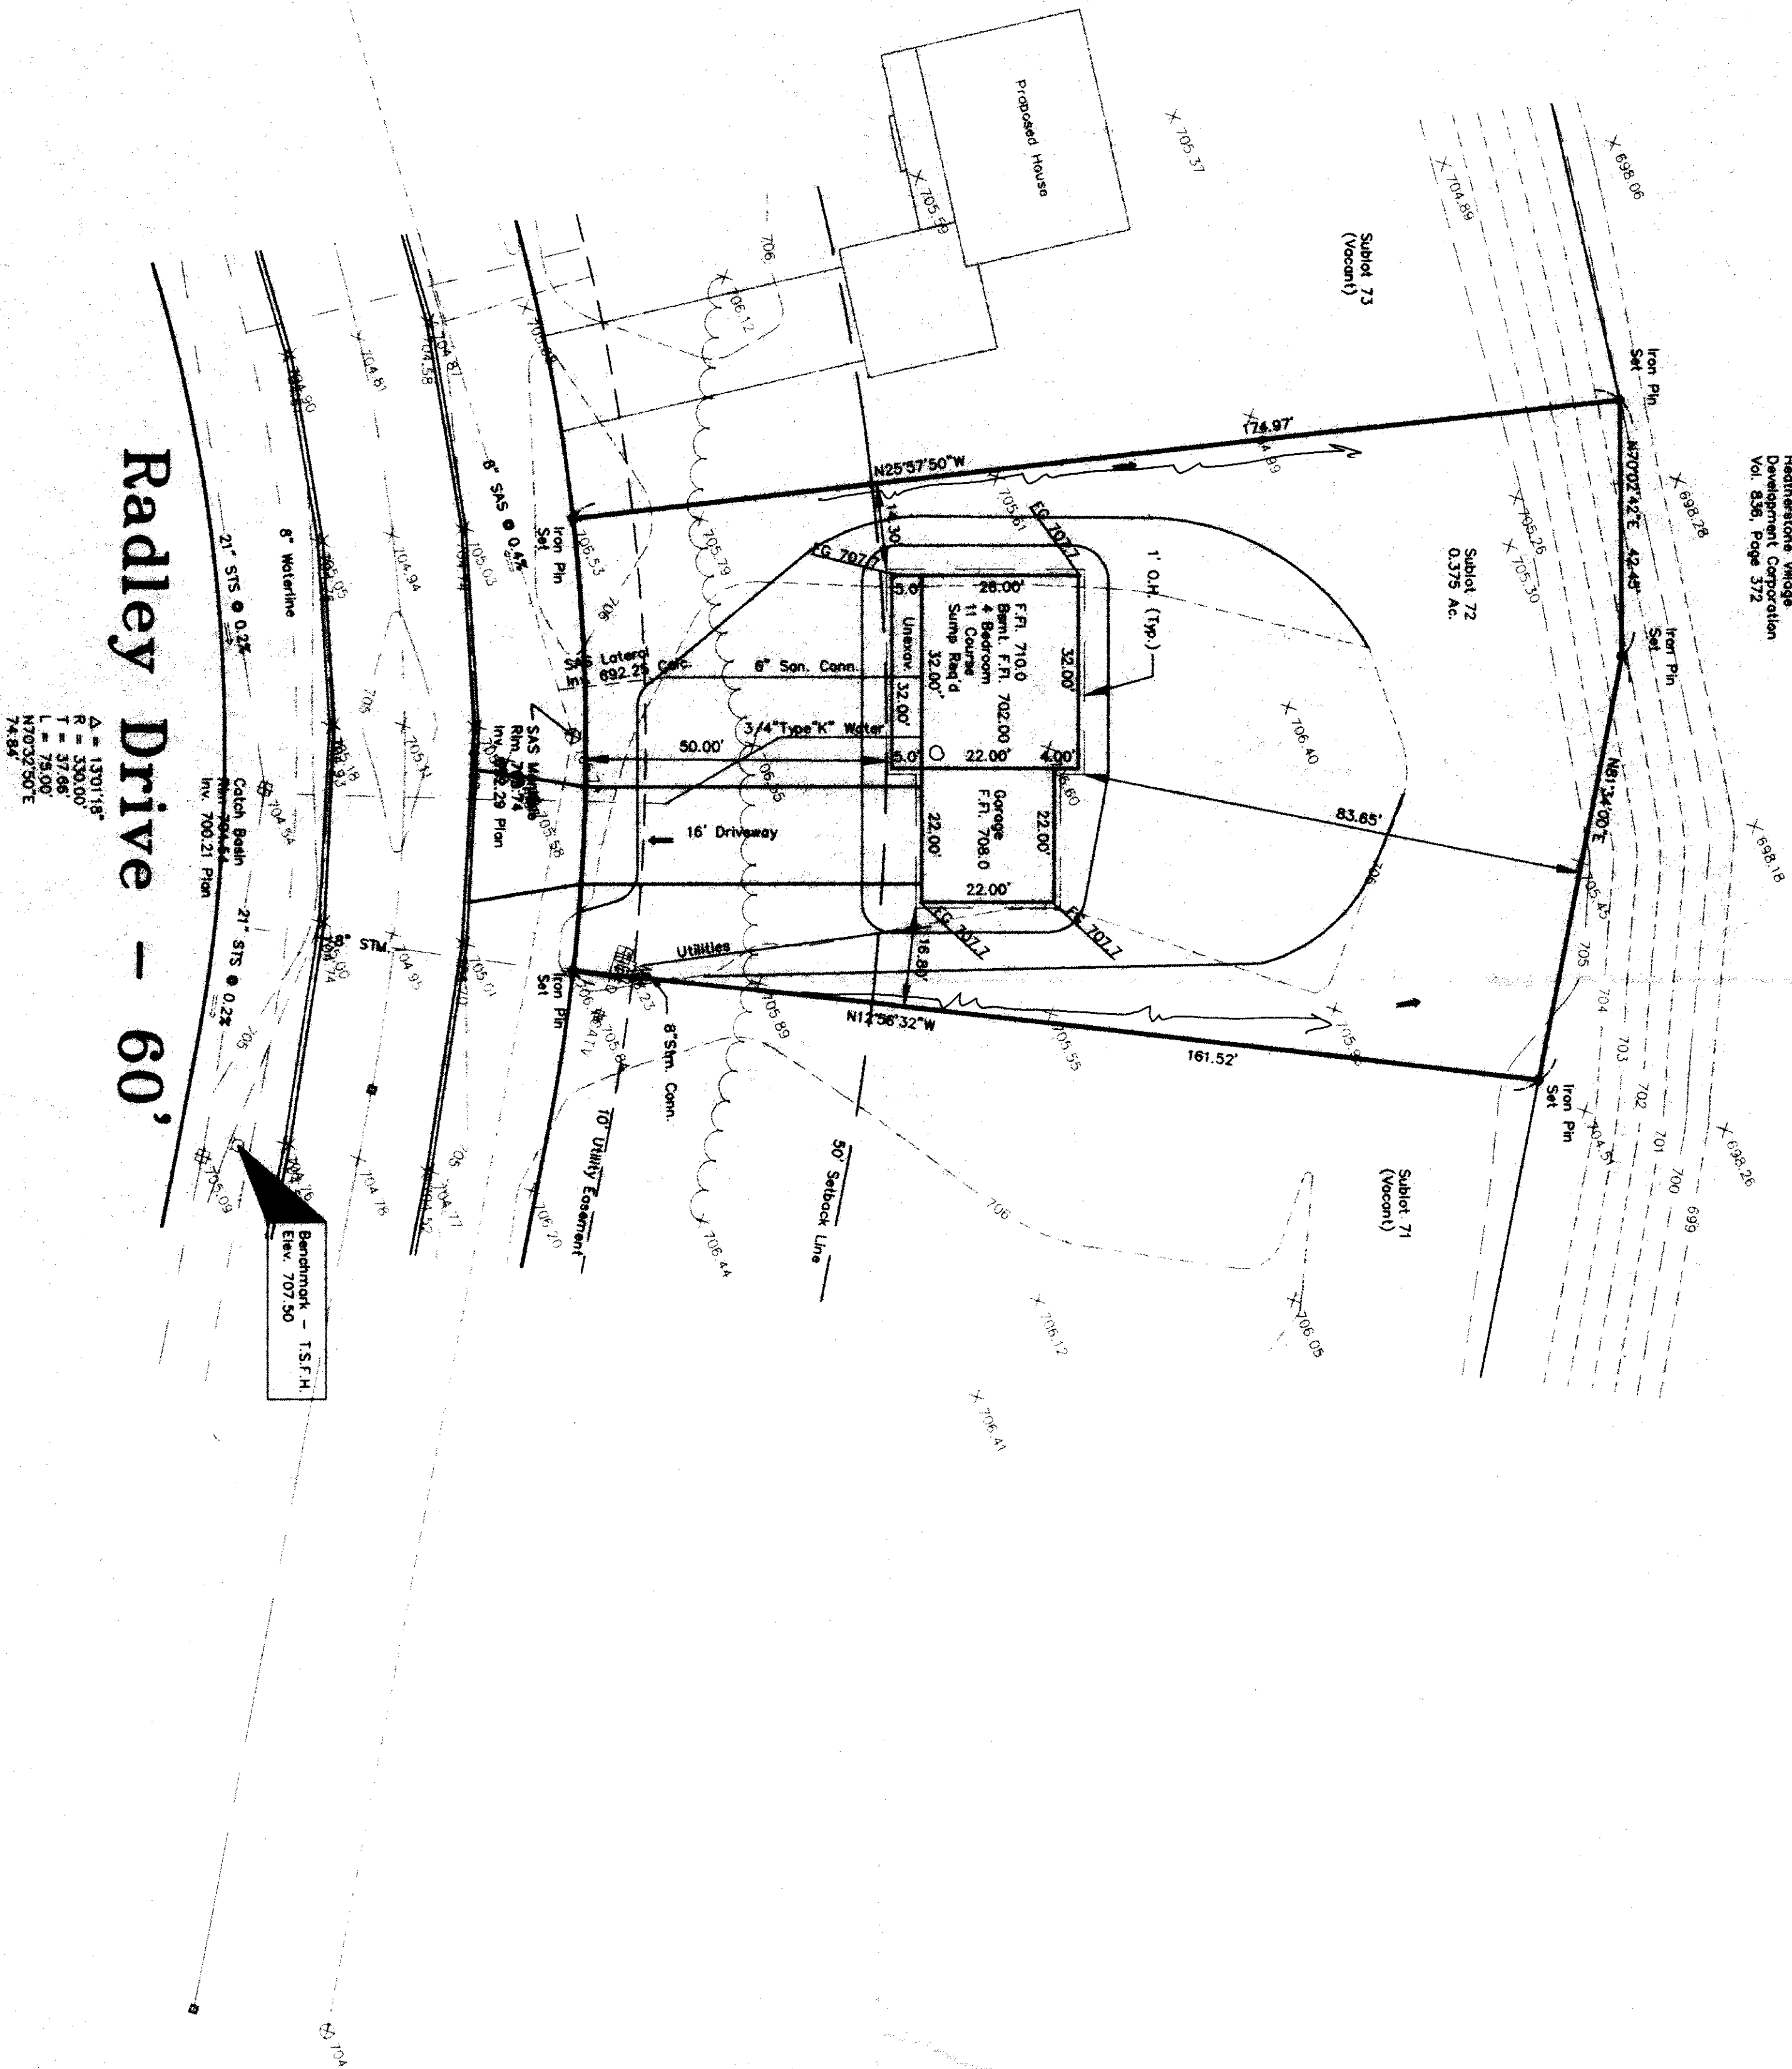

Heatherstone Village
Subdivision
Vol. 25, Page 372

APPROVED
PAINEVILLE TOWNSHIP
2012-12-13
[Signature]