


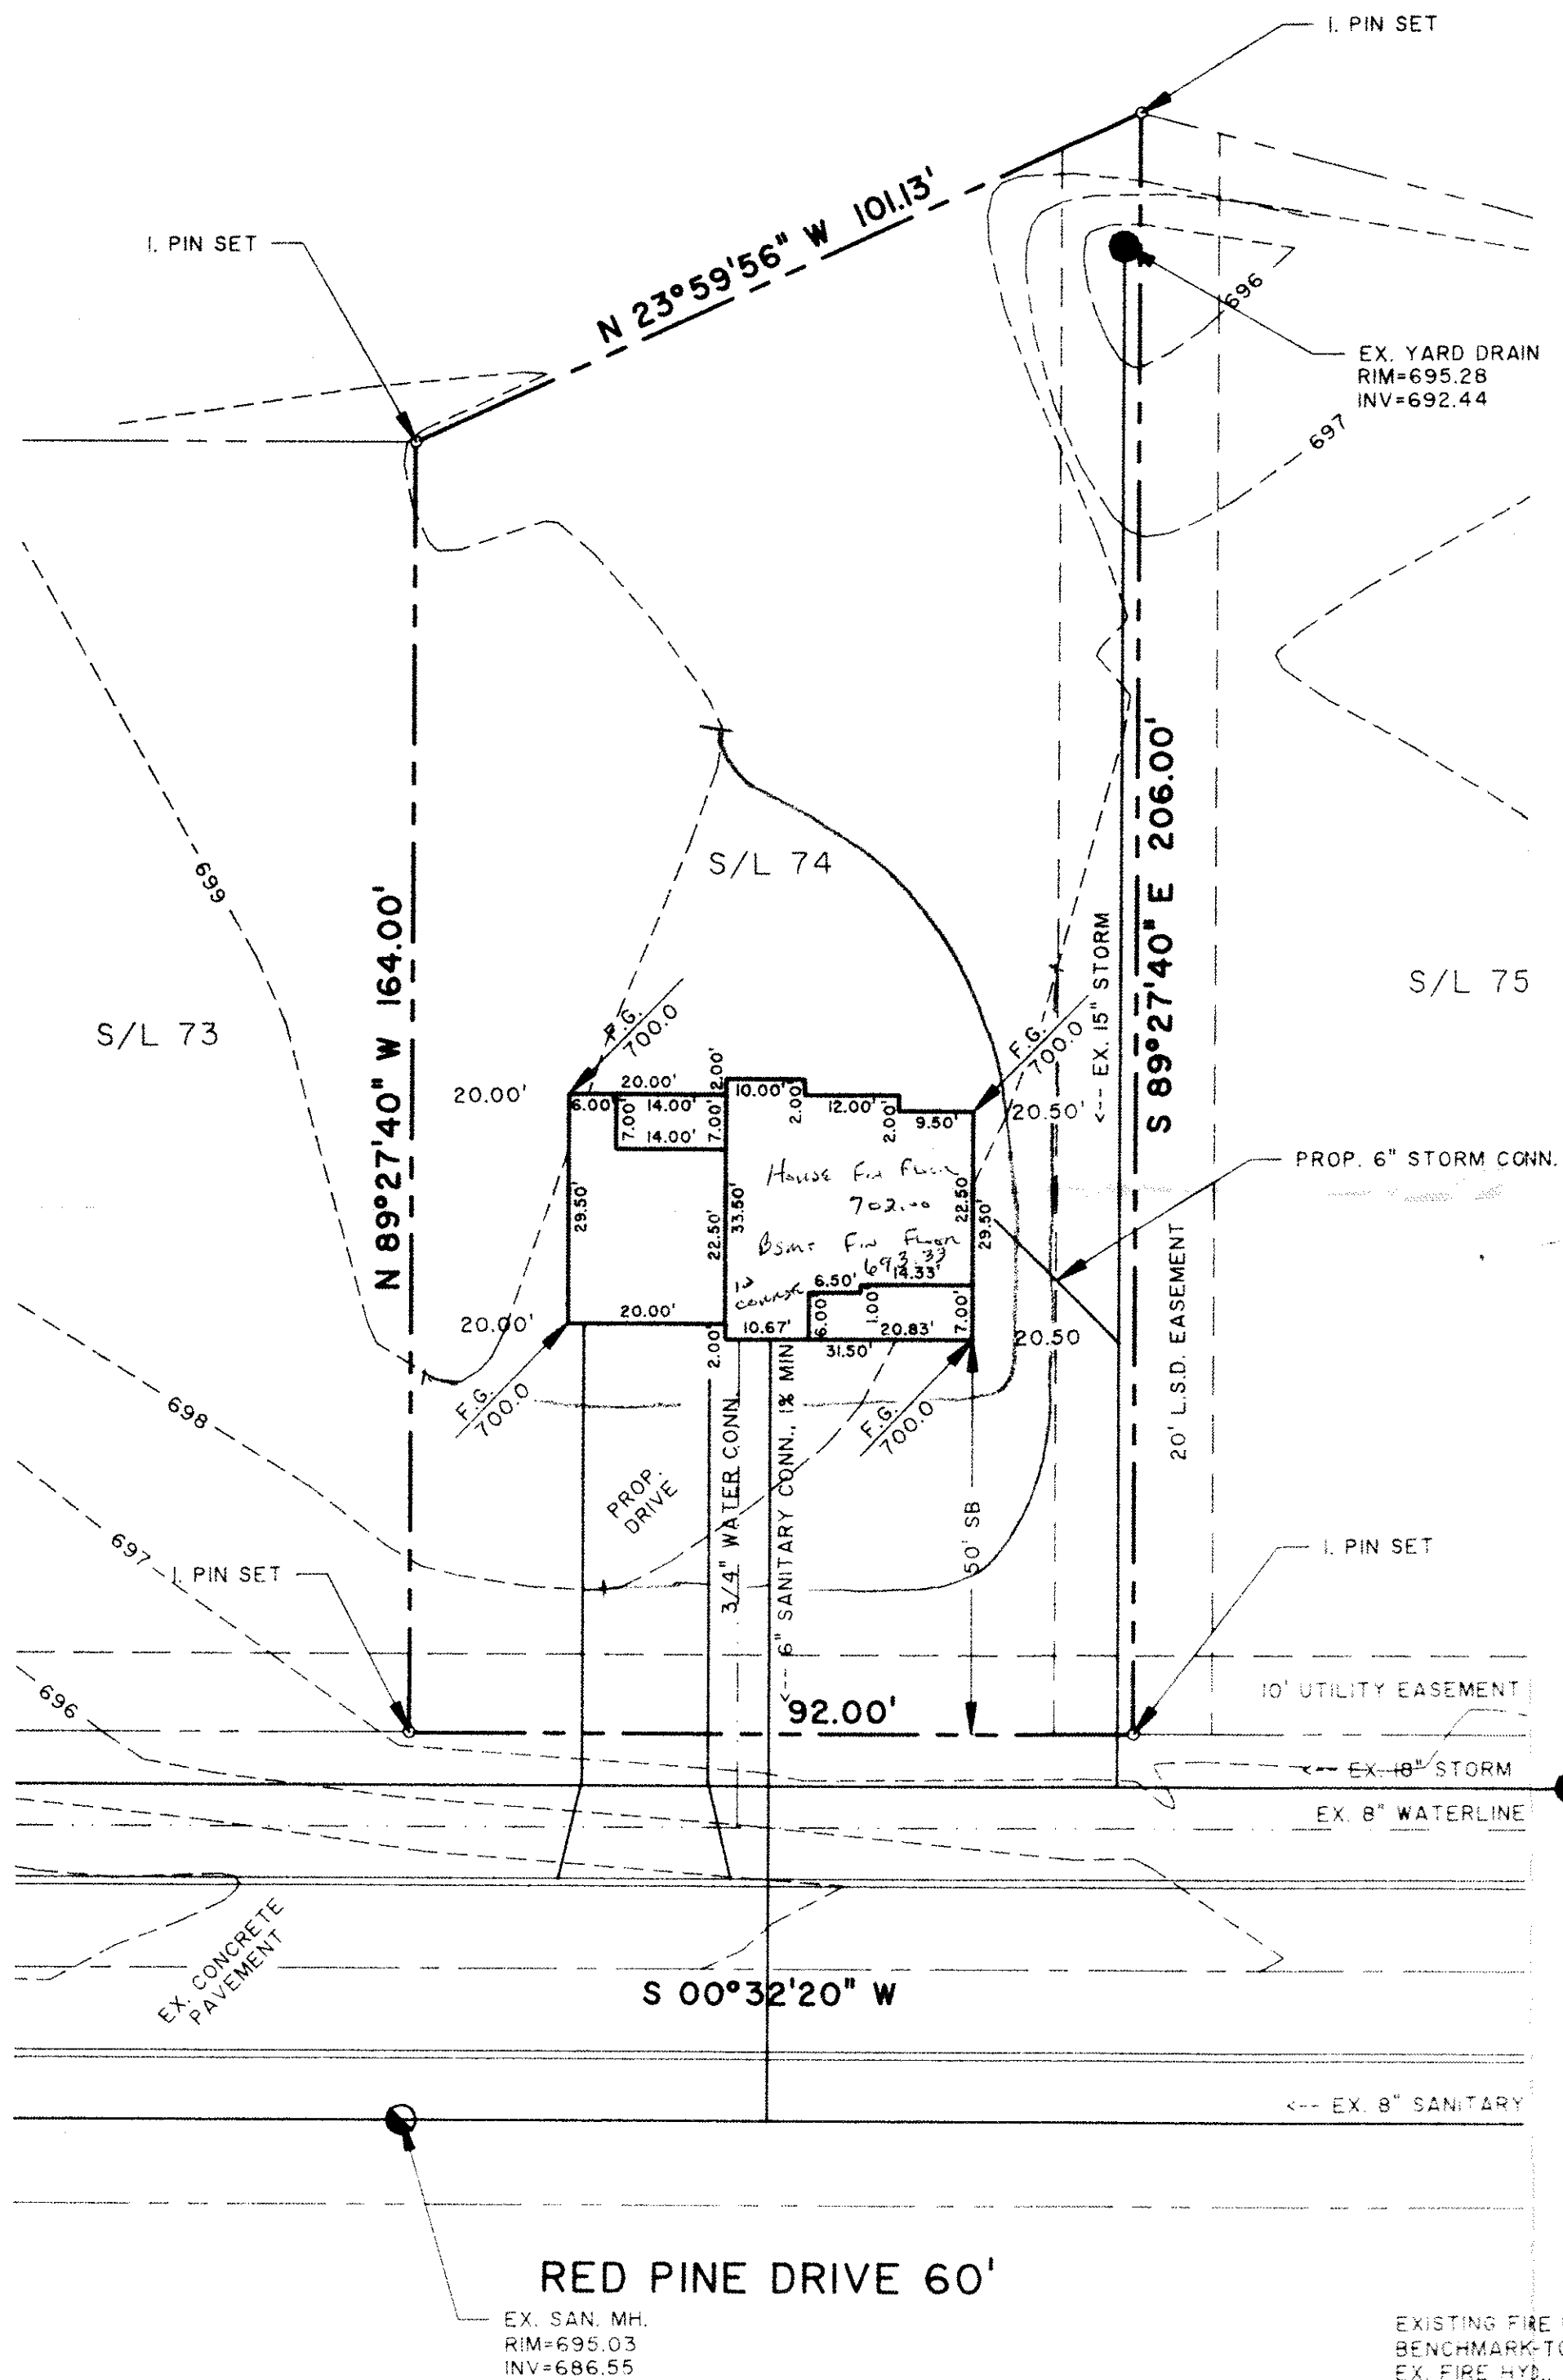

Grading Plan Approved
 by 6/14 Date 6-4-96
 THOMAS P. GILLES, P.E.
 Lake County Engineer


ROOF DRAINS
 SHALL DISCHARGE
 TO SPLASH BLOCKS.

GENERAL NOTES:

1. DRIVEWAY APRON TO BE 6" THICK
2. BENCHMARK - TOP STEM OF FIRE HYDRANT LOCATED IN FRONT OF SUBLOT No. 75, ELEV. = 699.11

LEGEND

	EXISTING CONTOUR
	PROPOSED CONTOUR
	EXISTING ELEVATION
	PROPOSED ELEVATION

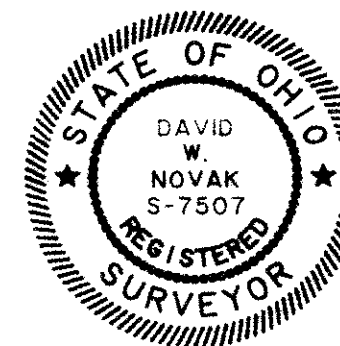

CERTIFICATION

"I THE UNDERSIGNED HEREBY CERTIFY THAT THIS TOPOGRAPHY INDICATED BY 'I' CONTOURS AND ELEVATIONS SHOWN HEREON REPRESENTS AN ACTUAL SURVEY MADE BY ME ON THE 16th DAY OF MAY, 1996 AND THE ELEVATIONS WERE TAKEN AT APPROPRIATE INTERVALS AND AS OF THAT DAY THEY EXISTED AS INDICATED HEREON.

"I HEREBY CERTIFY THAT THIS PLAN WAS PREPARED BY ME AND IS CORRECT TO THE BEST OF MY KNOWLEDGE"

David W. Novak
 DAVID W. NOVAK, P.S. No. 7507

PREPARED BY:

Himebaugh and Novak
 Surveyors and Site Consultants
 8663 Tyler Boulevard
 Mentor, Ohio 44060-4346
 (216) 974-7670, (216) 255-5900 FAX.

SITE PLAN: SUBLOT No. 74, RED PINE DRIVE, PAINESVILLE, OH 44077
 CEDAR GLEN No. 6, VOL. 26, PG. 29
PREPARED FOR: LITTLE MOUNTAIN HOMES, INC.
SCALE: 1" = 20'
DATE: MAY 23, 1996
DRAWN BY: DAVID W. NOVAK

96046-74