

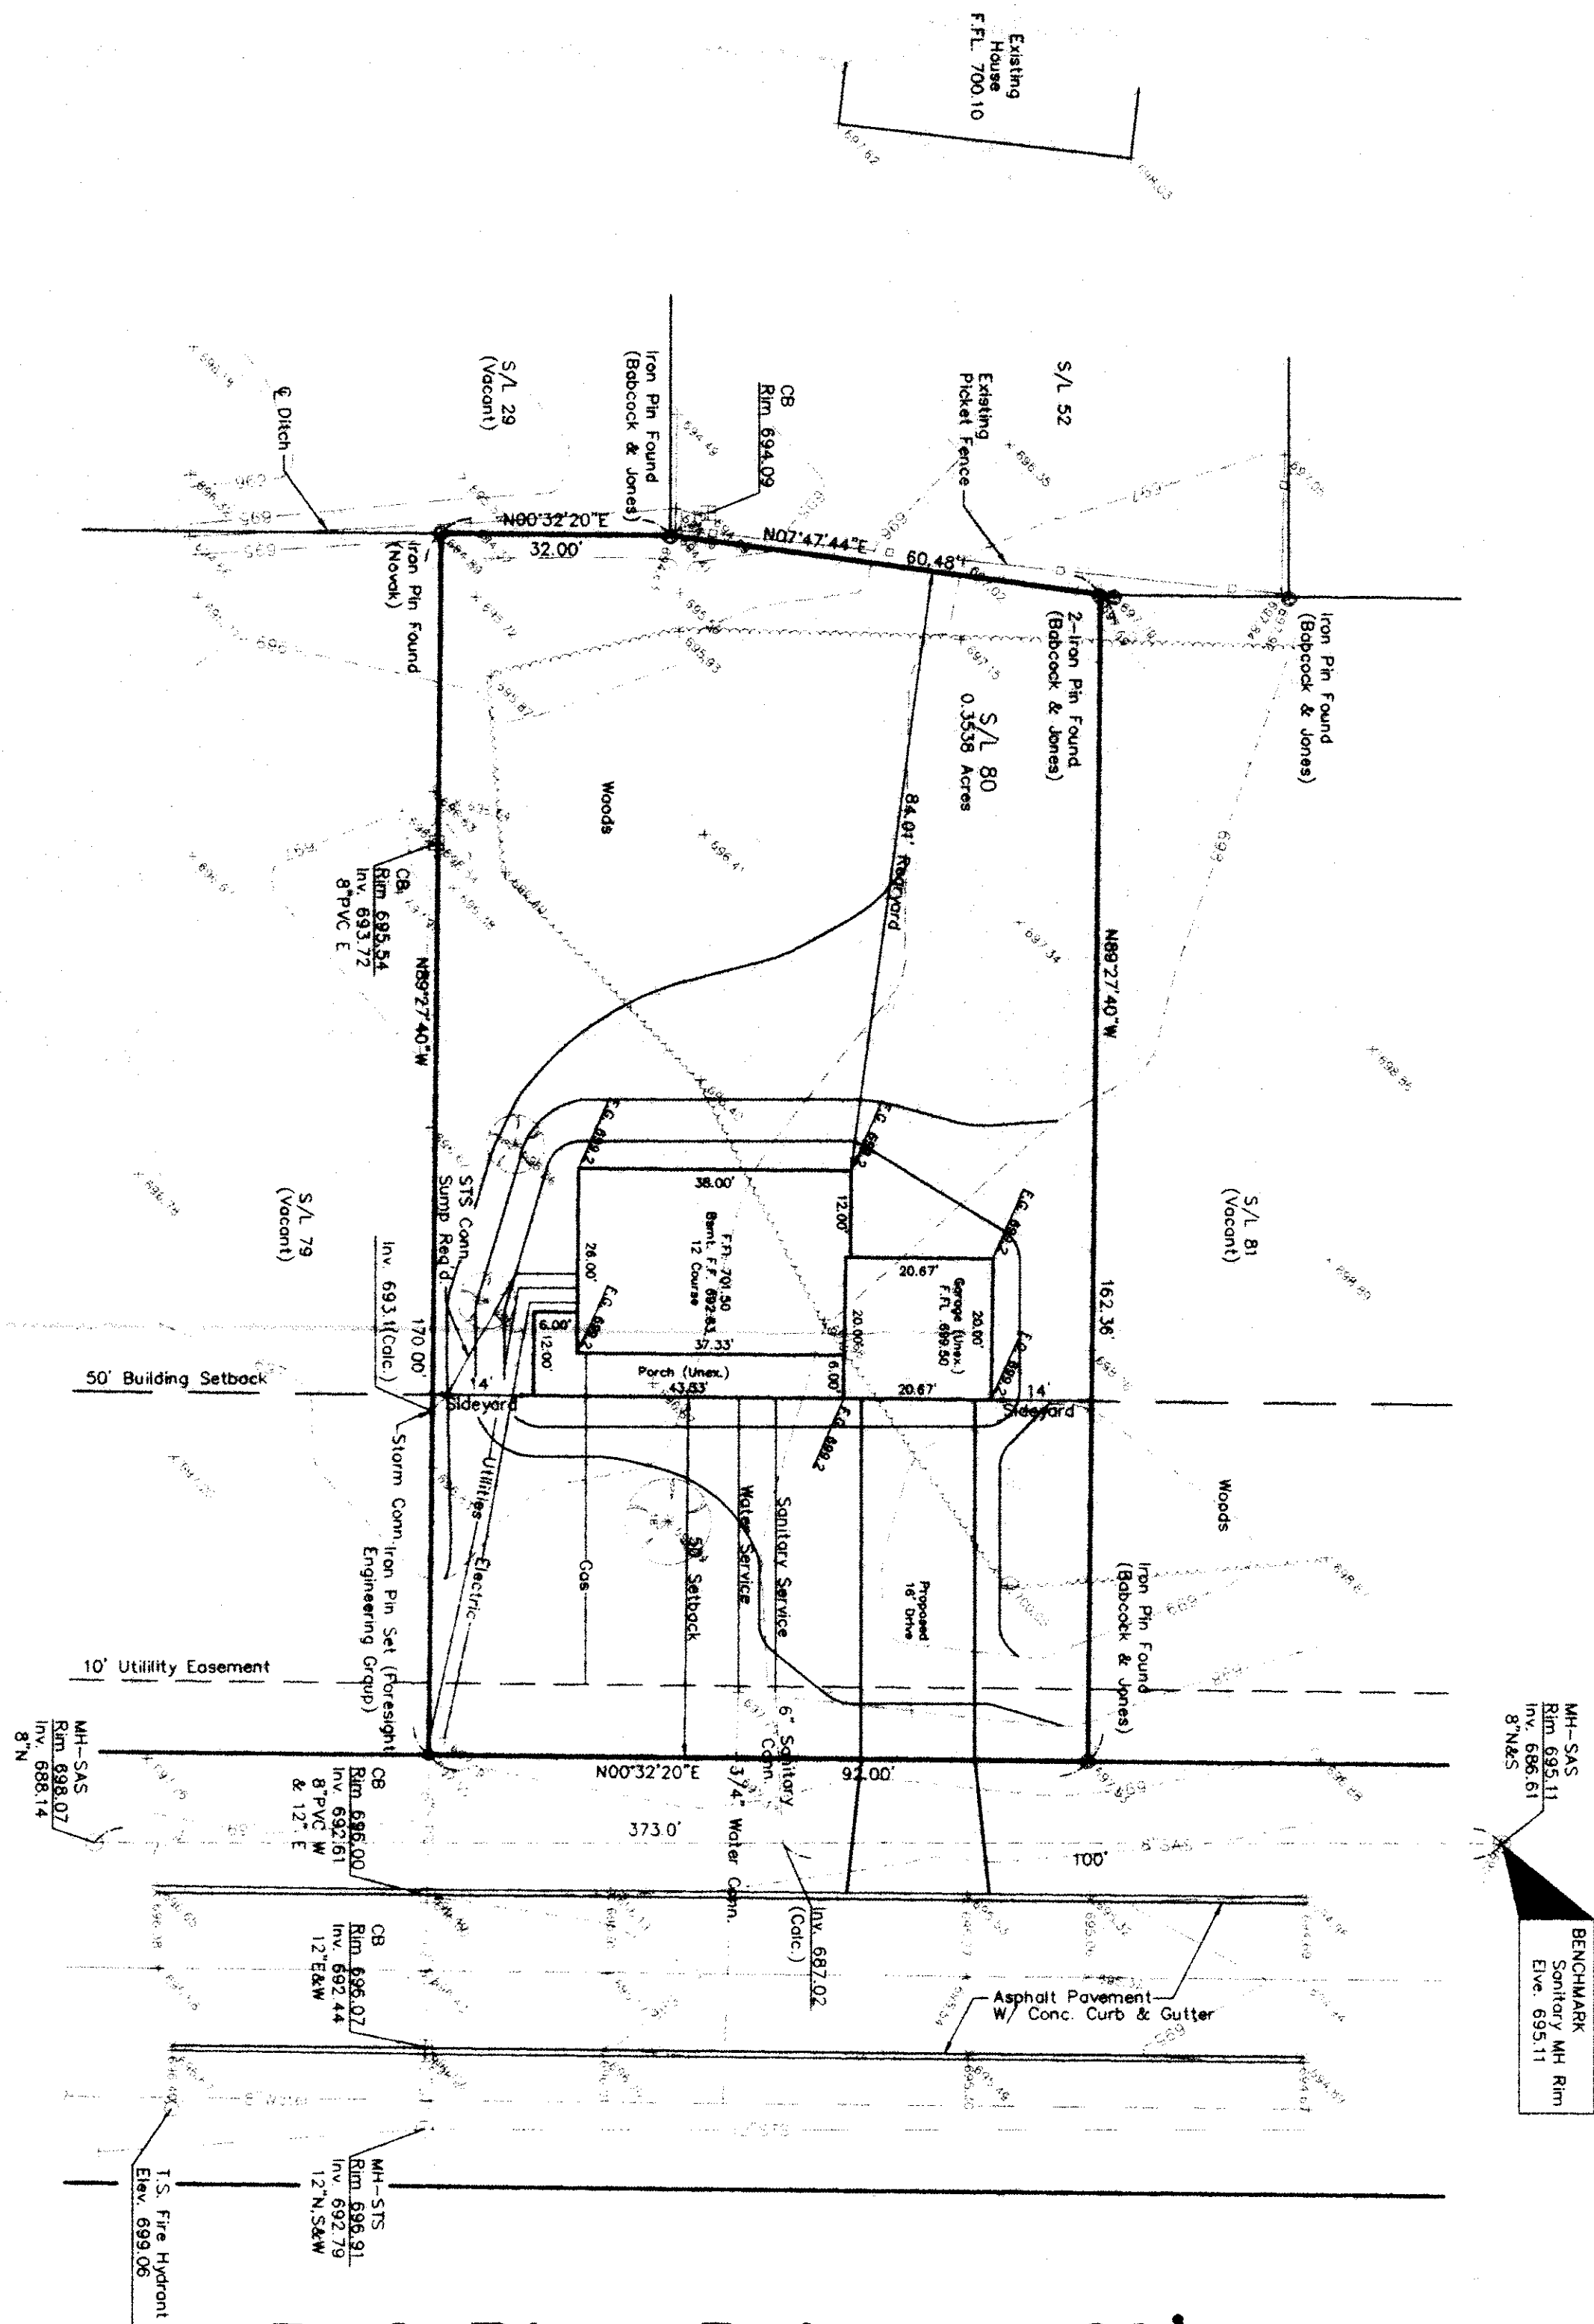



Forrest L. Smith
Forrest L. Smith, Inc.

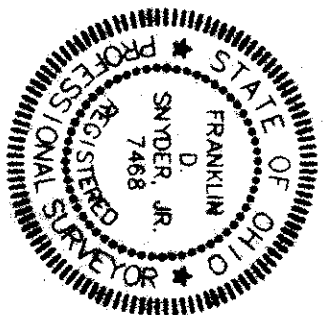

Red Pine Drive - 60'

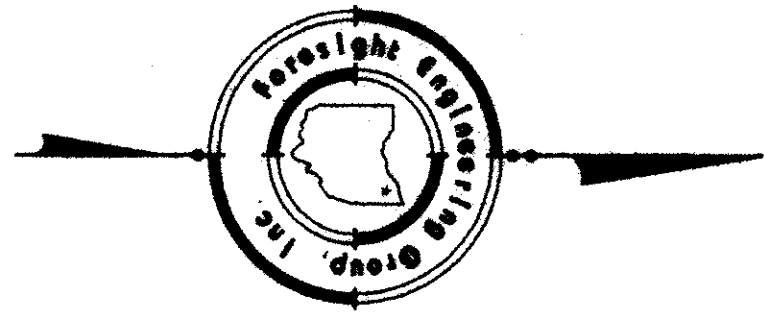

SYMBOL LEGEND	
	Iron Pin Set
	Monohole
	Catch Basin
	Fire Hydrant
	Iron Pin Found
	Tree & Size

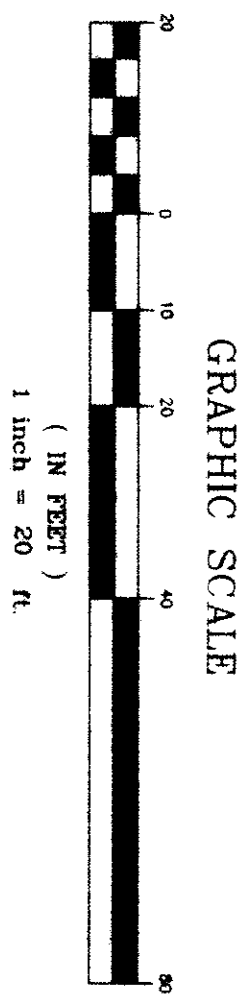

Creating Plan Approved
 as shown and/or noted
 THOMAS P. GILLES, PE
 Lake County Engineer
 By 6/1/12
10-17-96
 Resubmitted
 10/31/96

95 Red Pine Dr

REVISIONS:	SCALE : Horz. 1" = 20'
	Vert. NONE
	FILE NAME:
	I:\RLM19604\SL-80
	DATE :
	October 9, 1996

Foresight Engineering Group

216 286-1010
216 286-1034 fax
320 Center Street, Unit F
Cleveland, Ohio 44024

**Engineers &
Surveyors**

R.L. MOORE HOMES, INC.
Cedar Glen Subdivision - S/L 80
Painesville Twp. - Lake County - Ohio
Site Plan