
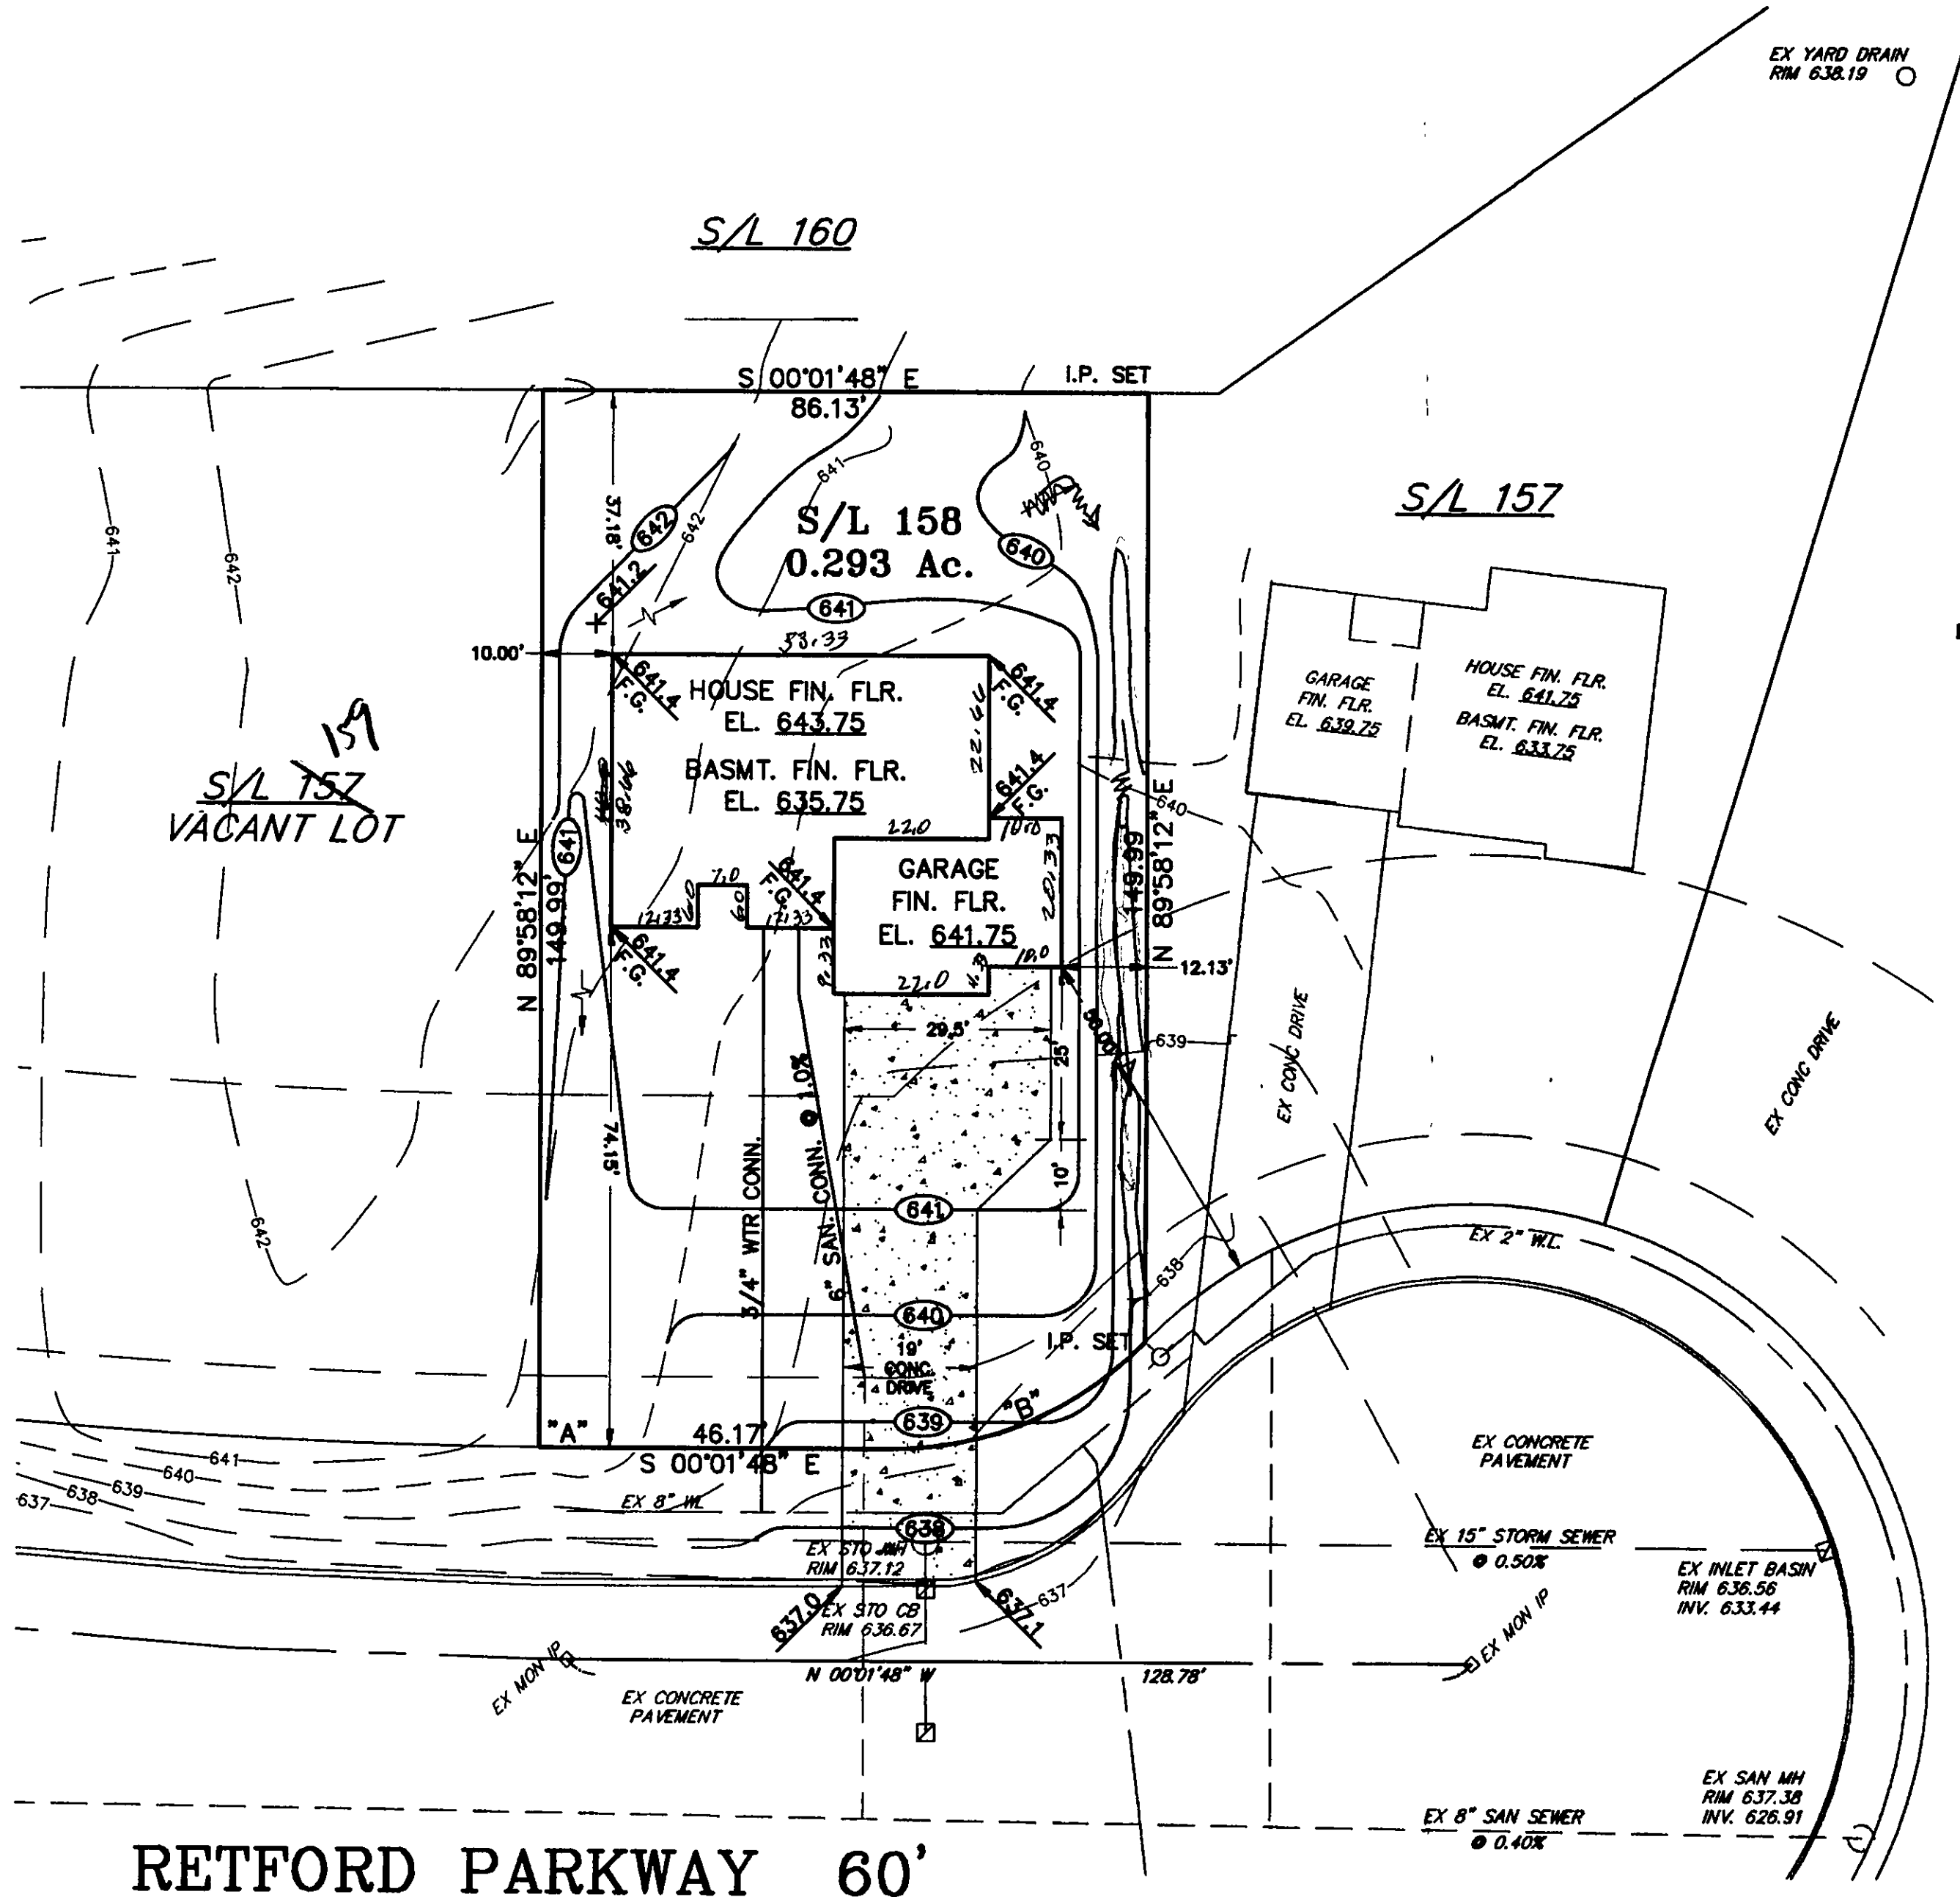


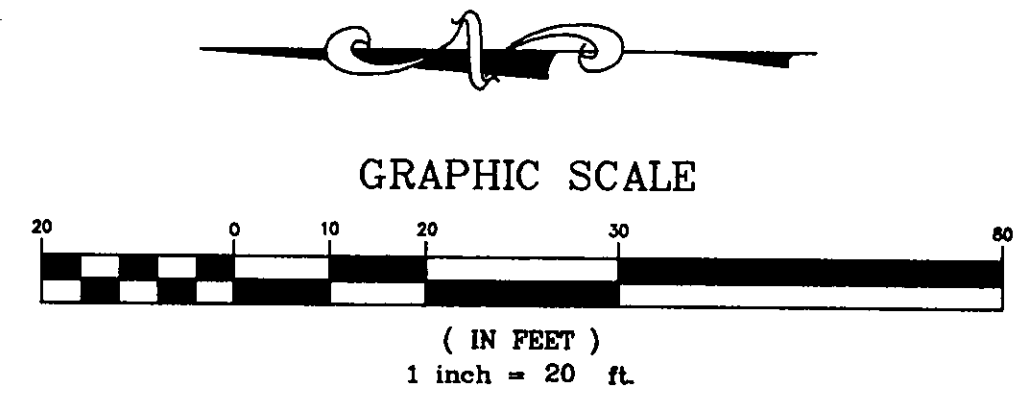

Grading Plan Approved
as shown and/or noted
JAMES R. GILLS, P.E.
Lake County Engineer
By TAM Date 7-31-01
Swale 25' South property line as shown
**ROOF DRAINS
SHALL DISCHARGE
TO SPLASH BLOCKS.**

CURVE DATA "A"
Δ = 00°15'36"
R = 890.00'
L = 4.04'
C = 4.04'
S 00°06'01" W

CURVE DATA "B"
Δ = 45°55'15"
R = 50.00'
L = 40.07'
C = 39.01'
S 22°59'25" E


BENCHMARK:
Q - Q INTERSECTION
RETFORD PARKWAY &
LANARK LANE EL. 636.18

- LEGEND**
- 639.4 F.G. PROPOSED GRADES
 - x 639.4 EXISTING GRADES
 - 639 EXISTING CONTOURS
 - 639 PROPOSED CONTOURS

CERTIFICATION

I HEREBY CERTIFY THAT THIS PLAT WAS
PREPARED BY ME AND IS CORRECT TO THE
BEST OF MY KNOWLEDGE AND BELIEF.
BY: J. Wesley Hall
J. WESLEY HALL, P.E. NO. 58381

APPROVED
PAINESVILLE TOWNSHIP
ZONING DEPARTMENT
2001-263
JRH

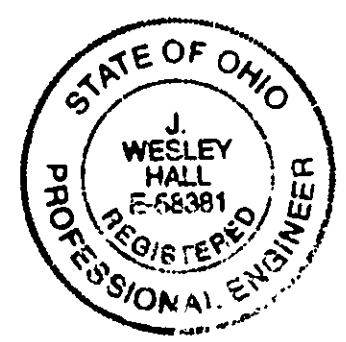

PRINTED
JUL 26 2001
CT CONSULTANTS, INC.

SITE PLAN for: **EDWARD H. TRESGER, INC.**
8100 DEEPWOOD BLVD. MENTOR, OHIO 44060
BEING SUBLOT NO. 158 IN THE PINES RE-SUBDIVISION NO. 1 IN PAINESVILLE TOWNSHIP, OHIO.

DATE JULY 2001
SCALE 1"=20'
DRAWN BY K.P.A.
CHK'D BY J.W.H.
F.B.# 1194 PG. 67

CT Consultants, Inc.
Engineers • Architects • Planners
Willoughby • Mentor • Columbus • North Canton • Youngstown

SHEET 1 OF 1
CONTRACT NO. 94290~32

H:\CT\9429032\DWG\SL158.dwg 07/24/2001 01:53:34 PM EDT