
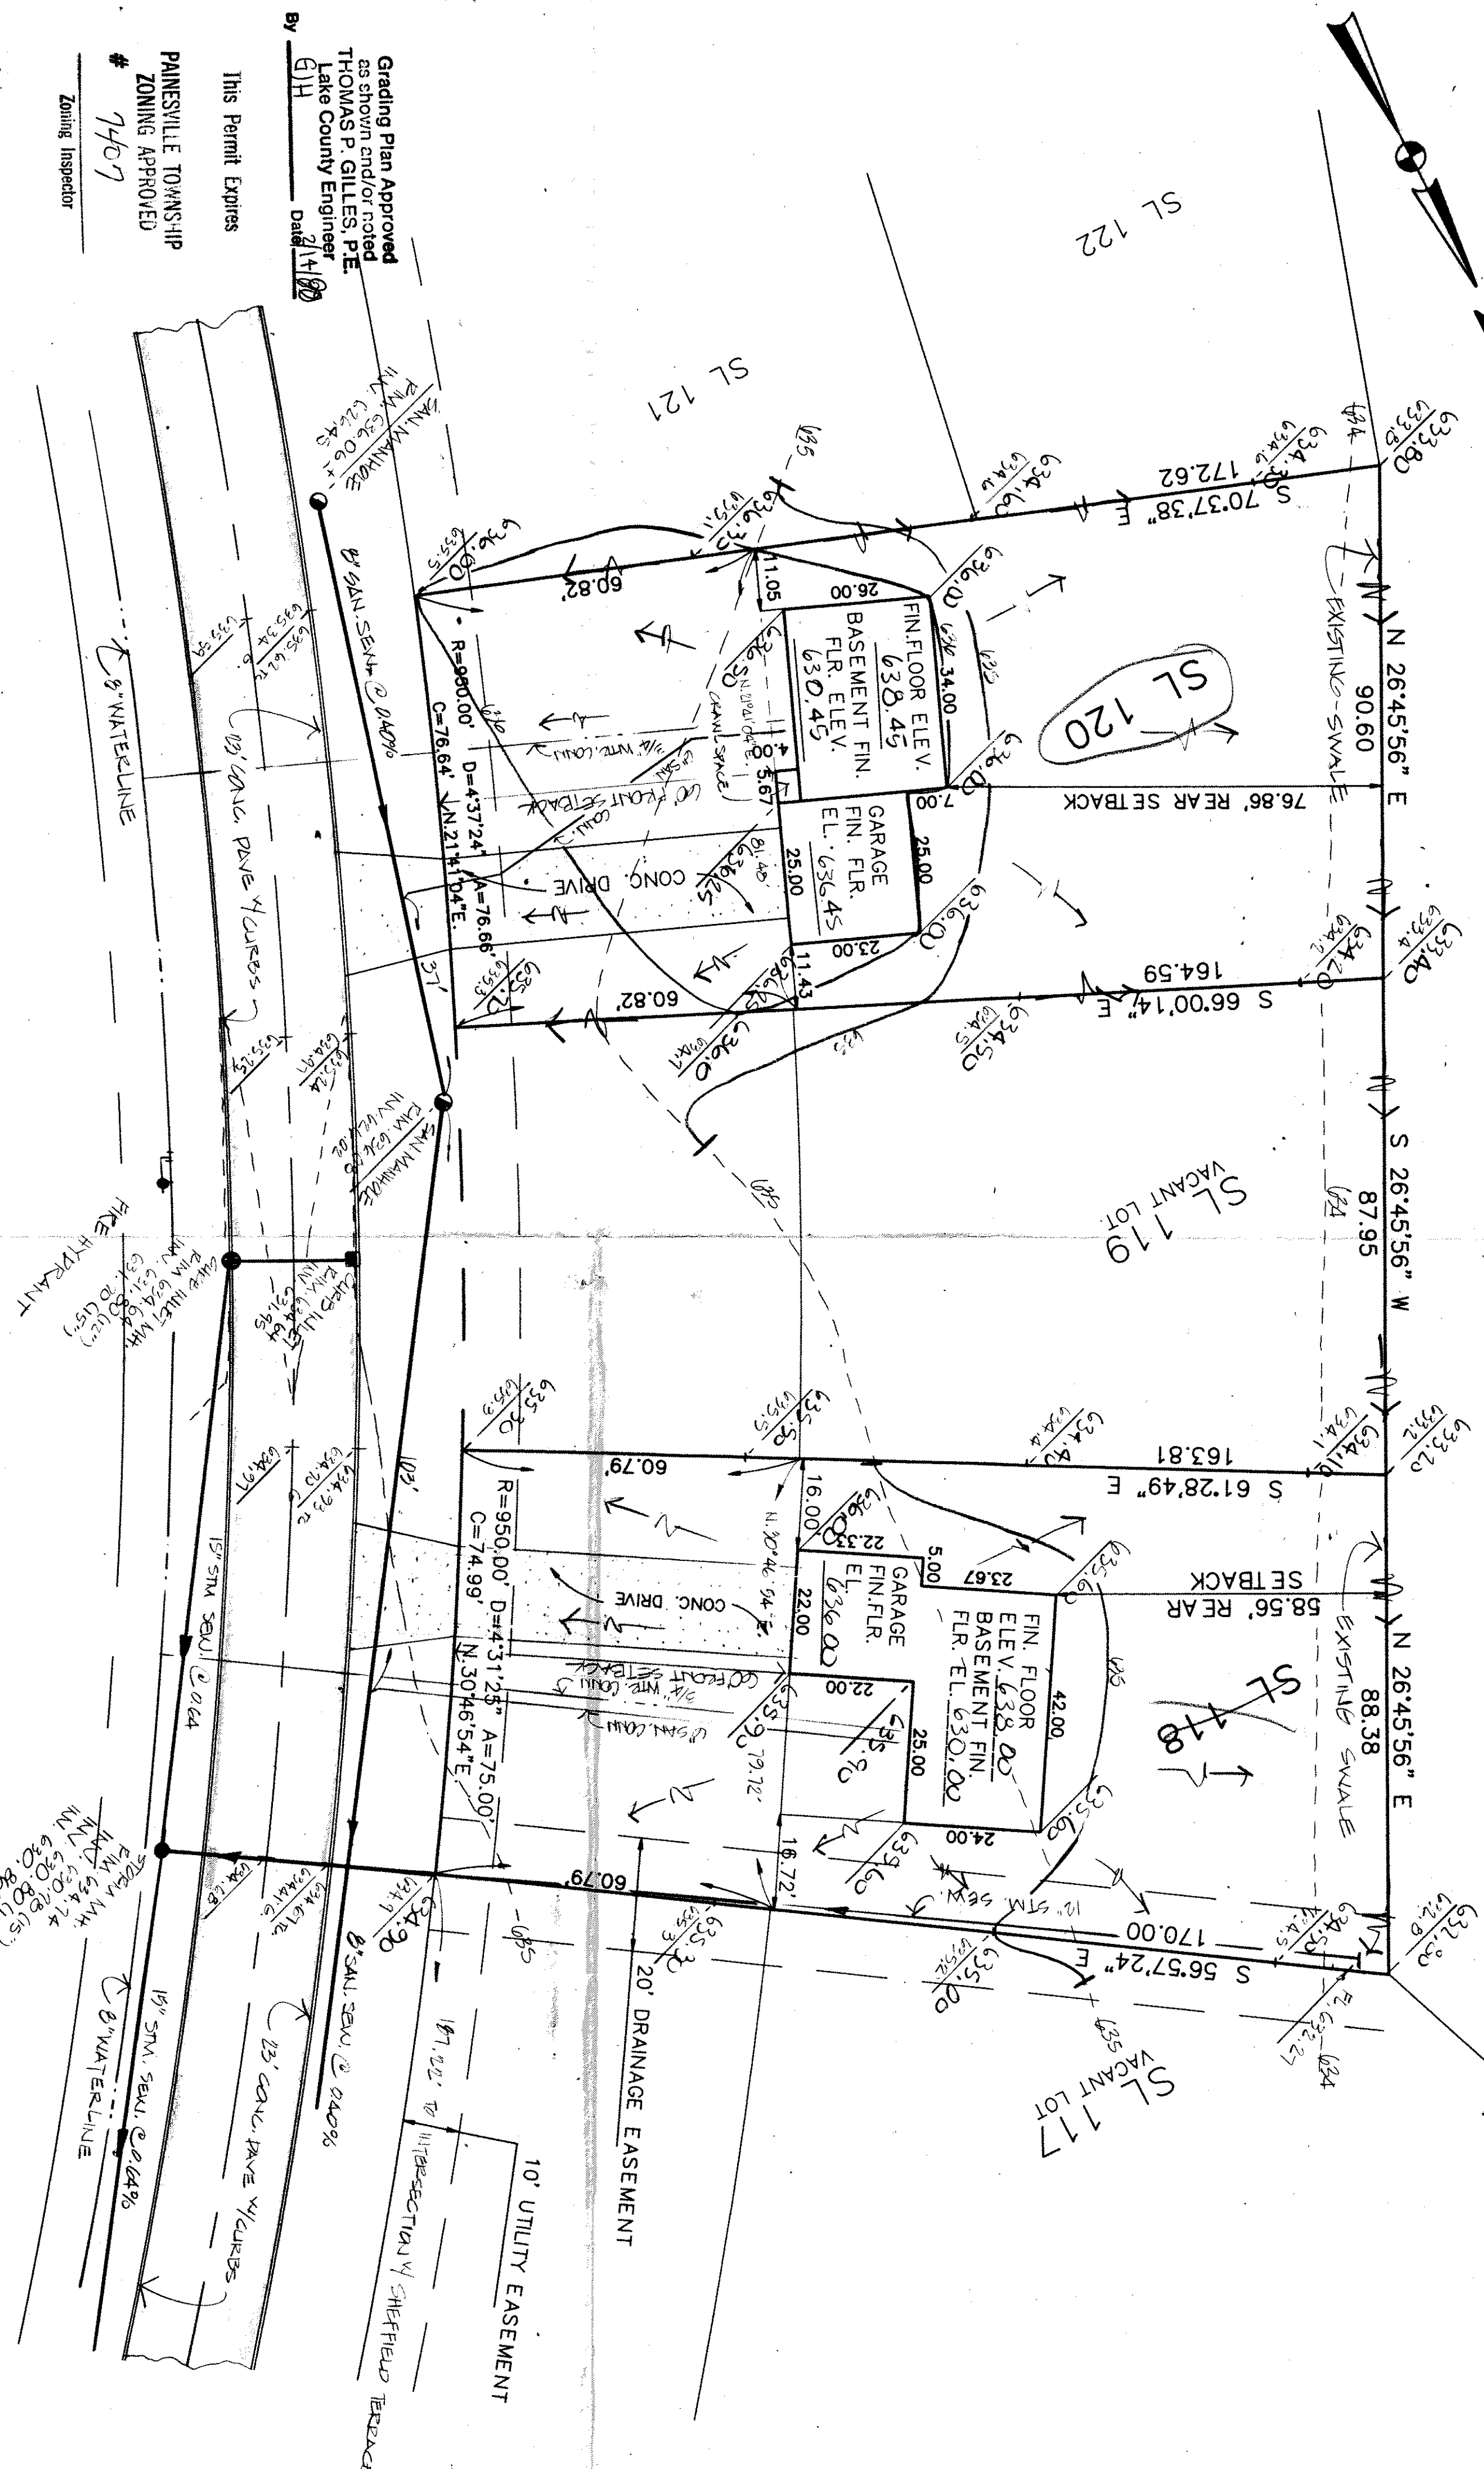


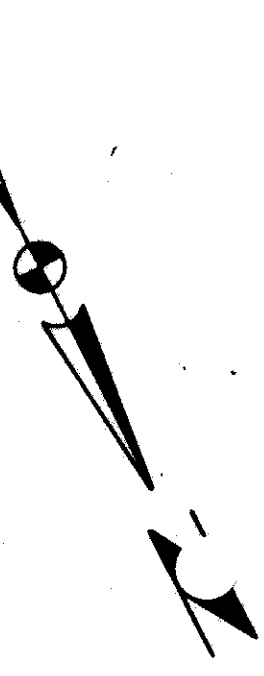


Grading Plan Approved
as shown and/or noted
THOMAS P. GILLES, P.E.
Lake County Engineer
By G.H. Date 2/1/00

This Permit Expires
PAINESVILLE TOWNSHIP
ZONING APPROVED
7467
Zoning Inspector

BENCH MARK: DRILL HOLE AT INTERSECTION
OF SHEFFIELD TR. &
PARKWAY
EL. 634.14

636.00 PROPOSED GRADES.
636.00 EXISTING ELEVATIONS.
636.00 EXISTING CONTOUR
636.00 PROPOSED CONTOUR

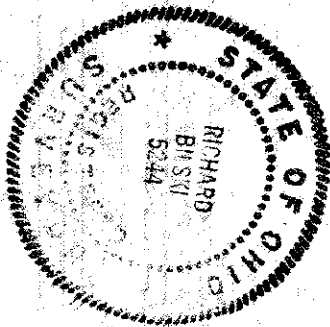

DESIGN CERTIFICATION:
I HEREBY CERTIFY THAT THIS PLAN WAS
PREPARED BY ME AND IS CORRECT TO
THE BEST OF MY KNOWLEDGE AND
BELIEF.
By [Signature]
RICHARD J. BILSKI, P.E. NO. 5244

R E T F O R D
P A R K W A Y
6 0'

SITE PLAN FOR: **EDWARD L. TRESGER, INC.**
8100 DEERWOOD BLVD., MENTOR, OHIO 44060
BEING SUBLOT 117, 118 AND BEING SUBLOT 119 IN THE PINES SUBDIVISION PHASE III-B
IN PAINESVILLE TOWNSHIP, LAKE COUNTY, OHIO.

CT Consultants, Inc.
Engineers • Architects • Planners
Willoughby • Mentor • Columbus • Lorain • North Canton • Steubenville

DATE: 1/27/00
SCALE: 1"=30'
DRAWN BY: [Signature]
CHECKED BY: [Signature]
F&E: 707 NO. 13

SHEET 1 OF 1
CONTRACT NO. 82-478