


DESIGN CERTIFICATION:
 I HEREBY CERTIFY THAT THIS PLAN
 WAS PREPARED BY ME AND IS
 CORRECT TO THE BEST OF MY KNOWLEDGE
 AND BELIEF
 Sd/-
 21/08/19

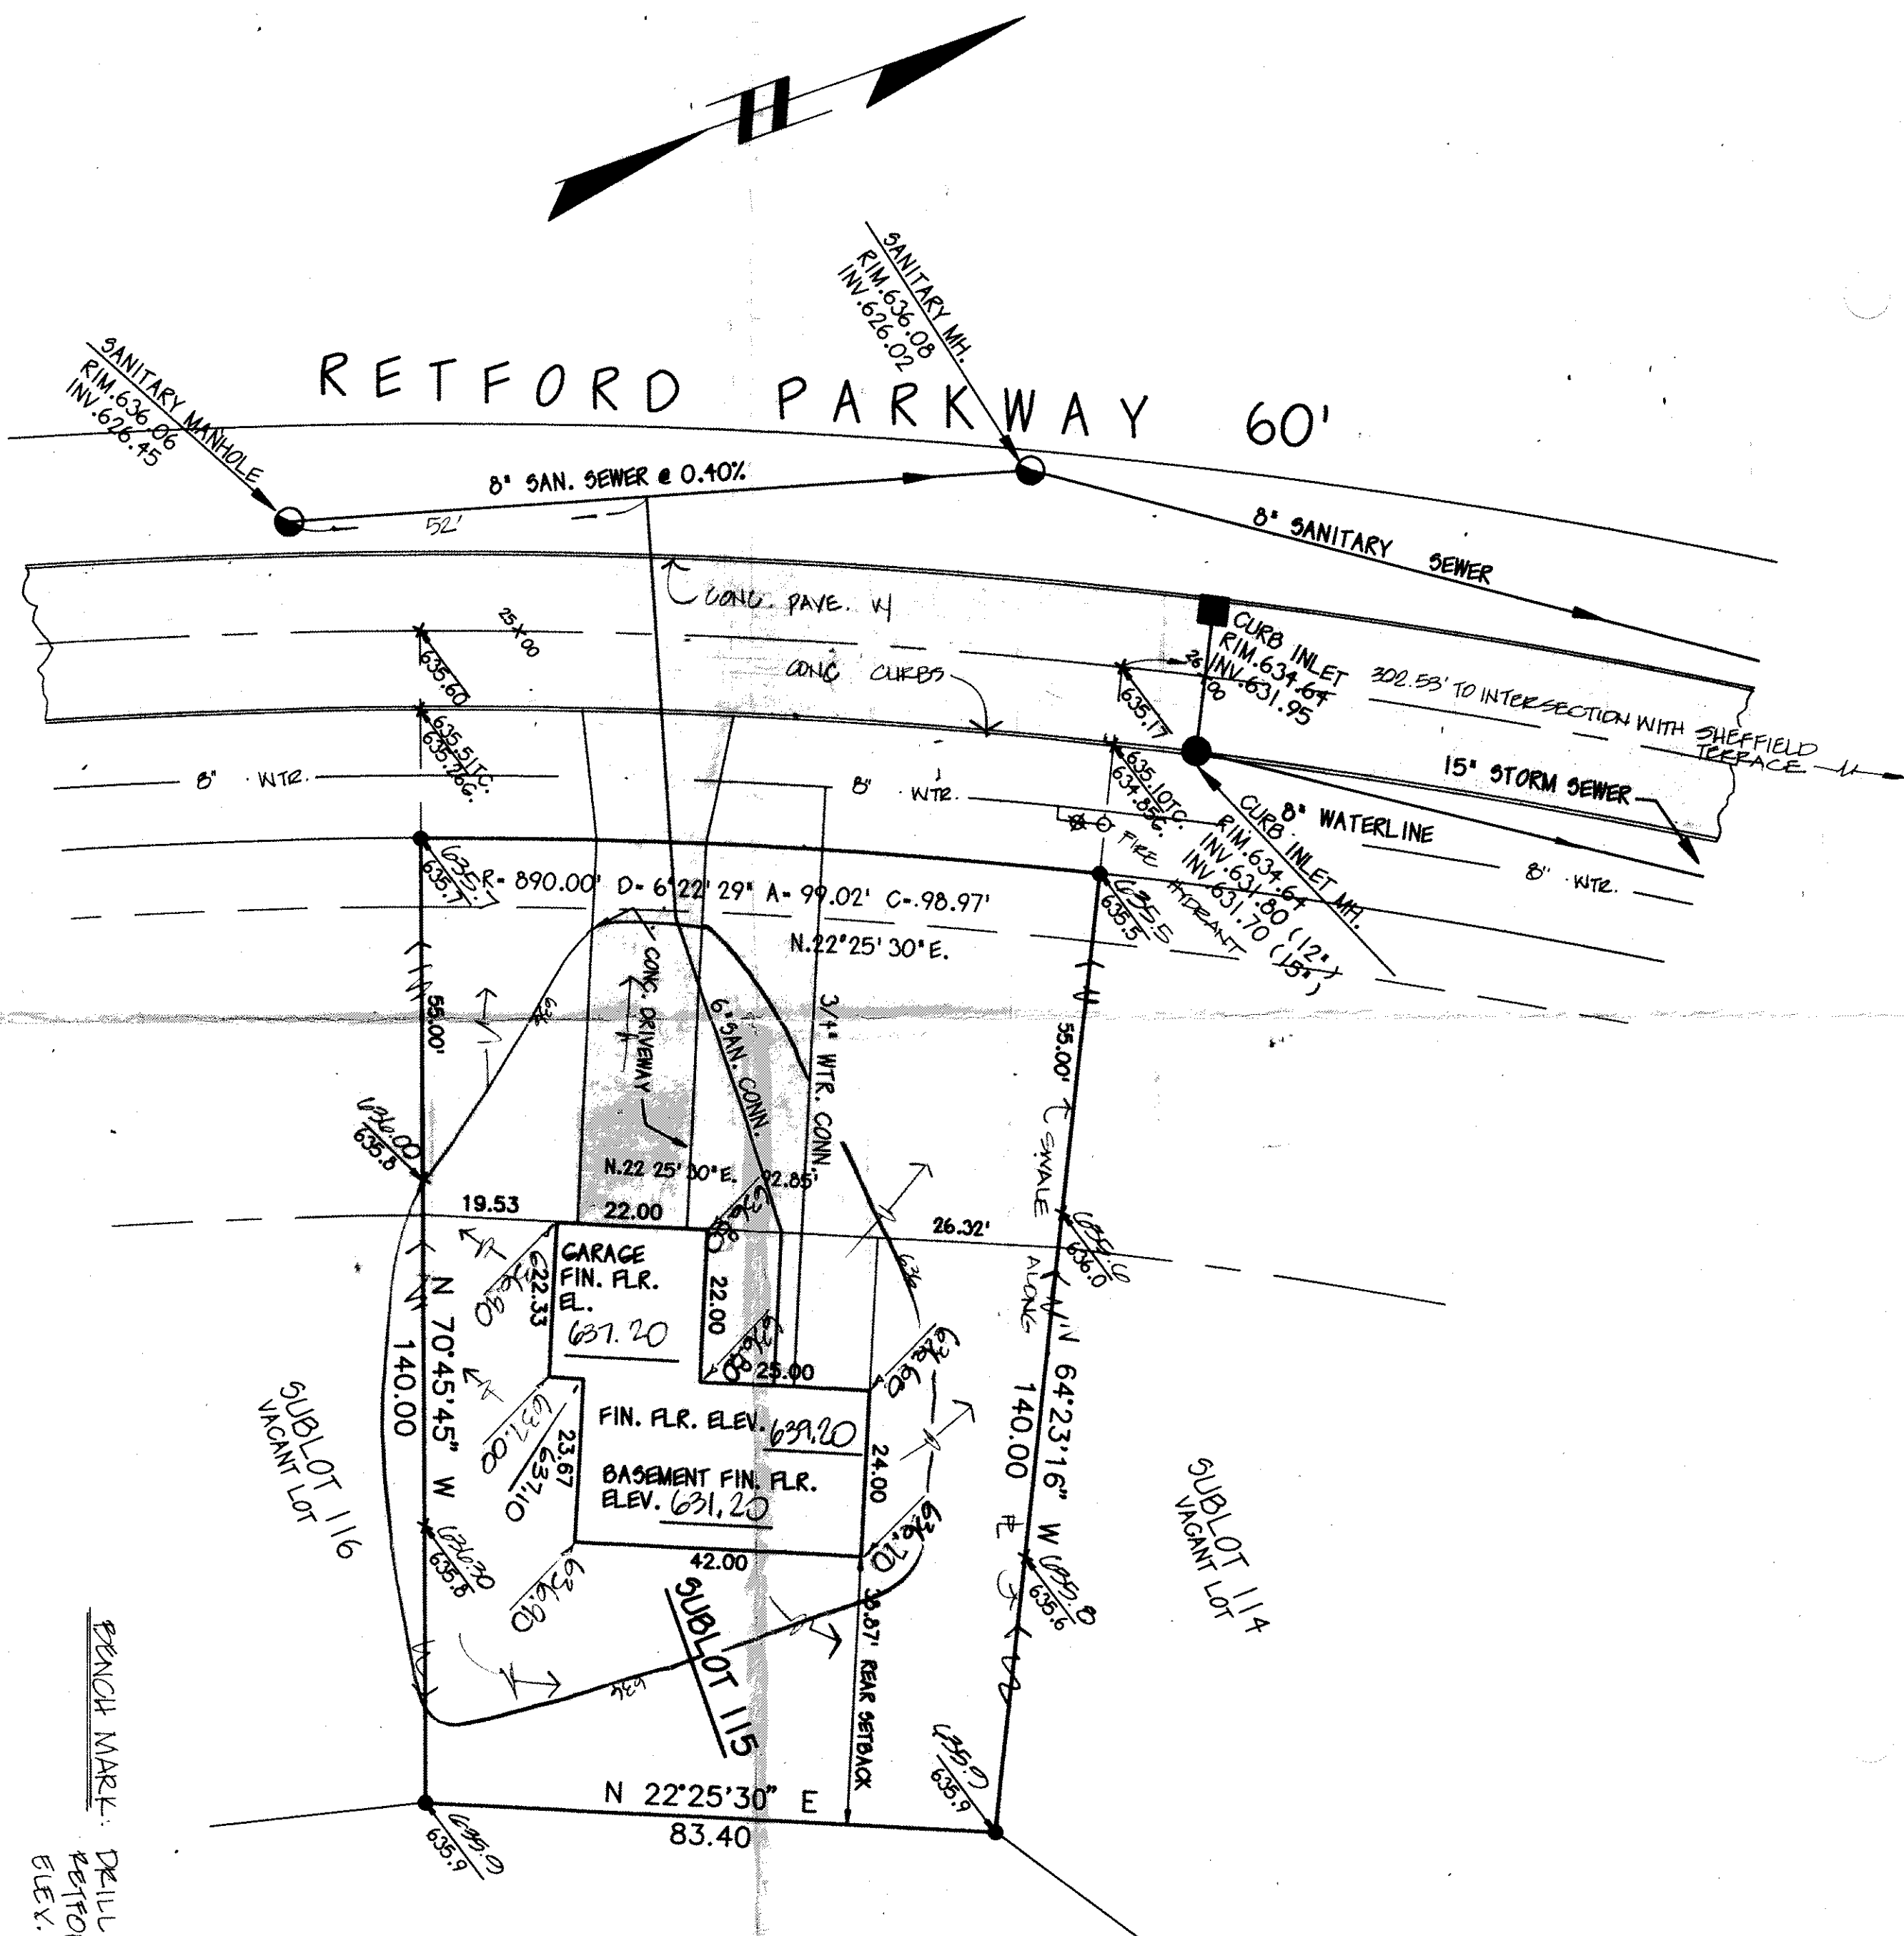

FRENCH MARK. DRILL HOLE AT INTERSECTION OF
WATFORD PARKWAY & SHIFFIELD TERRACE
ELEV. 634.14

This Permit Expires
2/26/21
PAINESVILLE TOWNSHIP
ZONING APPROVED
7421
[Signature]
Zoning Inspector

G. Anthony J. Blazynski approved
 as a Senior Engineer or noted
TDMA 686, R. G. LILES, P.E.
 Late Computer Engineer
 by G. J. H. Date 3/1/90

SITE PLAN FOR: **EDWARD H. TRESCER, INC.**
 8100 DEERPOD BLVD. MENTOR, OHIO 44060
 BEING SUBLOT NO. 115 IN THE PLATS SURVEYED AND RECORDED IN THE TOWNSHIP OF
 PAINE & VILLAGE, CLEVELAND COUNTY, OHIO.

DATE	Feb. 19, 1940
SCALE	1" = 20'
DRAWN BY	

 **CT Consultants, Inc.**
 Engineers, Architects, Planners

SHEET **1** OF **1**