
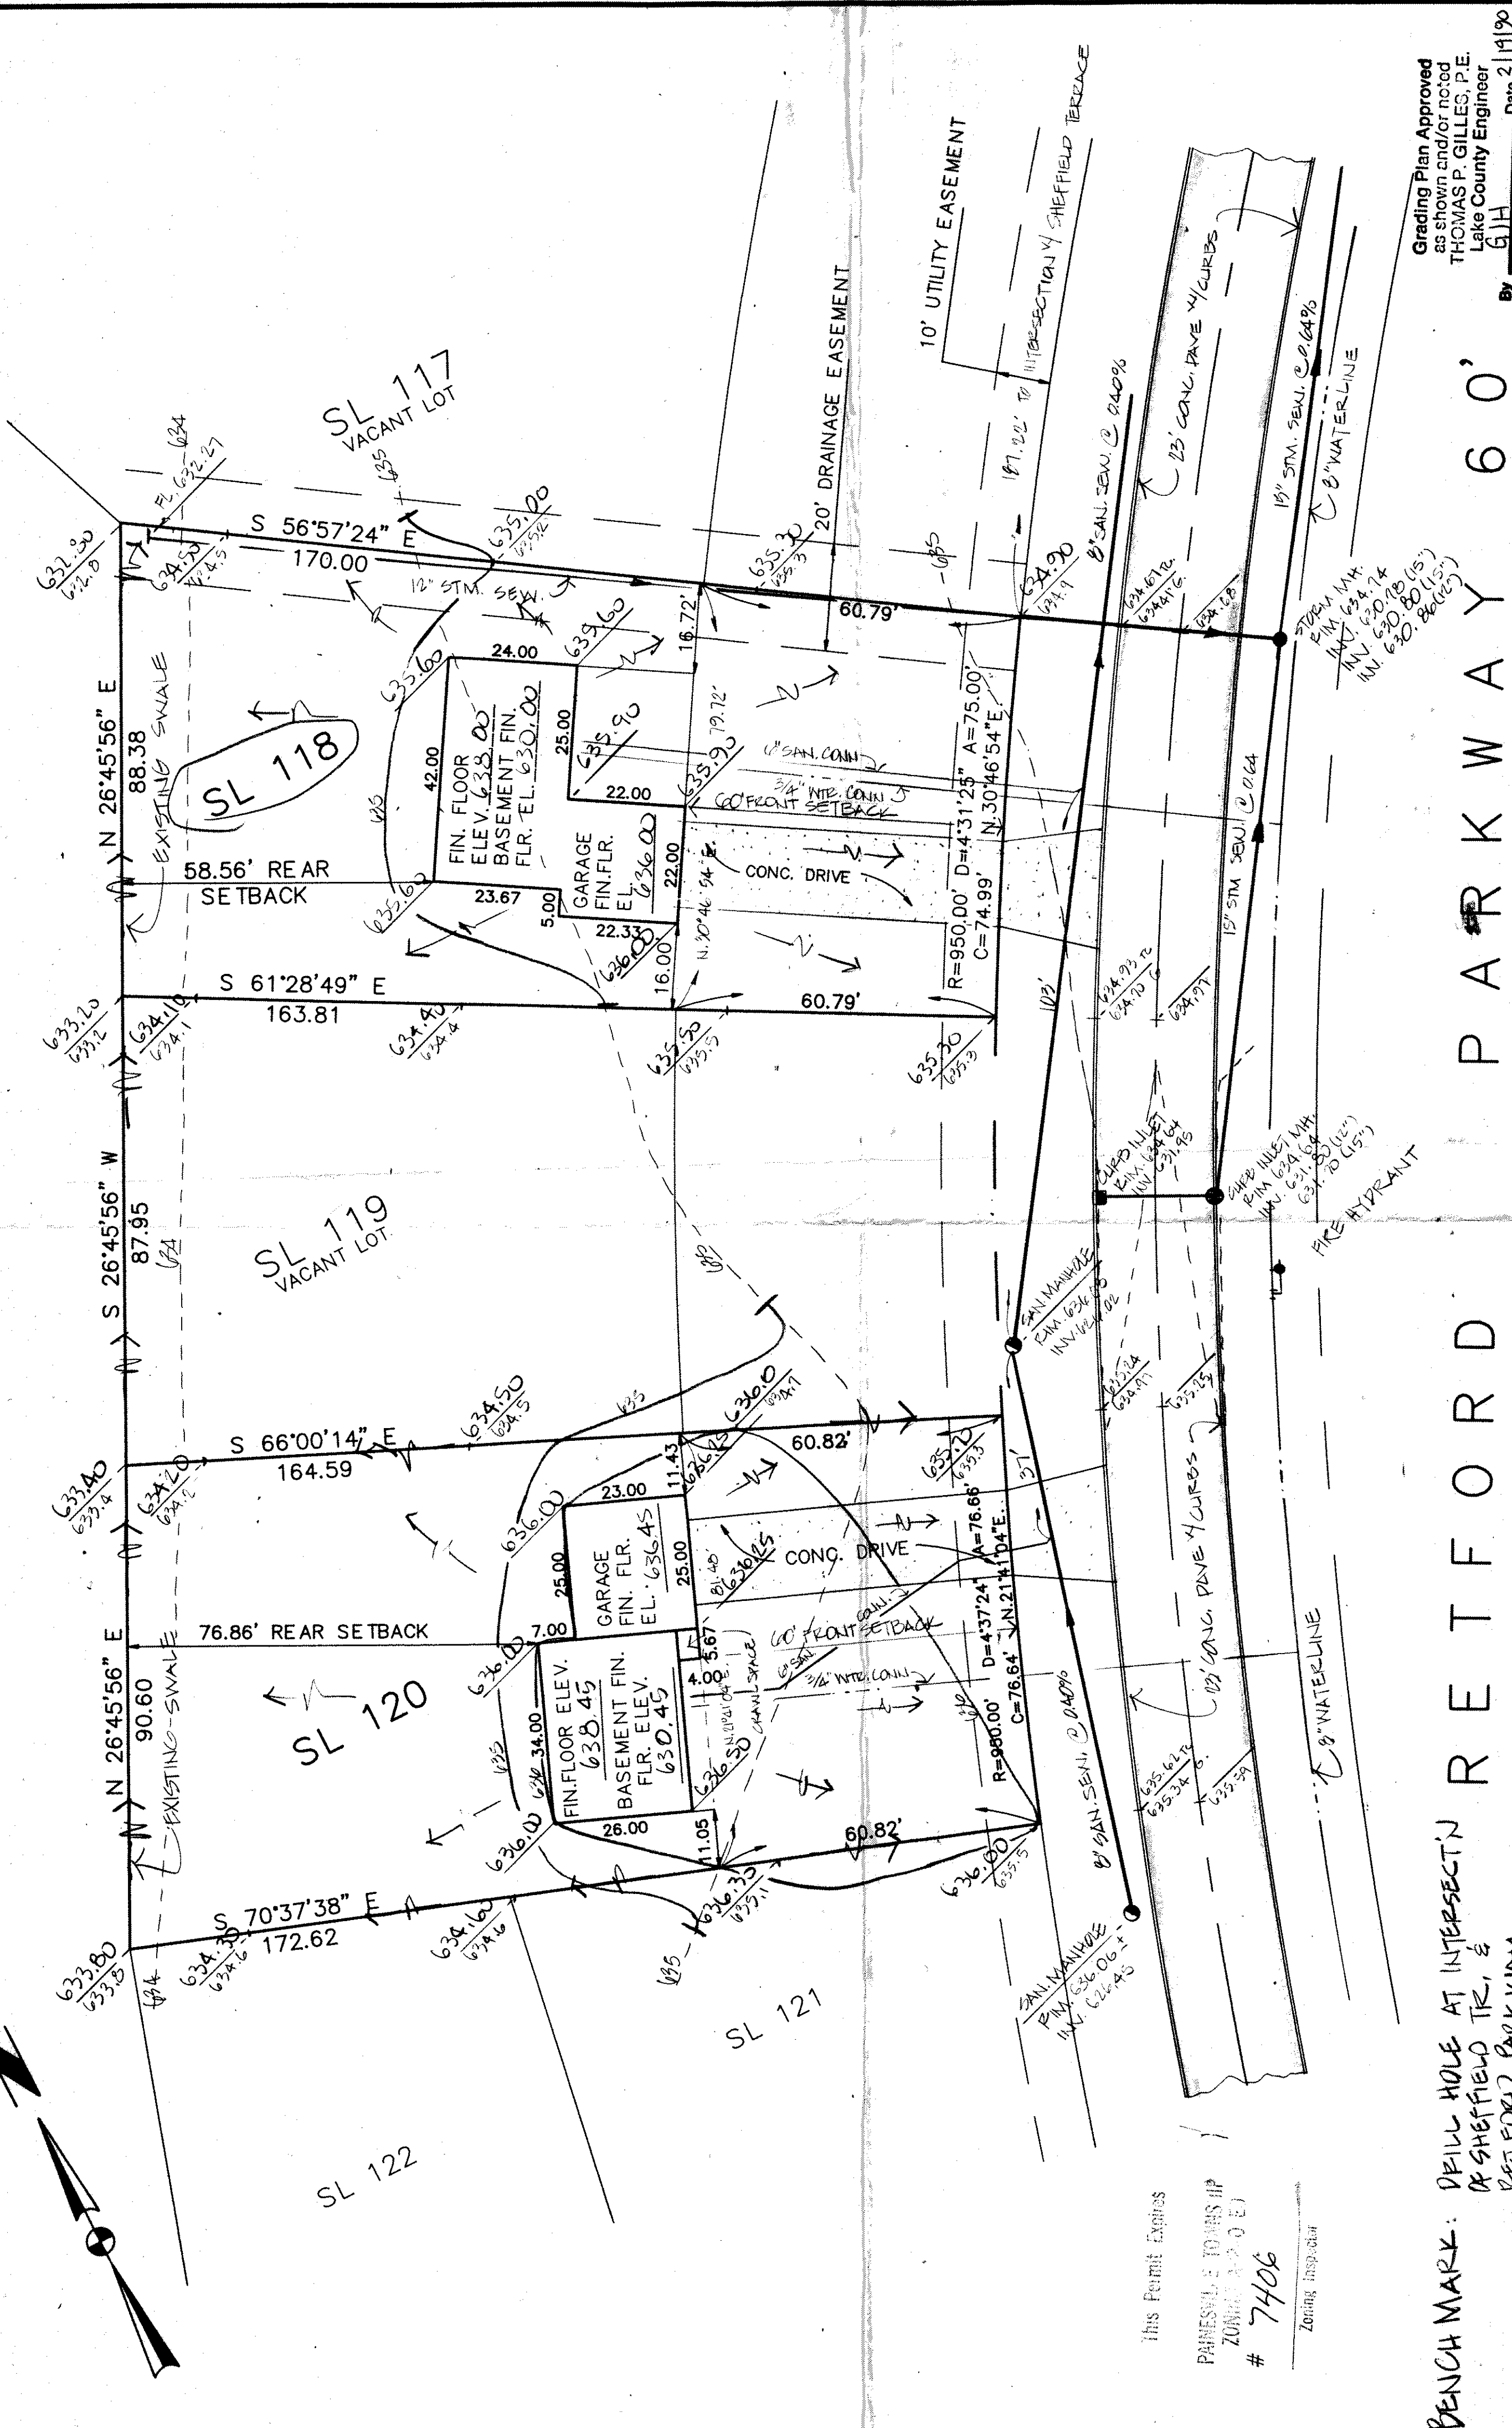


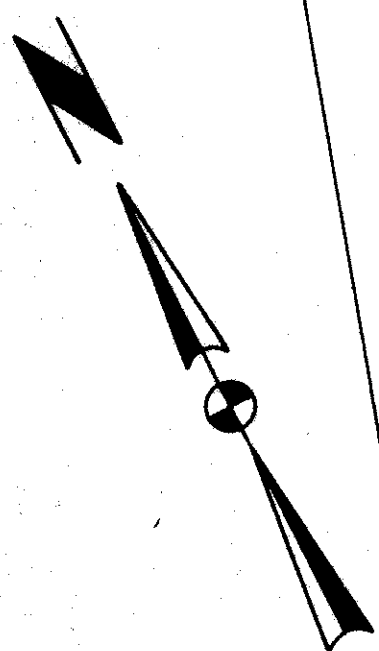


Grading Plan Approved
as shown and/or noted
THOMAS P. GILLES, P.E.
Lake County Engineer
By GH Date 2/1/90

P A R K W A Y 6 0'

R E T F O R D

BENCH MARK: DEILL HOLE AT INTERSECT'N
OF SHEFFIELD TR., &
RET FORD PARKWAY
EL. 634.14

PROPOSED GRADES
EXISTING ELEVATIONS
EXISTING CONTOUR
PROPOSED CONTOUR

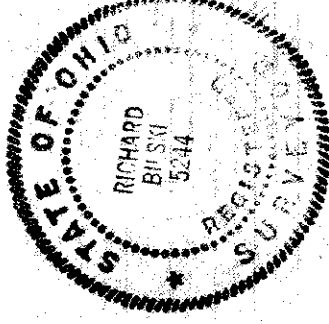

DESIGN CERTIFICATION:
I HEREBY CERTIFY THAT THIS PLAN WAS
PREPARED BY ME AND IS CORRECT TO
THE BEST OF MY KNOWLEDGE AND
BELIEF.
BY: Richard J. Bilsel
RICHARD J. BILSEL, P.E. NO. 5244

SITE PLAN FOR: **EDWARD H. TRESGER, INC.**
2100 DEERWOOD BLVD., MENTOR, OHIO 44060
DEVELOPMENT OF LOTS 118 AND 119 IN THE PINE SUBDIVISION PHASE III-B
IN PAINESVILLE TOWNSHIP, LAKE COUNTY, OHIO.

CT Consultants, Inc.
Engineers • Architects • Planners

DATE: Feb 1, 1990
SCALE: 1" = 50'
DRAWN BY: GH
CHECKED BY: GH

SHEET 1 OF 1
CONTRACT NO. 88-178