


SITE PLAN

PAINESVILLE TOWNSHIP LAKE COUNTY, OHIO

For: Jeff Orazz CLIENT Paul Williams
32 Sycamore Dr Painesville 44072
ADDRESS CITY STATE

Richard Part of W.G. McCall Subd
SUBDIVISION N-73 NAME
VOL. RICHMOND RD. STREET
SUBLOT NO. LOT 19 TRACT 4
VOLUME PAGE
PERM. PARCEL NO. STREET

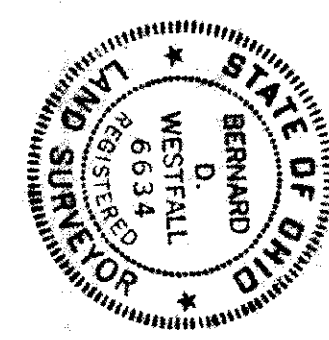

Grading Plan Approved
as shown and/or noted
by P. WILLIAMS, P.E.
Lake County Engineer



LEGEND	
WATER VALVE (GAS)	---
WATER METER (GAS)	---
AS BUILT ELEVATION	---
INDICATES DIRECTION OF SURFACE DRAINAGE	---


REMARKS
ALL BOUNDARY DATA SHOWN WAS OBTAINED FROM IDEEDS, RECORDED
SUBDIVISION PLAT OR OTHER PUBLIC RECORDS
LOCATIONS AS SHOWN OF ADJACENT WELLS AND SEPTIC TANKS OBTAINED FROM
LAKE COUNTY HEALTH DEPARTMENT

DESIGN CERTIFICATION
THIS PLAT WAS PREPARED BY ME, AND IS CORRECT
TO THE BEST OF MY KNOWLEDGE AND BELIEF.
Surveyor Registration No. 6637

CHECK LIST	
NO. OF BEDROOMS	WATER MAIN SIZE, LOCATION
SEWERAGE	SEWER SIZE, LOCATION
TIE TO NEAREST STREET	SAN. MH. CAST ELEV. INV. ELEV.
SUBLOT NO. PARCEL NO.	SAN. CONN. SIZE, LOC. DEPTH
SURROUNDING OWNERS	STORM MH. CAST ELEV. INV. ELEV.
BLDG. DIMENSIONS, FIN. GR.	PAYT. TYPE GRADE CURBS
BLDG. TIE TO GRADES	ADJUST. TYPE WIDTH THICKNESS
SEWERAGE TYPE WITH THICKNESS	SEPTIC TANK LOCATION & DUPPLICATION AREA
CULVERT TYPE DIA. LENGTH	WELL LOCATION
ROCK OUTCROPPINGS	ISOLATION RADIUS FROM WELL

REVISIONS	
NO.	DATE BY
1	
2	
3	
4	
5	

"AS BUILT" CERTIFICATION
I, HEREBY CERTIFY THAT THE CIRCLED GRADES ARE EXISTING
FINISH GRADES CHECKED IN THE FIELD ON 19
AND ARE CORRECT TO THE BEST OF MY KNOWLEDGE AND BELIEF.
REGISTERED SURVEYOR REG. NO.

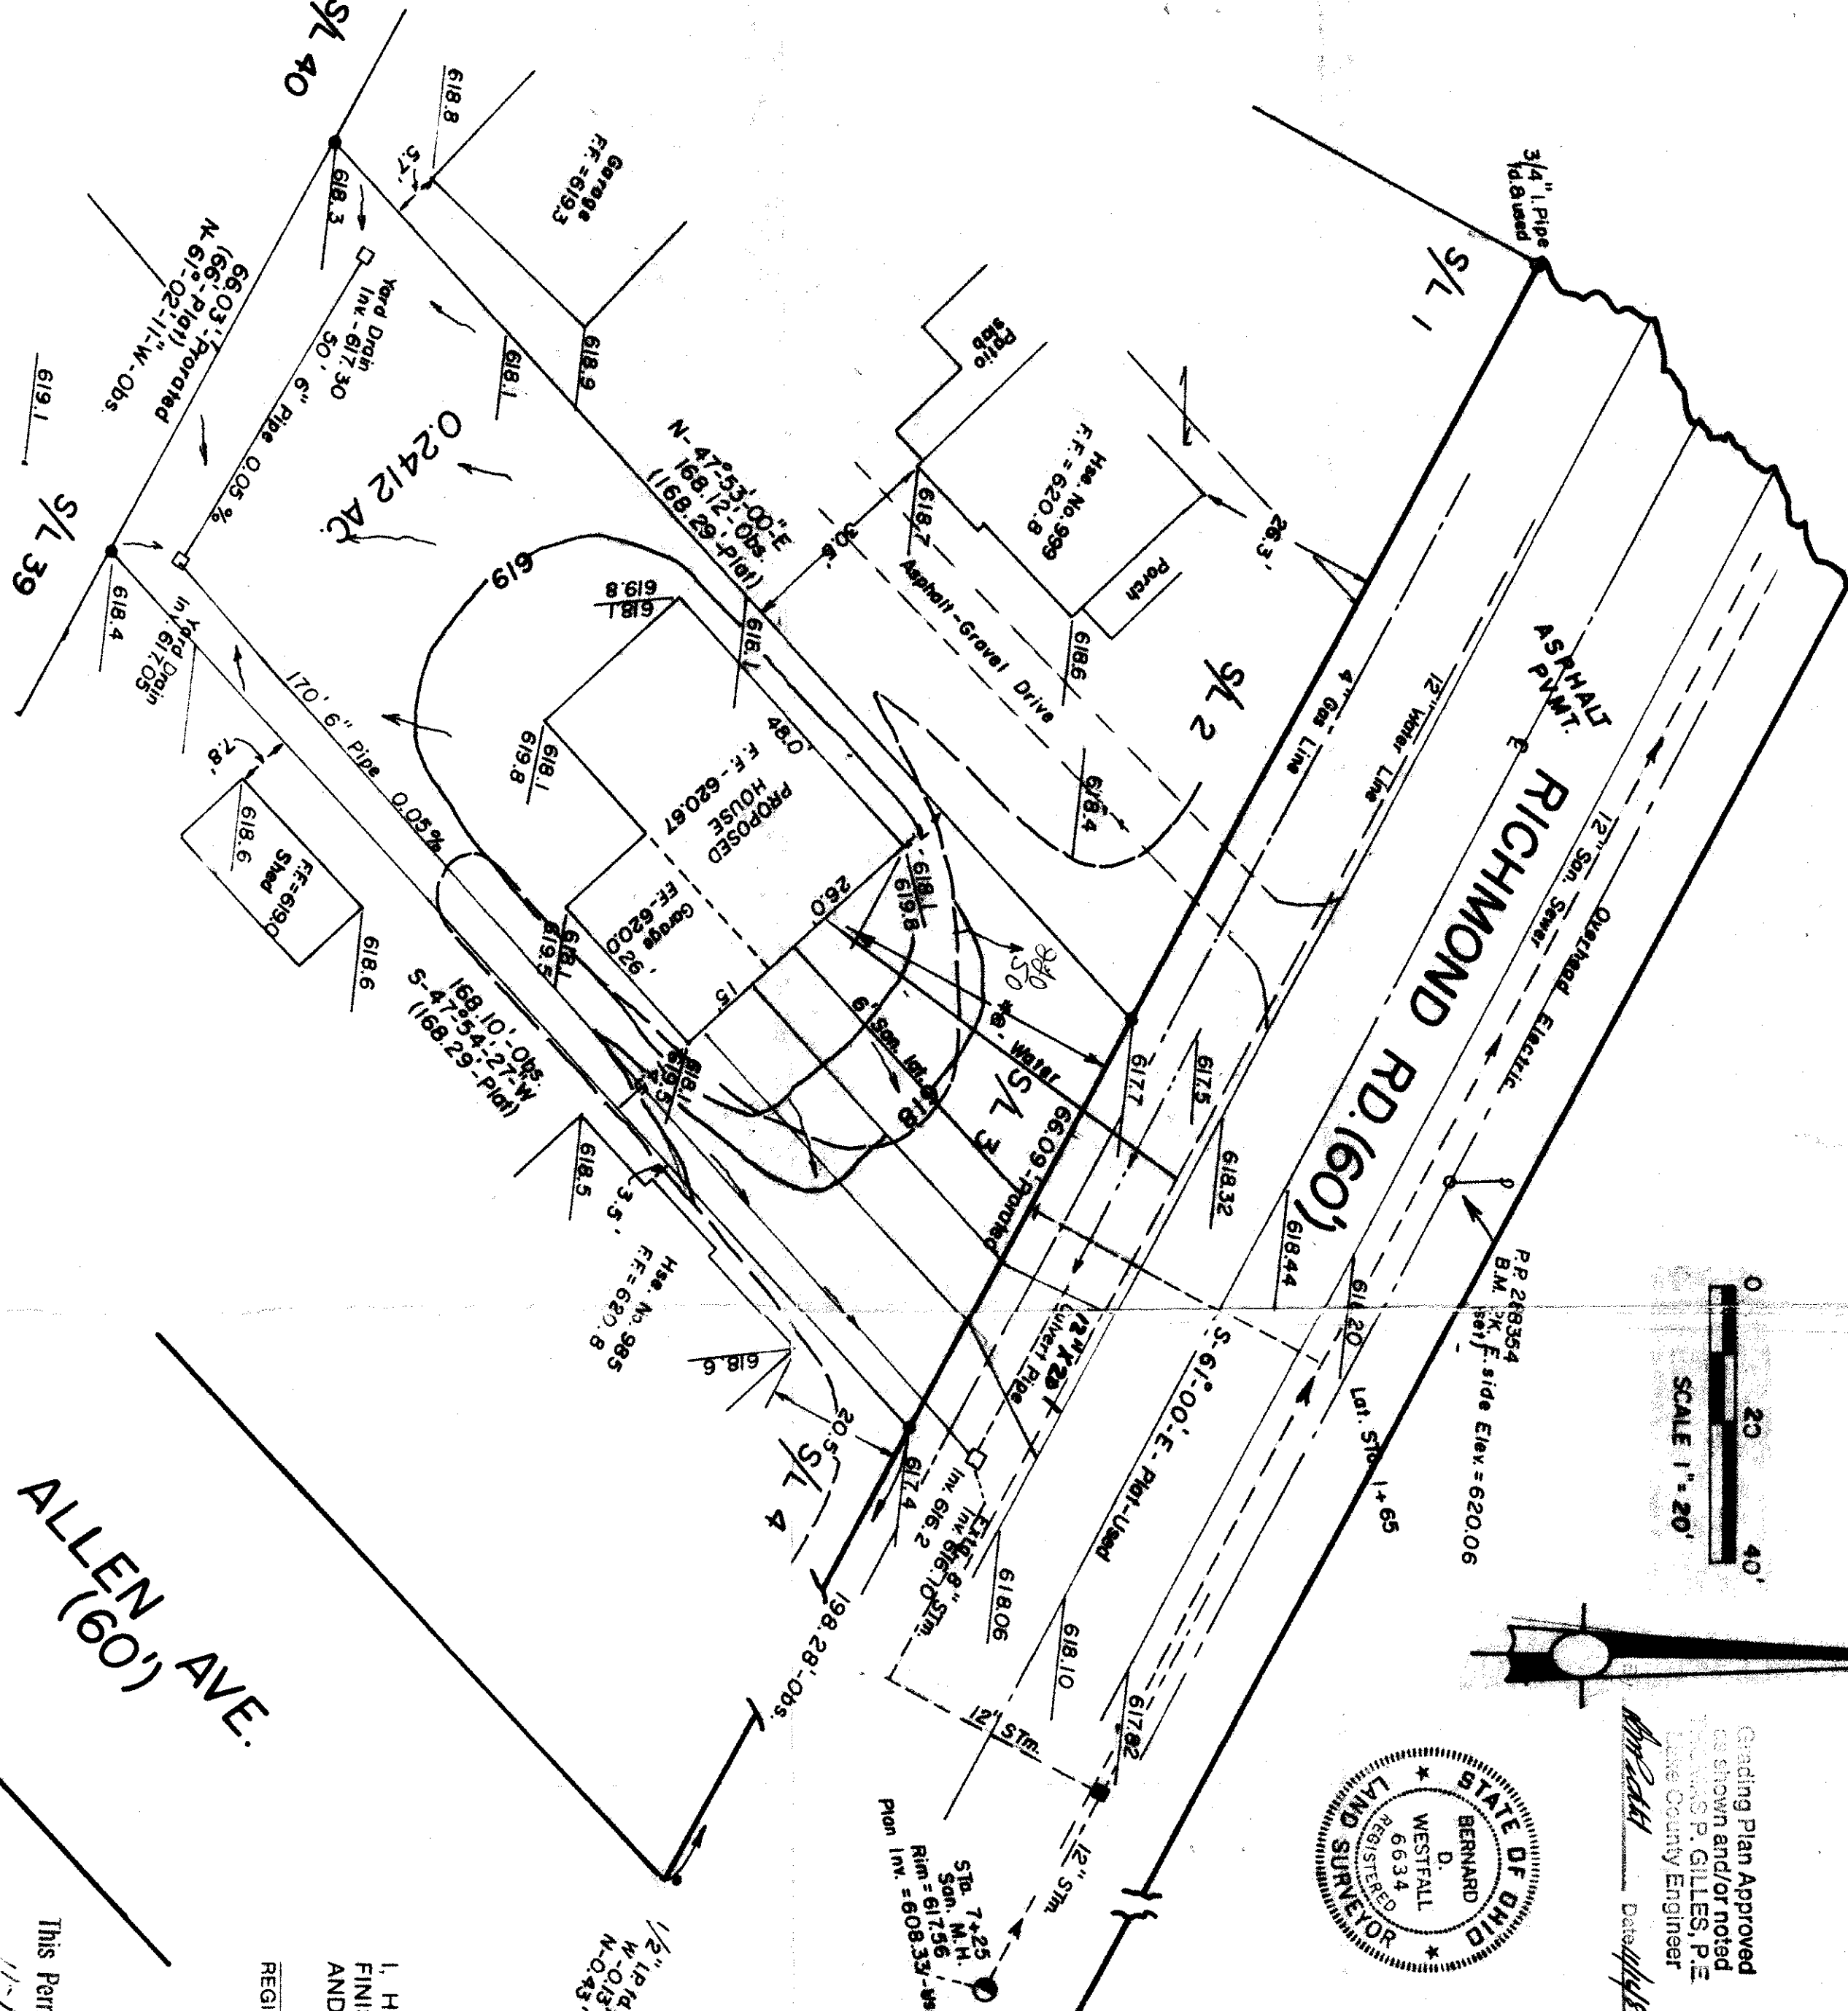

ALLEN (60') AVE.

This Permit Expires
11-14-89
PAINESVILLE TOWNSHIP
ZONING APPROVED
7120

William E. McCall
Zoning Inspector 11/14/88

168
50
118
48
1040
70